


REVISION May 10, 1932
Cement Rubble Masonry Retaining Wall
added to plans, Sta 396+00 - 397+20 LT.

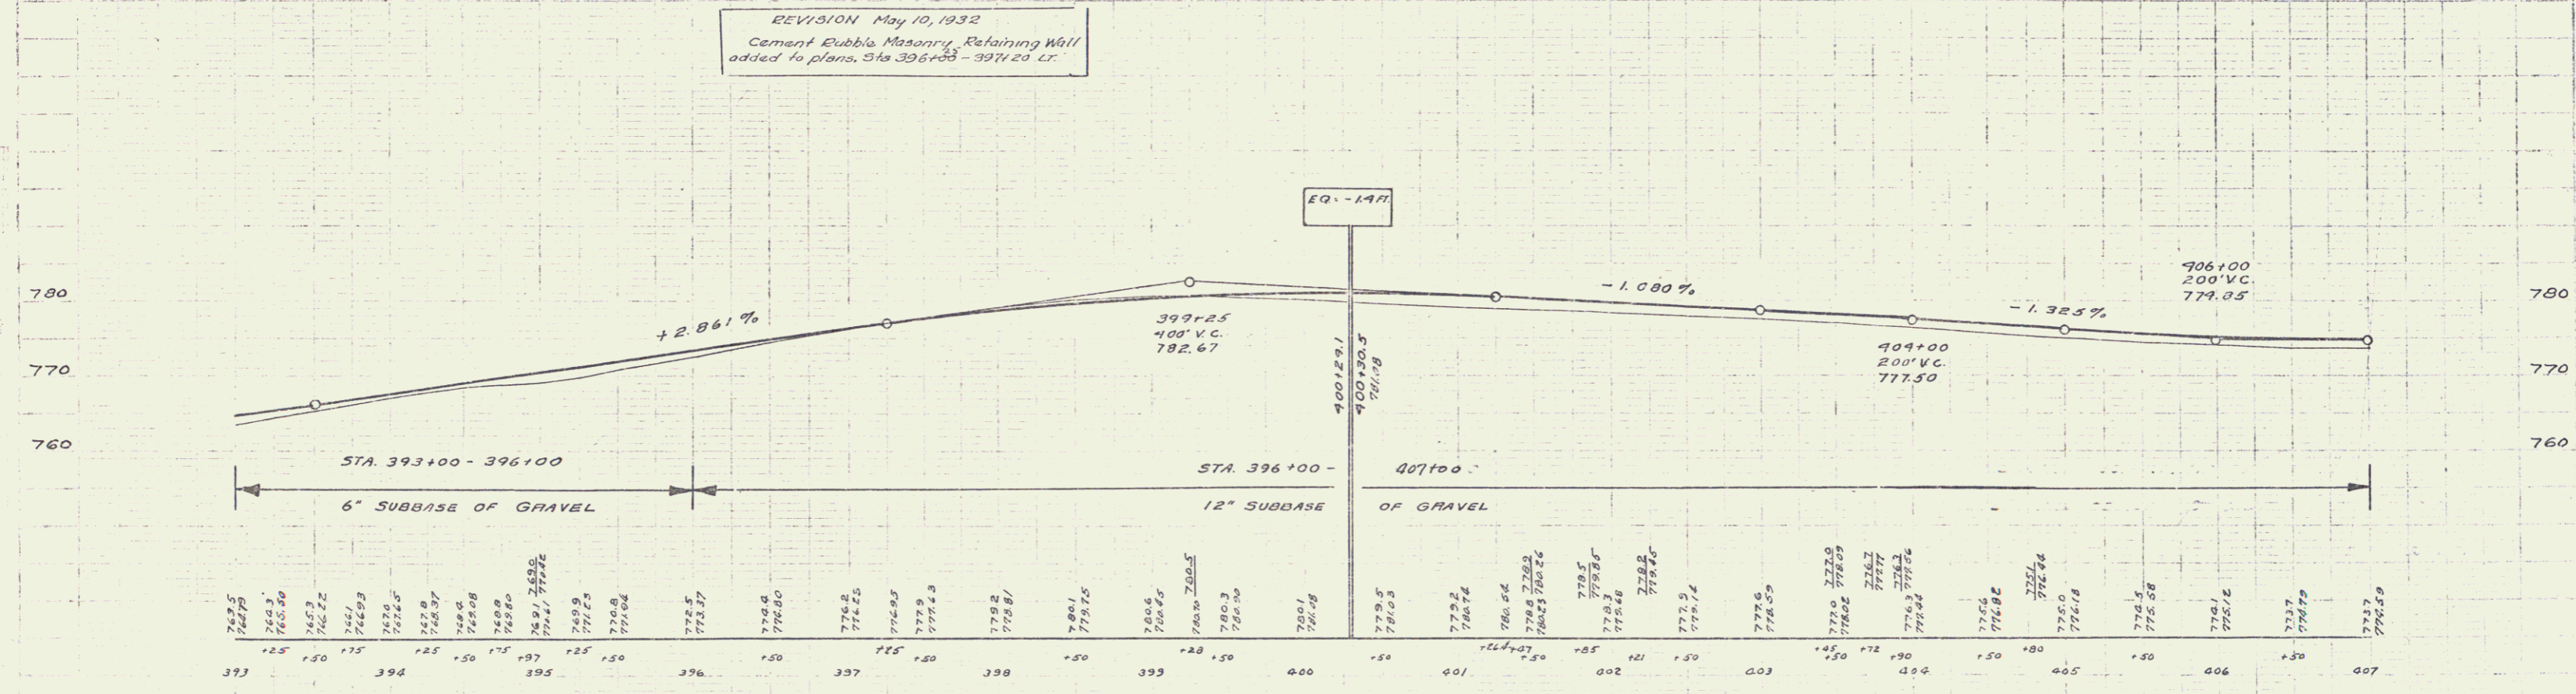

B.M. 44 PAINT SPOT ON CONC. H.W. 23 FT. LT. STA. 394+03 ELEV. 770.00
B.M. 45 SPIKE IN ROOT 16\"/>