



GRAVITY CURB  
STATIONS CONC. A  
418+82-420+37 RT 264 C.Y.

97-E 1932 14 45

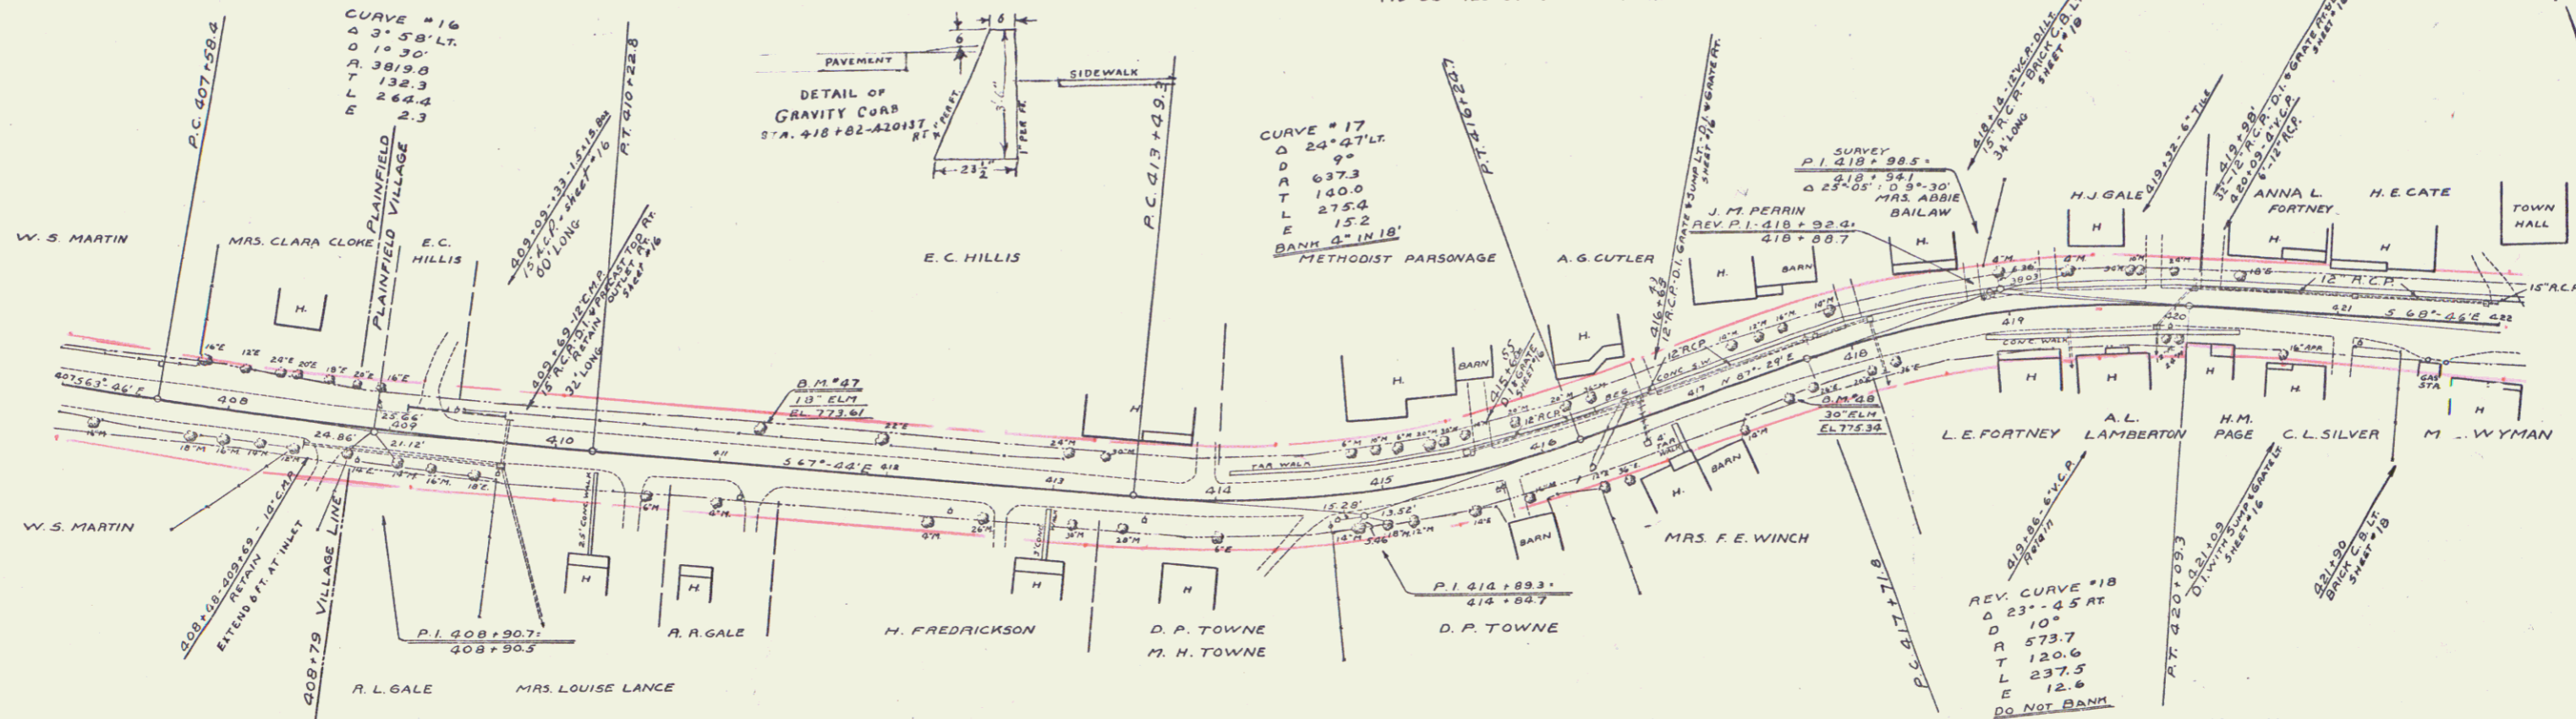

PARCEL	INSTRUMENT	DATE	GRANTOR	GRANTEE	RECORDED PLAINFIELD BOOK PAGE DATE	REMARKS
	W.D.O.E.	11-26-46	O.L. MARTIN	ST. OF VT.	18 470 12-5-46	EXT. OF PRES. CULV. OUTLET RT. 409+69

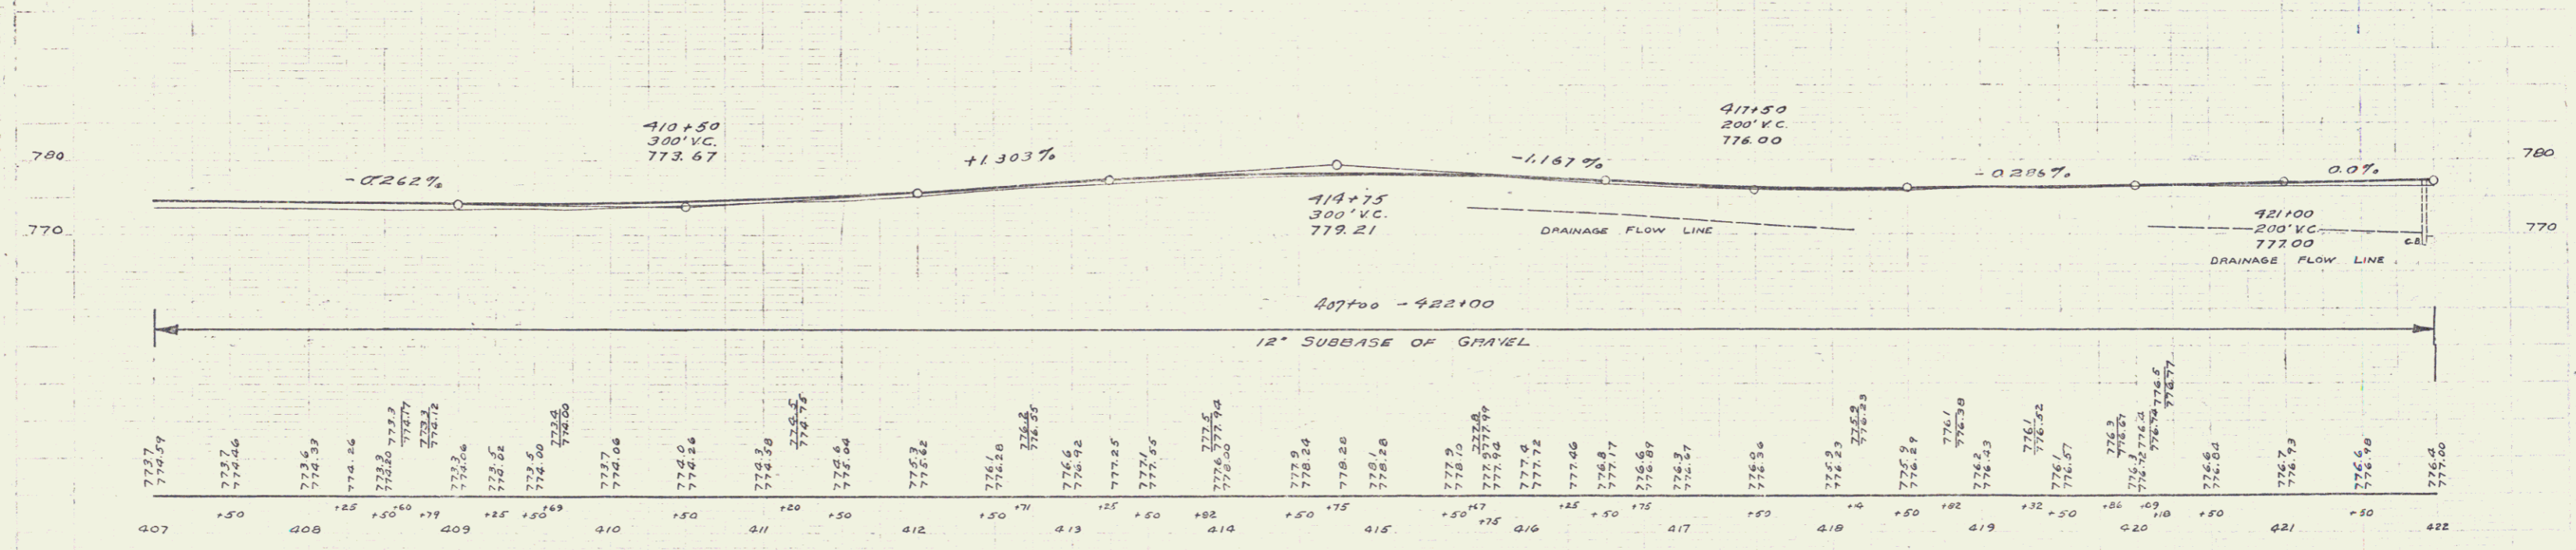

B.M. \*47 SPIKE IN ROOT 10' ELM 10.5 FT. LT. STA. 411+21 ELEV. 773.61  
B.M. \*48 SPIKE IN ROOT 30' ELM 15.0 FT. RT. STA. 417+55 ELEV. 775.38

SERIES F- No 97.E  
SHEET 14 OF 45