

WOOD GUARD RAIL REQUIRED

STA	LEFT	RIGHT
113+80	24'	

CABLE GUARD RAIL REQUIRED

STA	STA	Le O	LENGTH	CONCRETE	PIV LENGTH
113+52	114+56	12	102'	40'	144'

New Rein Concrete Pipe Culverts Required

Station	Length	Diam	Class A	Class B	Steel
113+80	36'	15"	1.9c.y.	1.5c.y.	32'



Driveway Pipe Culverts Required

Station	Diam	Length	Concrete	Public	Manhole
116+50	12"	28'	2.3 c.y.		

GRADED COBBLE GUTTER REQUIRED

Station	Length	Width	Slope
109+00-114+00	108'	3'-0"	34.84 yds.

STATE OF OHIO
 DIVISION OF HIGHWAYS
 PROJECT NO. 37-D-11
 SHEET NO. 11 OF 39

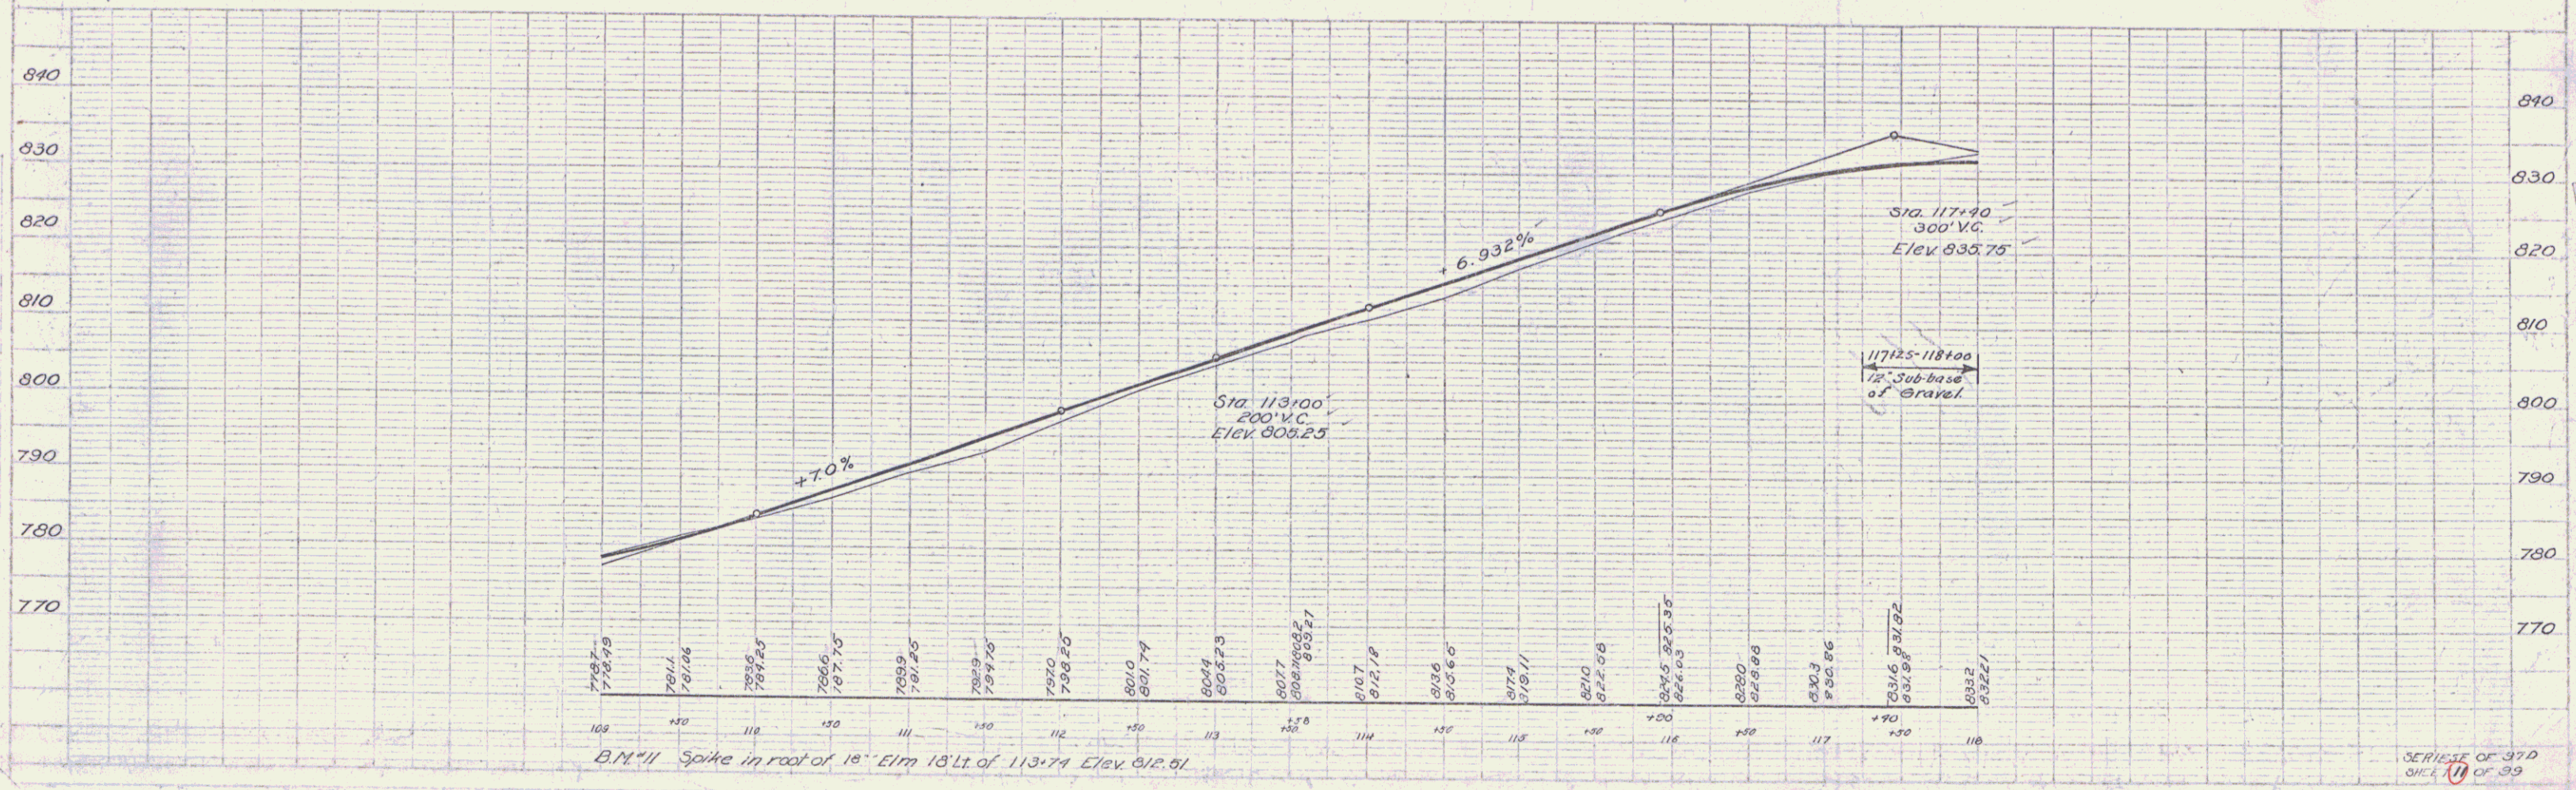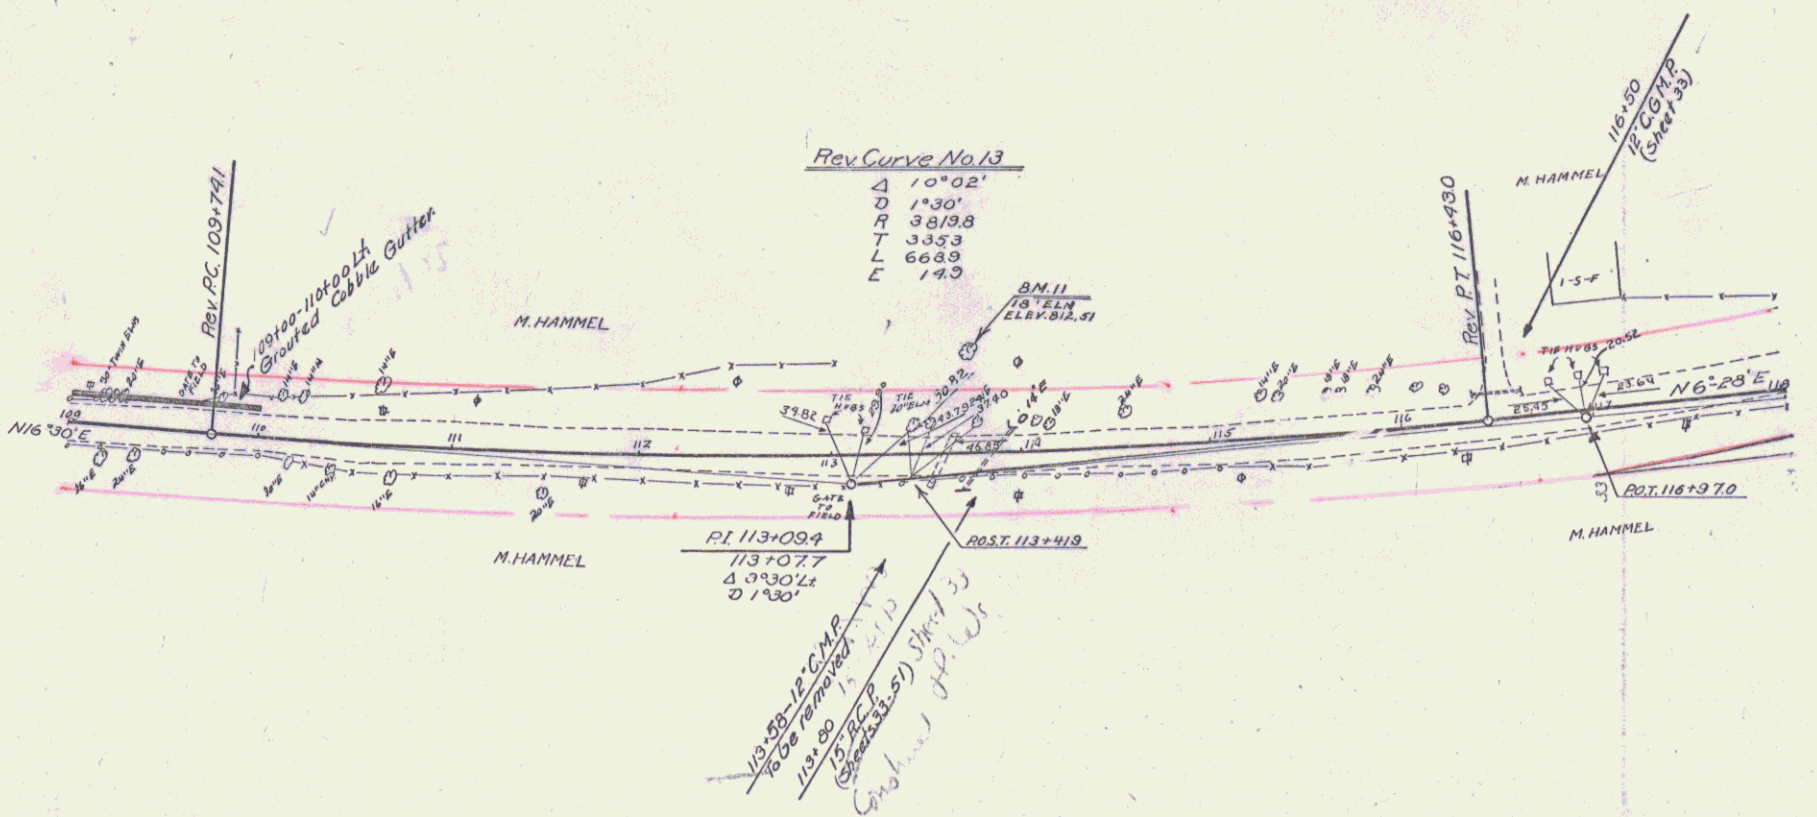

PLAN
 DATE: 10/1/39
 DRAWN BY: [Name]
 CHECKED BY: [Name]

PROFILE
 DATE: 10/1/39
 DRAWN BY: [Name]
 CHECKED BY: [Name]

SERIES OF 37-D
 SHEET 11 OF 39