
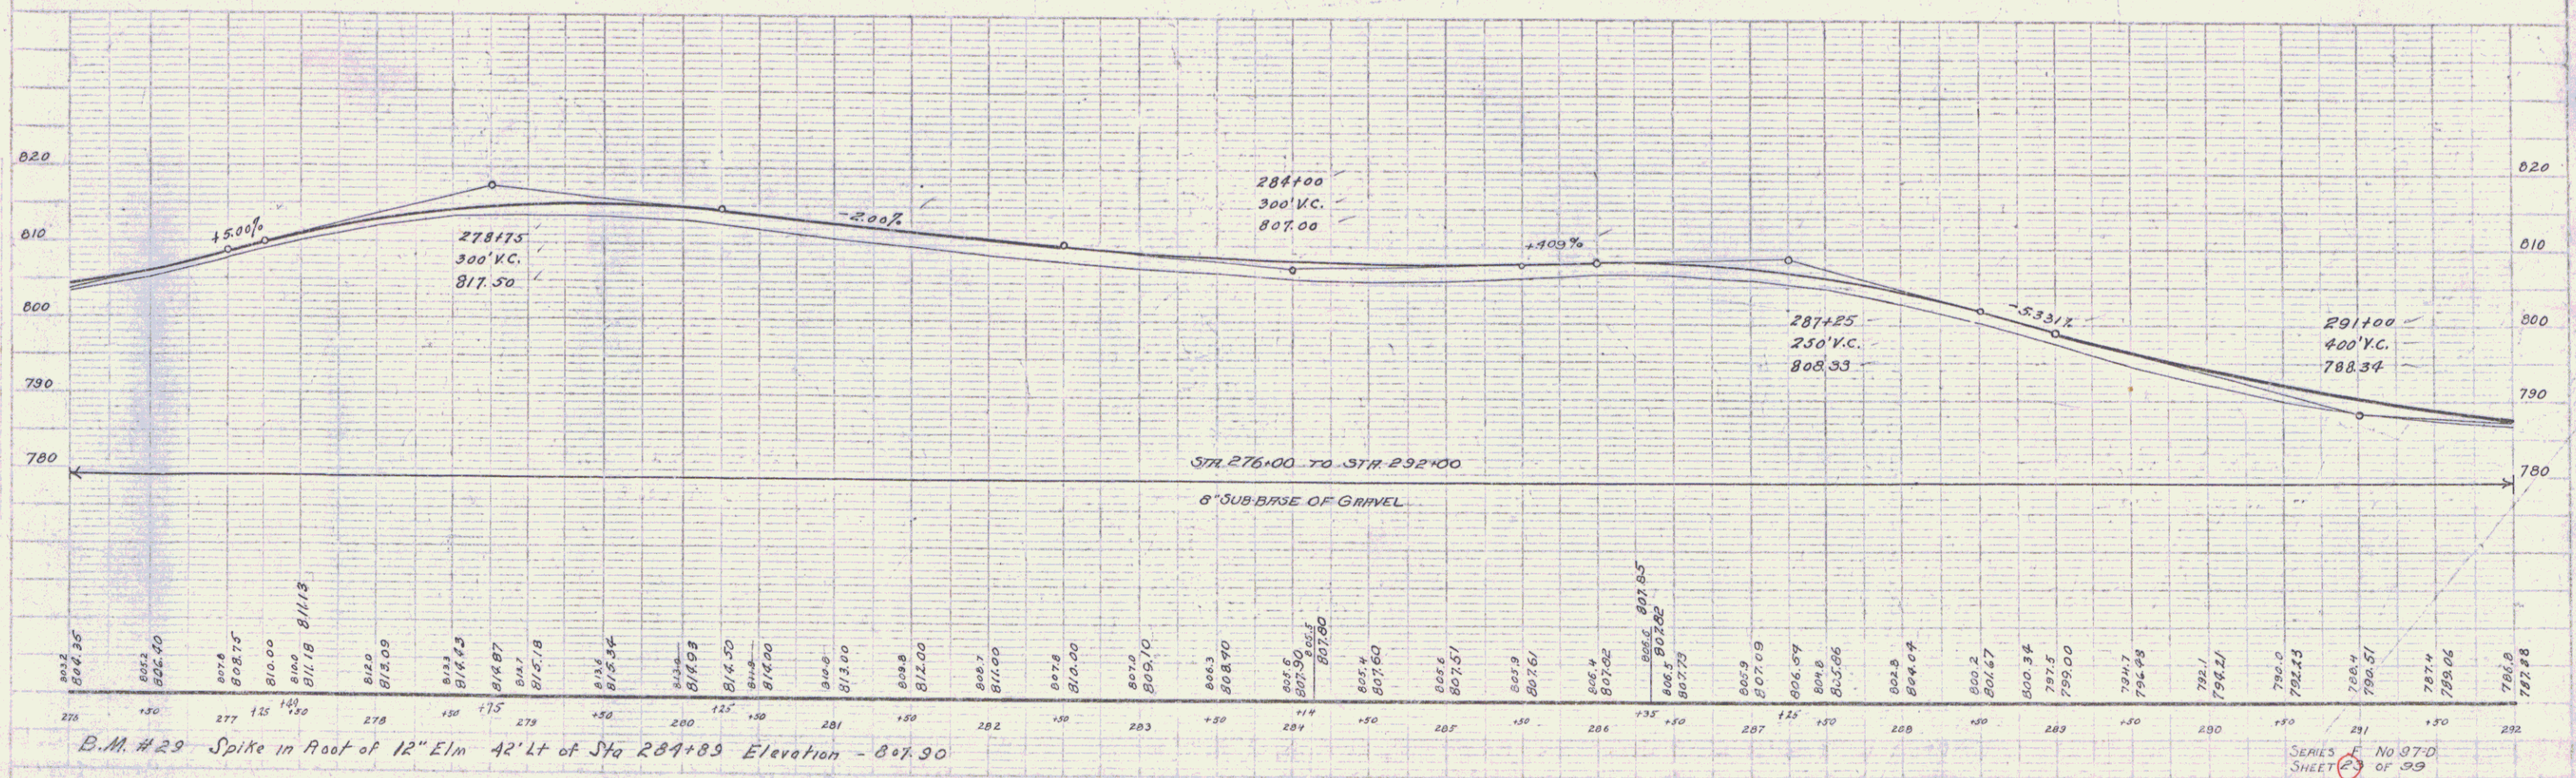


WOOD GUARD RAIL REQUIRED
 CULVERT STATION LEFT RIGHT
 284+14 24 24

New Paint Concrete Pipe Culverts Required
 Station Diag. Length Conc. II Sheet
 287+19 18' 40' 18cy 59'

97 D 1930 23 09

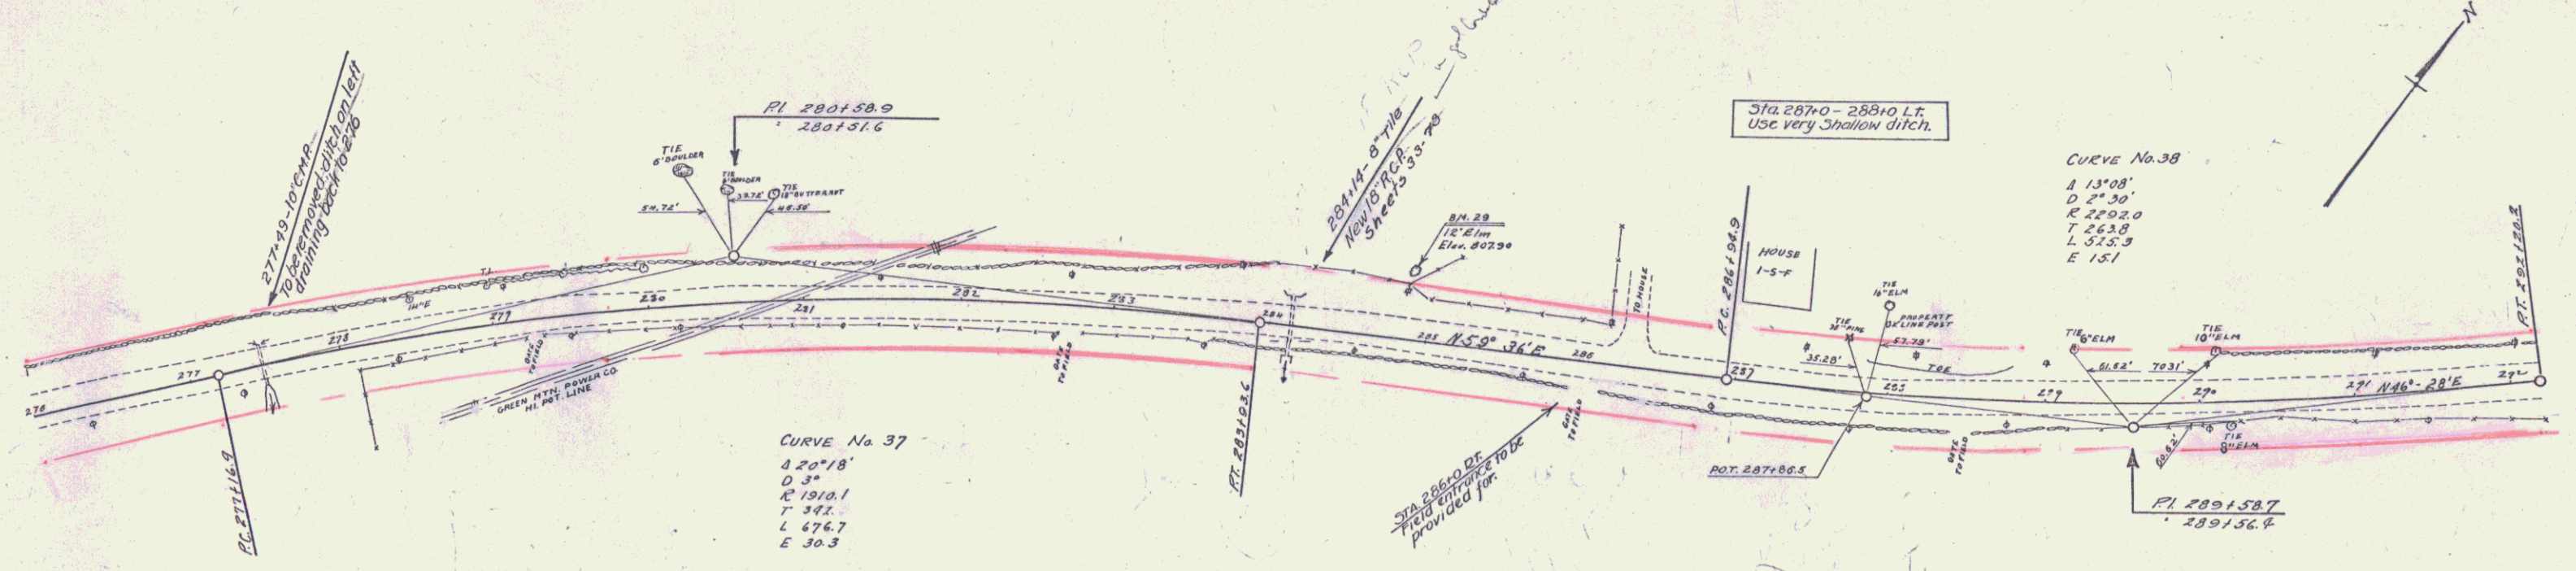

B.M. #29 Spike in Root of 12" Elm 42' Lt of Sta 289+89 Elevation - 807.30

SERIES NO 97 D OF 23