

WOOD GUARD RAIL REQUIRED

Station	Left	Right
296+00	24'	
298+87	24'	
301+17	24'	
302+44	24'	24'
303+85	24'	
296+00	24'	

CARL GUARD RAIL REQUIRED

Station	Station	Len	Const	Pay
29271	29285	14'	20'	44'
29271	29285	14'	20'	44'
293405	293425	20'	20'	44'
296+00	299+82	152'	40'	192'
303+60	306+00	140'	40'	280'

REIN. CONC. PIPE CULVERTS REQUIRED



Station	Diam.	Length	Conc. P.	Steel	Conc. C.
296100	18"	33'	1.864	54"	
298187	18"	36'	1.5	54"	
301117	18"	40'	1.8	54"	
302184	18"	36'		54"	300y.
303185	24"	44'	2.4	54"	
298+65	12"	96'	1.2	99"	1 D.I. GRATE.

STD. UNDERDRAIN WITH 6" PC.G.M.P.

Sta.	Length
293+65	294+50
	85'

WOOD GUIDE POSTS REQUIRED

Station	Left	Right
293+00	2	

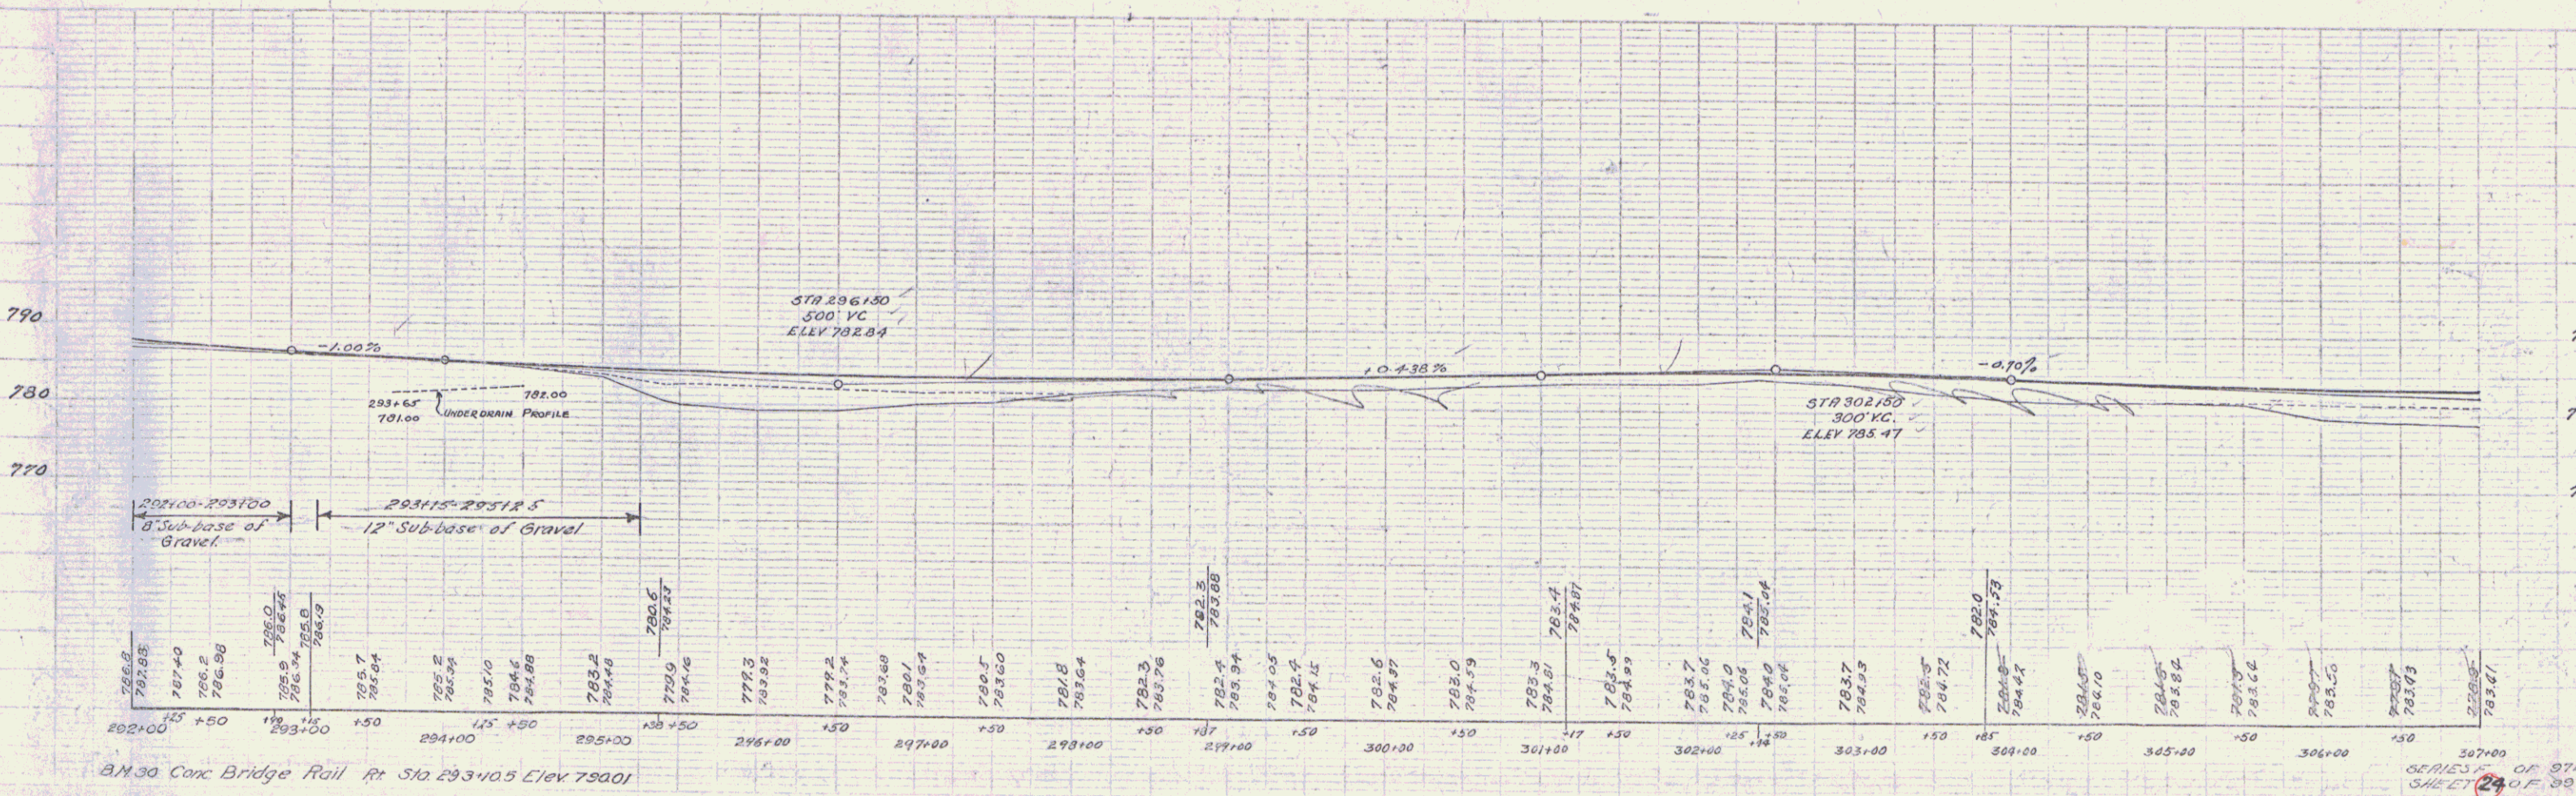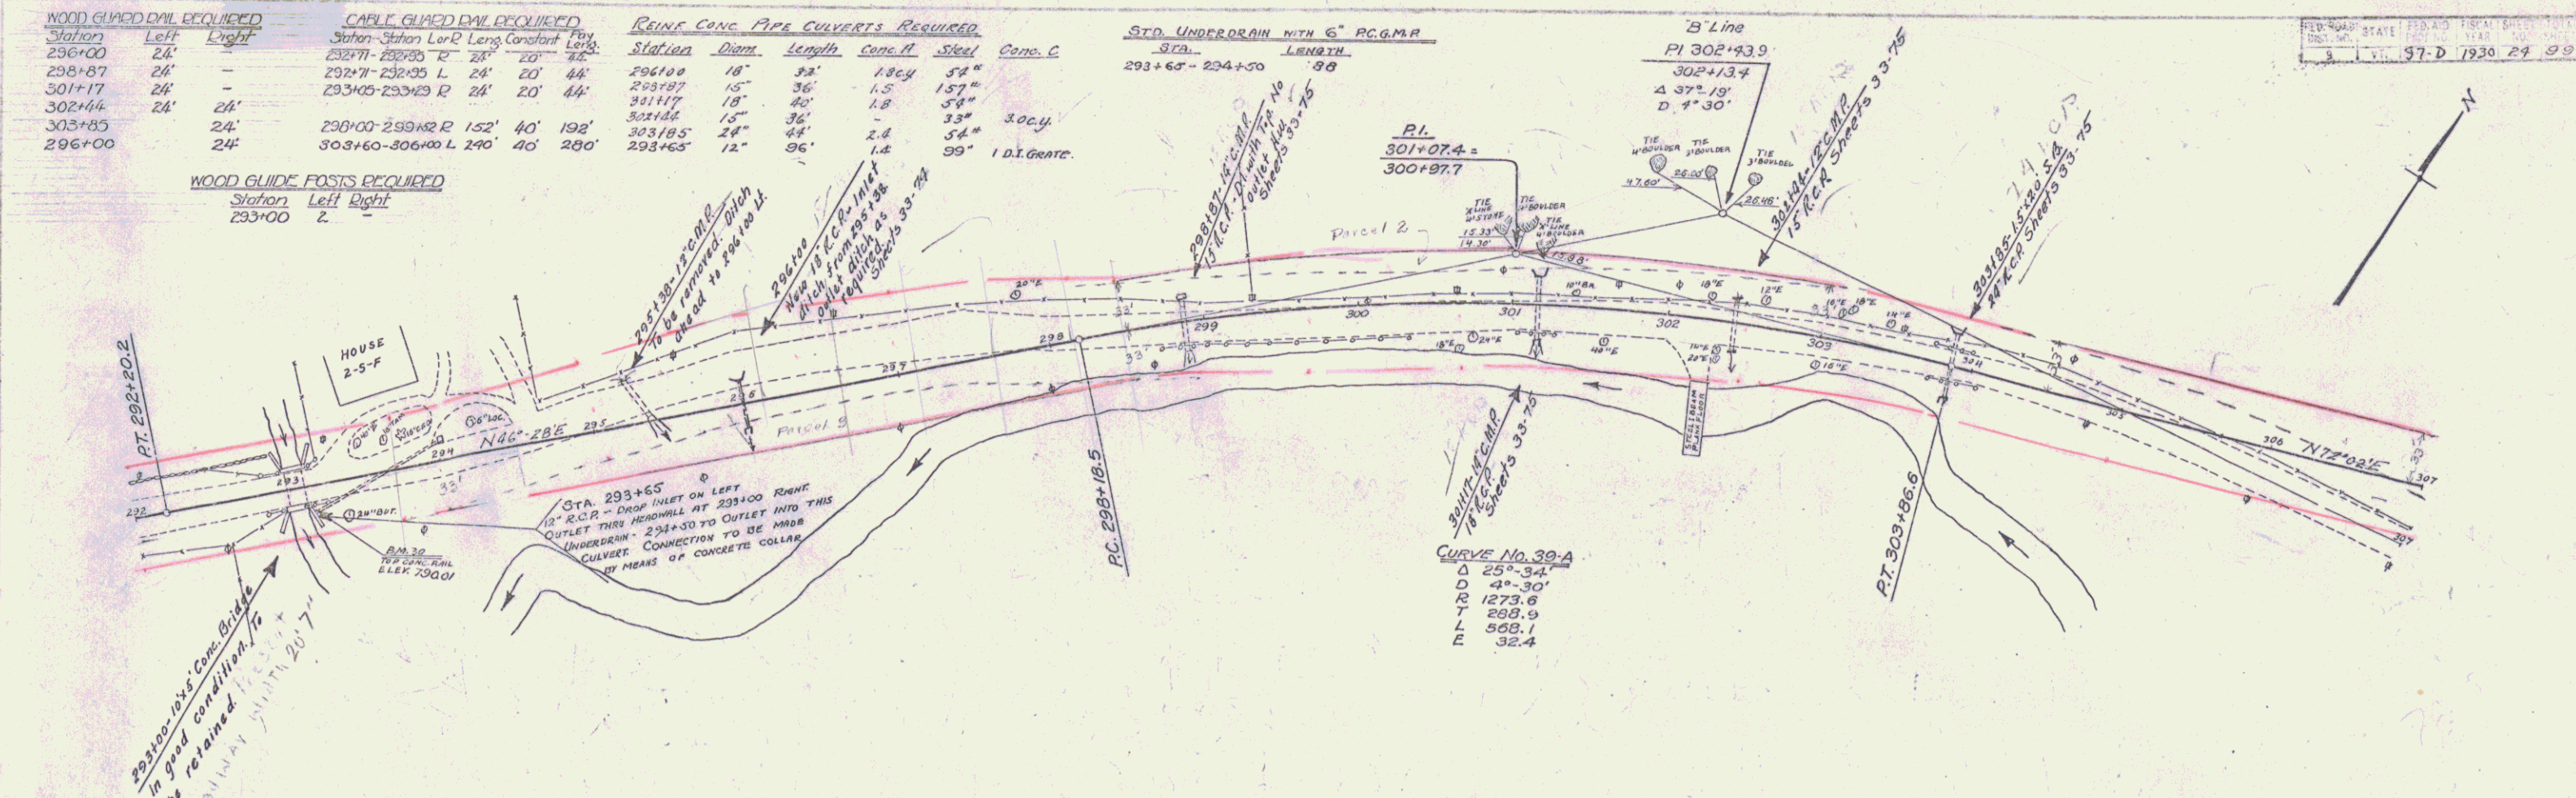

ASTHAN HANMAN

ASTHAN HANMAN

STATE ROAD DISTRICT NO. 1
 DIVISION OF HIGHWAYS
 L. V. 97-D 1930 24 99

SERIES OF 97D
 SHEET 24 OF 39