

WOOD GUANO CHAIN REQUIRED



CALCULATION	LEFT	RIGHT
308+50	24'	24'
312+00	24'	24'
313+00	24'	24'

CABLE GUANO CHAIN REQUIRED

STA	STA	L-R	LENGTH	CONSTANT	PIV. POINT
319.75	321+0	R	125'	20'	14.5'
319.75	321+0	L	125'	20'	14.5'

NEW BEING CONC PIPE CONCRETS REQUIRED

Station	Diam.	Length	CONC. R.	CONC. S.	STEEL
308+50	18"	56'	18cy	54'	
312+00	18"	36'	10	27'	
313+00	12"	36'	1.75	33'	

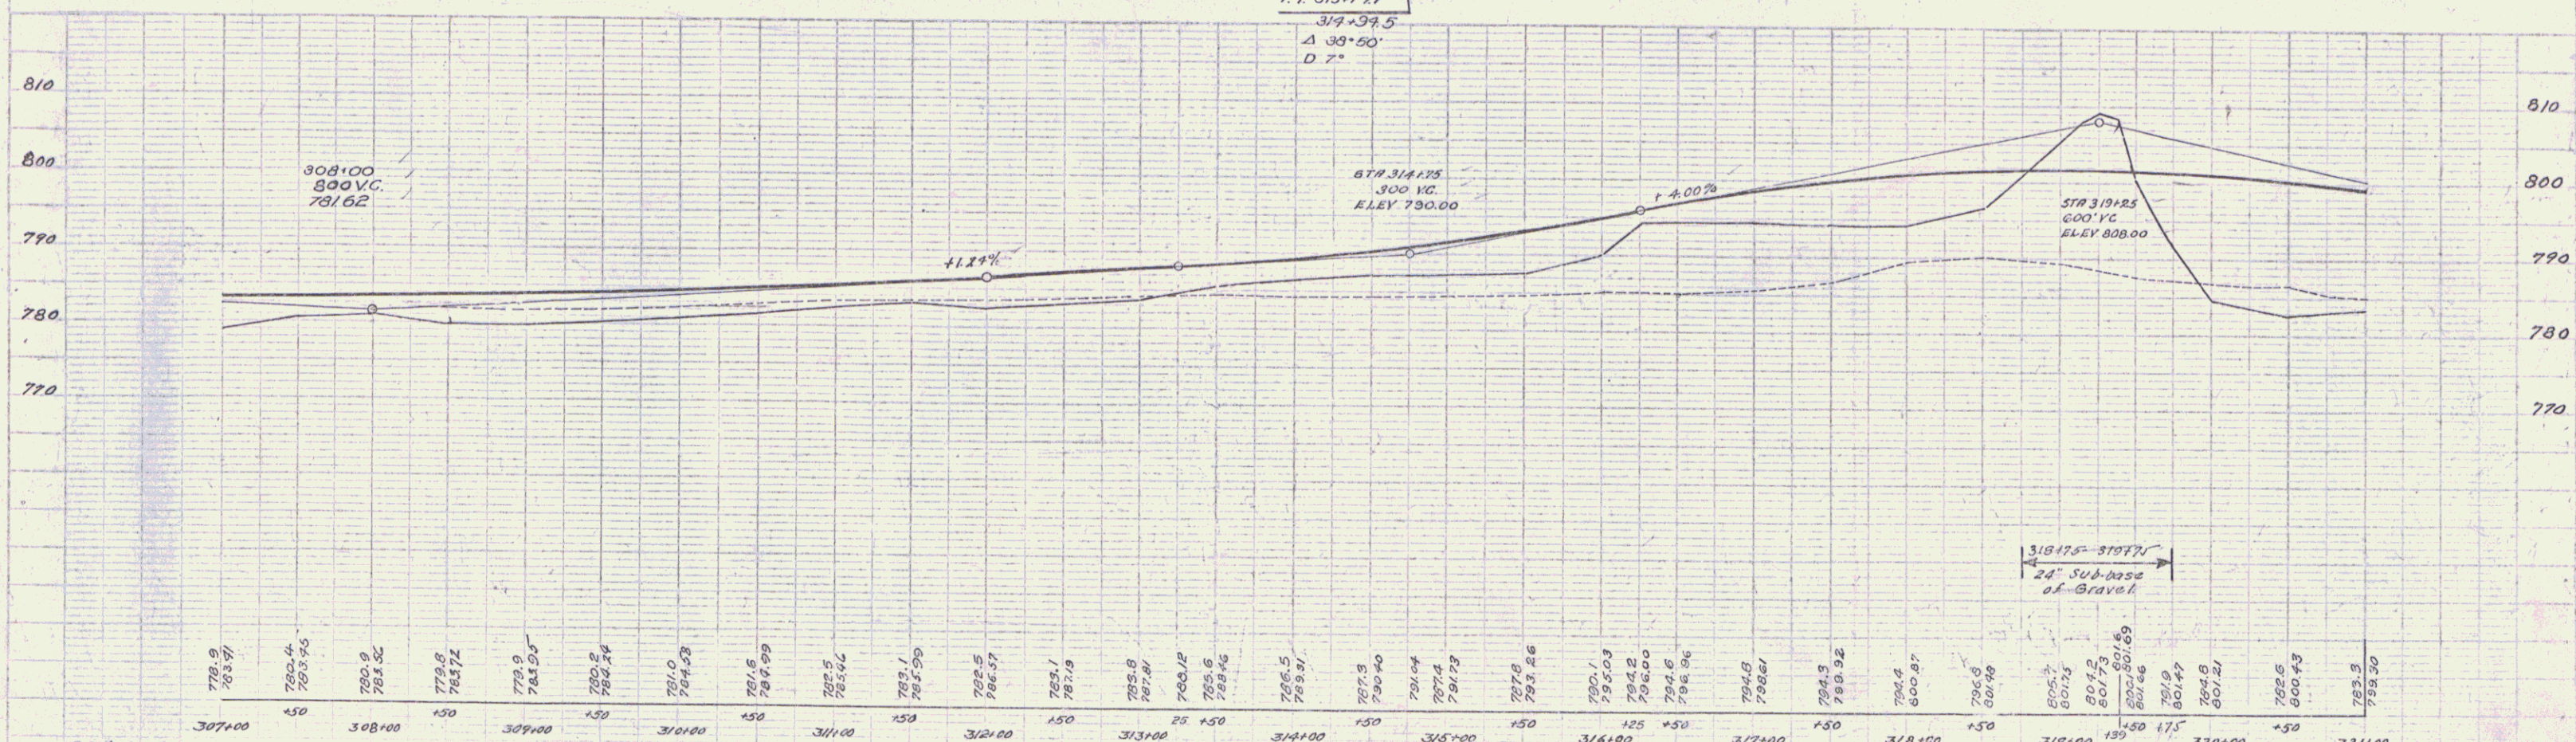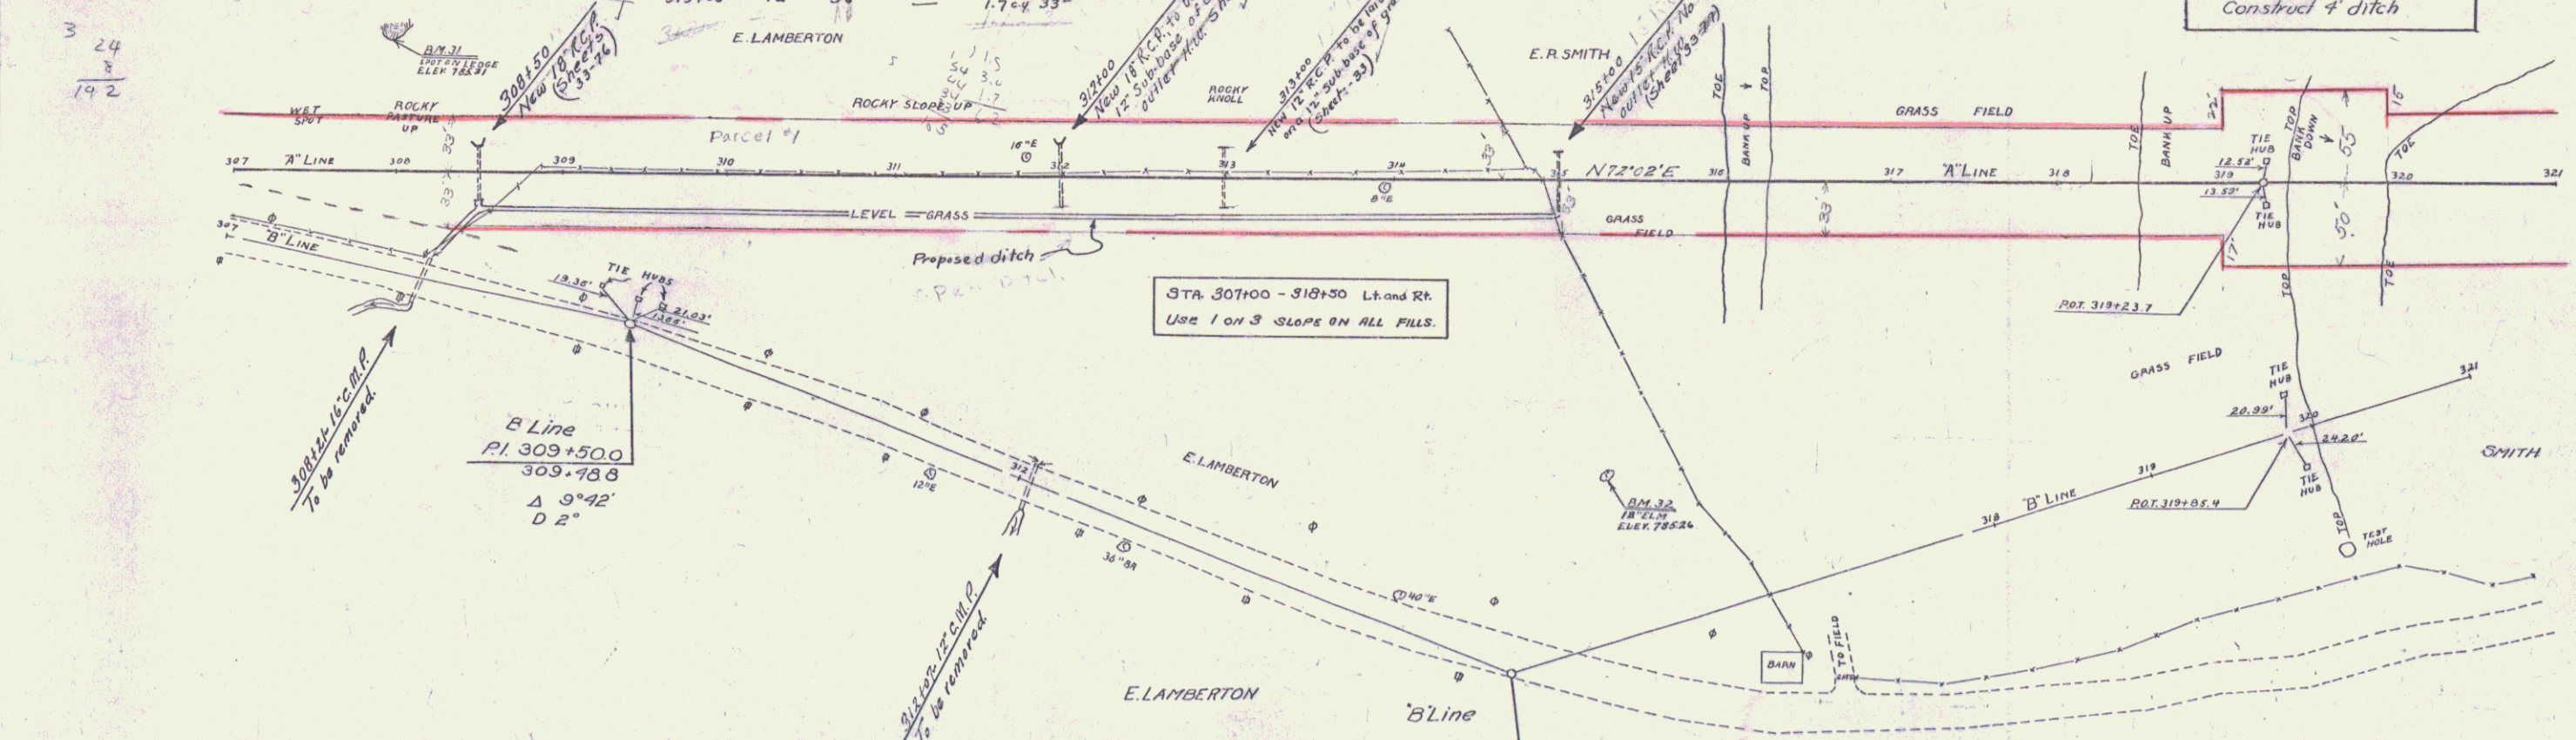

B.M. #31 Point on ledge 80' left of Sta. 308+00 Elev 795.31
 B.M. #32 Spike in rear of 18" Elev 795' Rt of Sta. 315+25 Elev 785.24

SERIES OF 97D
 SHEET 23 OF 99