
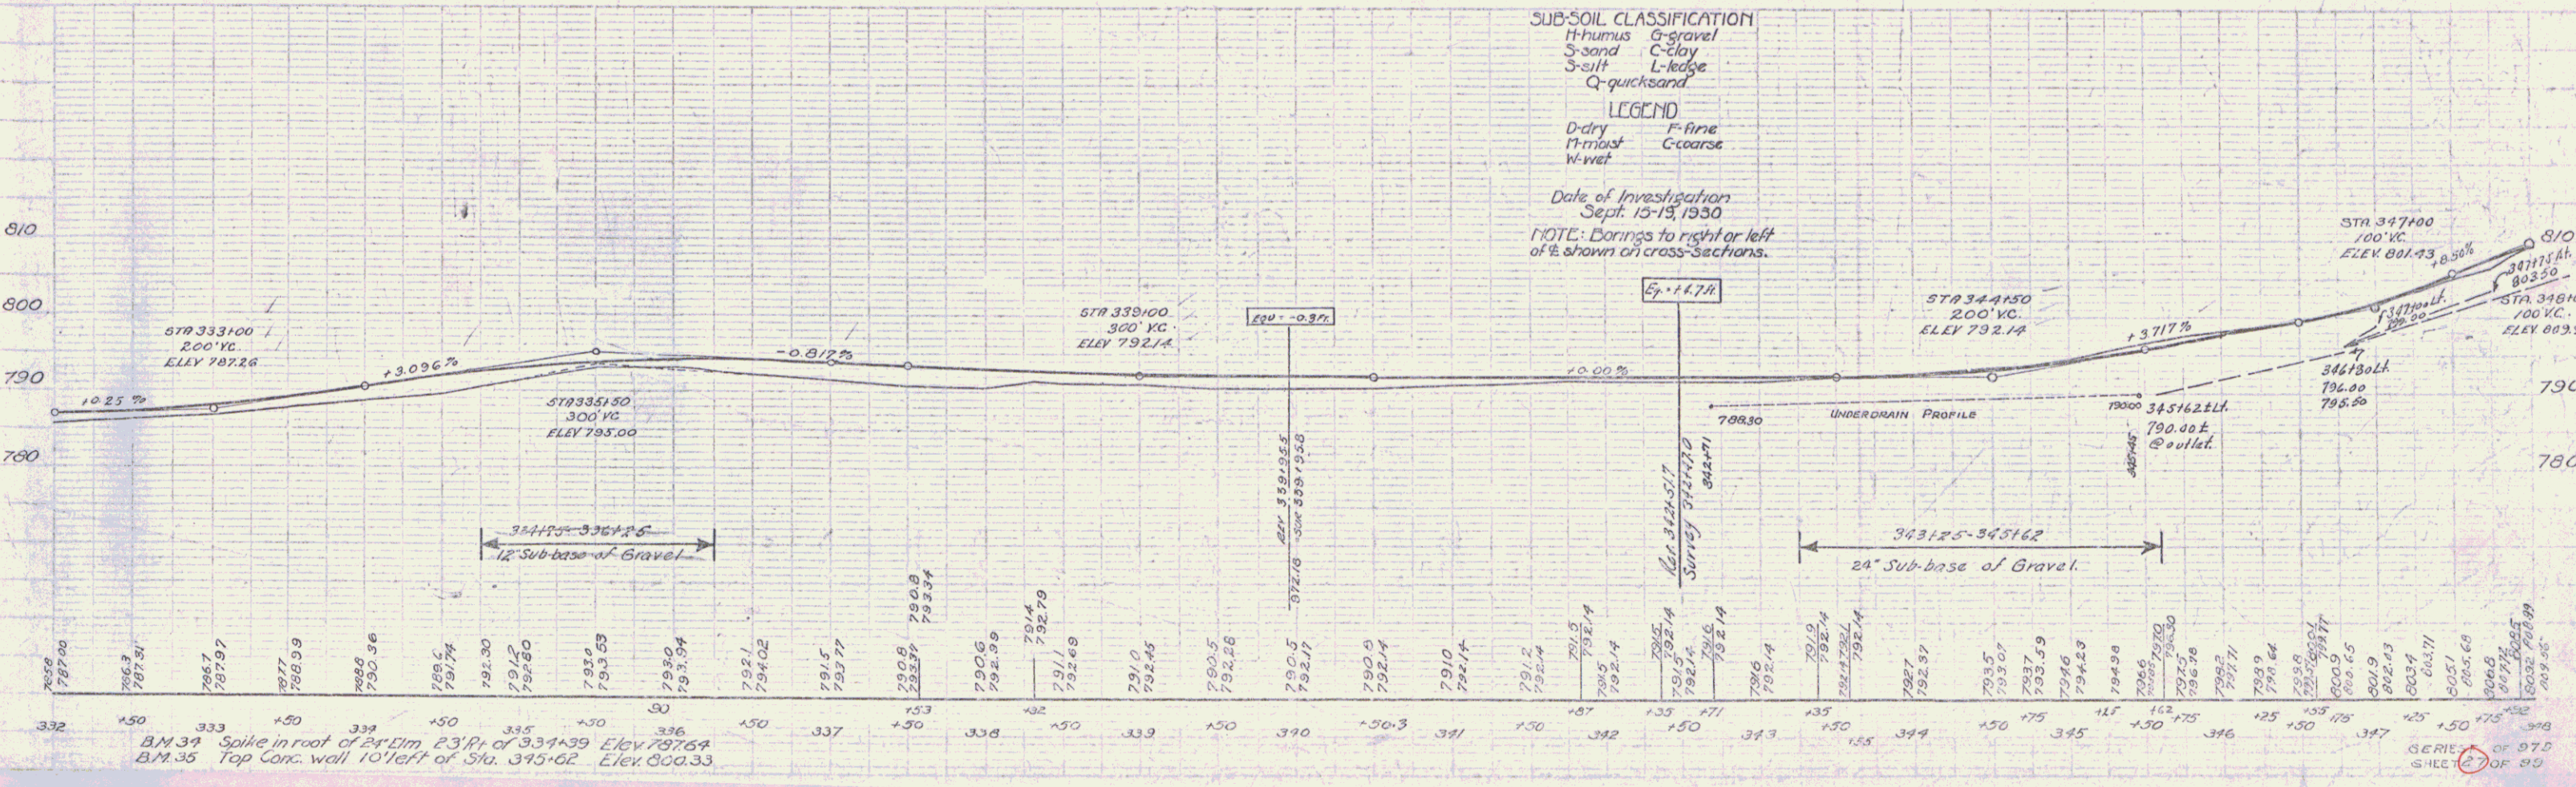


WOOD CURB PAV. REQUIRED				CABLE GUARD RAIL REQUIRED				NEW REIN. CONC. PIPE CULVERTS REQUIRED				CONCRETE CURB REQUIRED				CONCRETE CURB & GUTTER REQUIRED				
Stn.	Left	Right	Width	Sta.	Left	Right	Width	Station	Diam.	Length	Conc. A	Conc. C	Steel	D. Grates	Sta.	Left	Right	Width	Conc. A	Steel
330+32	24'			332+0	334+15	R	215'	20	235'	337+53	15"	40'	1.5cy	1.5cy	332+00	334+25	R	0.3038	2.5cy	151'
341+15	24'			336+28	339+44	R	216'	40	256'	341+15	15"	40'	1.5	1.5	334+25	335+90	L	163'	10.8cy	297'
342+71	24'									342+71	15"	40'	1.5	1.5						
343+15										343+15	15"	40'	1.5	1.5						
344+15										344+15	15"	40'	1.5	1.5						
345+15										345+15	15"	40'	1.5	1.5						
345+60										345+60	15"	40'	1.5	1.5						

Wood Guard Post Required

Sta	Left	Right
337+53		
341+15		
342+71		
343+15		
344+15		
345+15		
345+60	4 (Rein. Con)	4

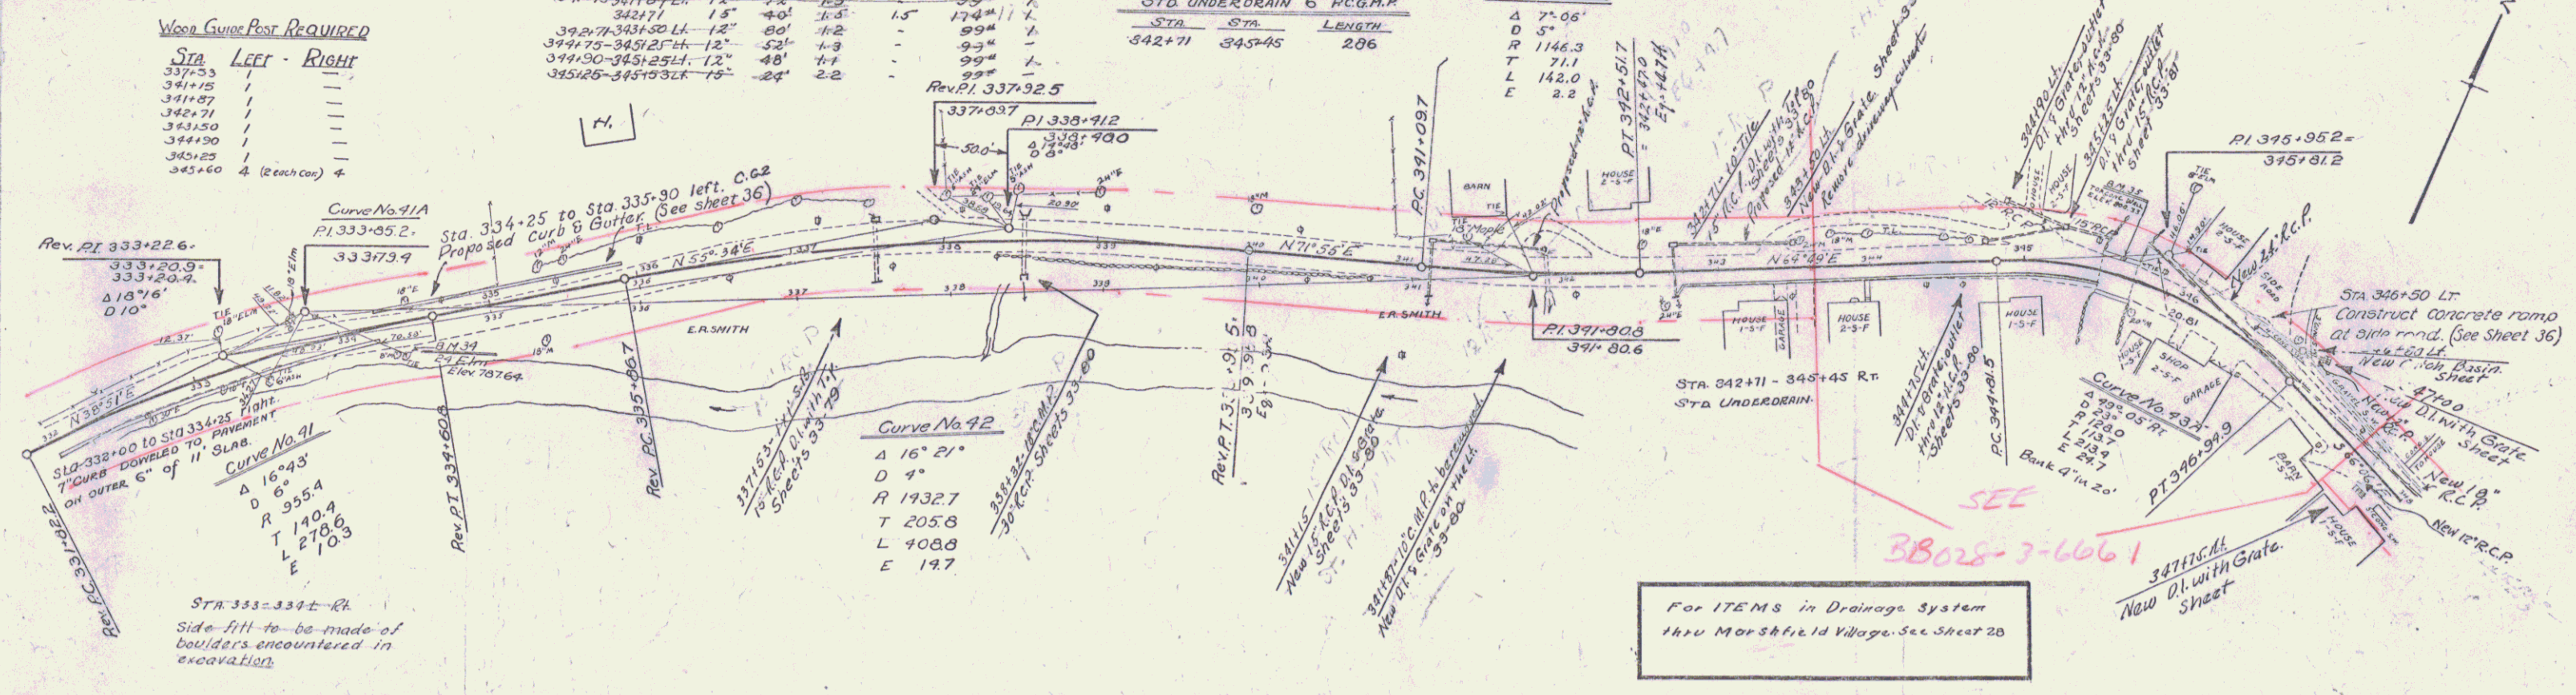

STATE OF OHIO  
 DIVISION OF HIGHWAYS  
 PROJECT NO. 970.1930.27  
 SHEET 25