


POOR ORIGINAL COPY

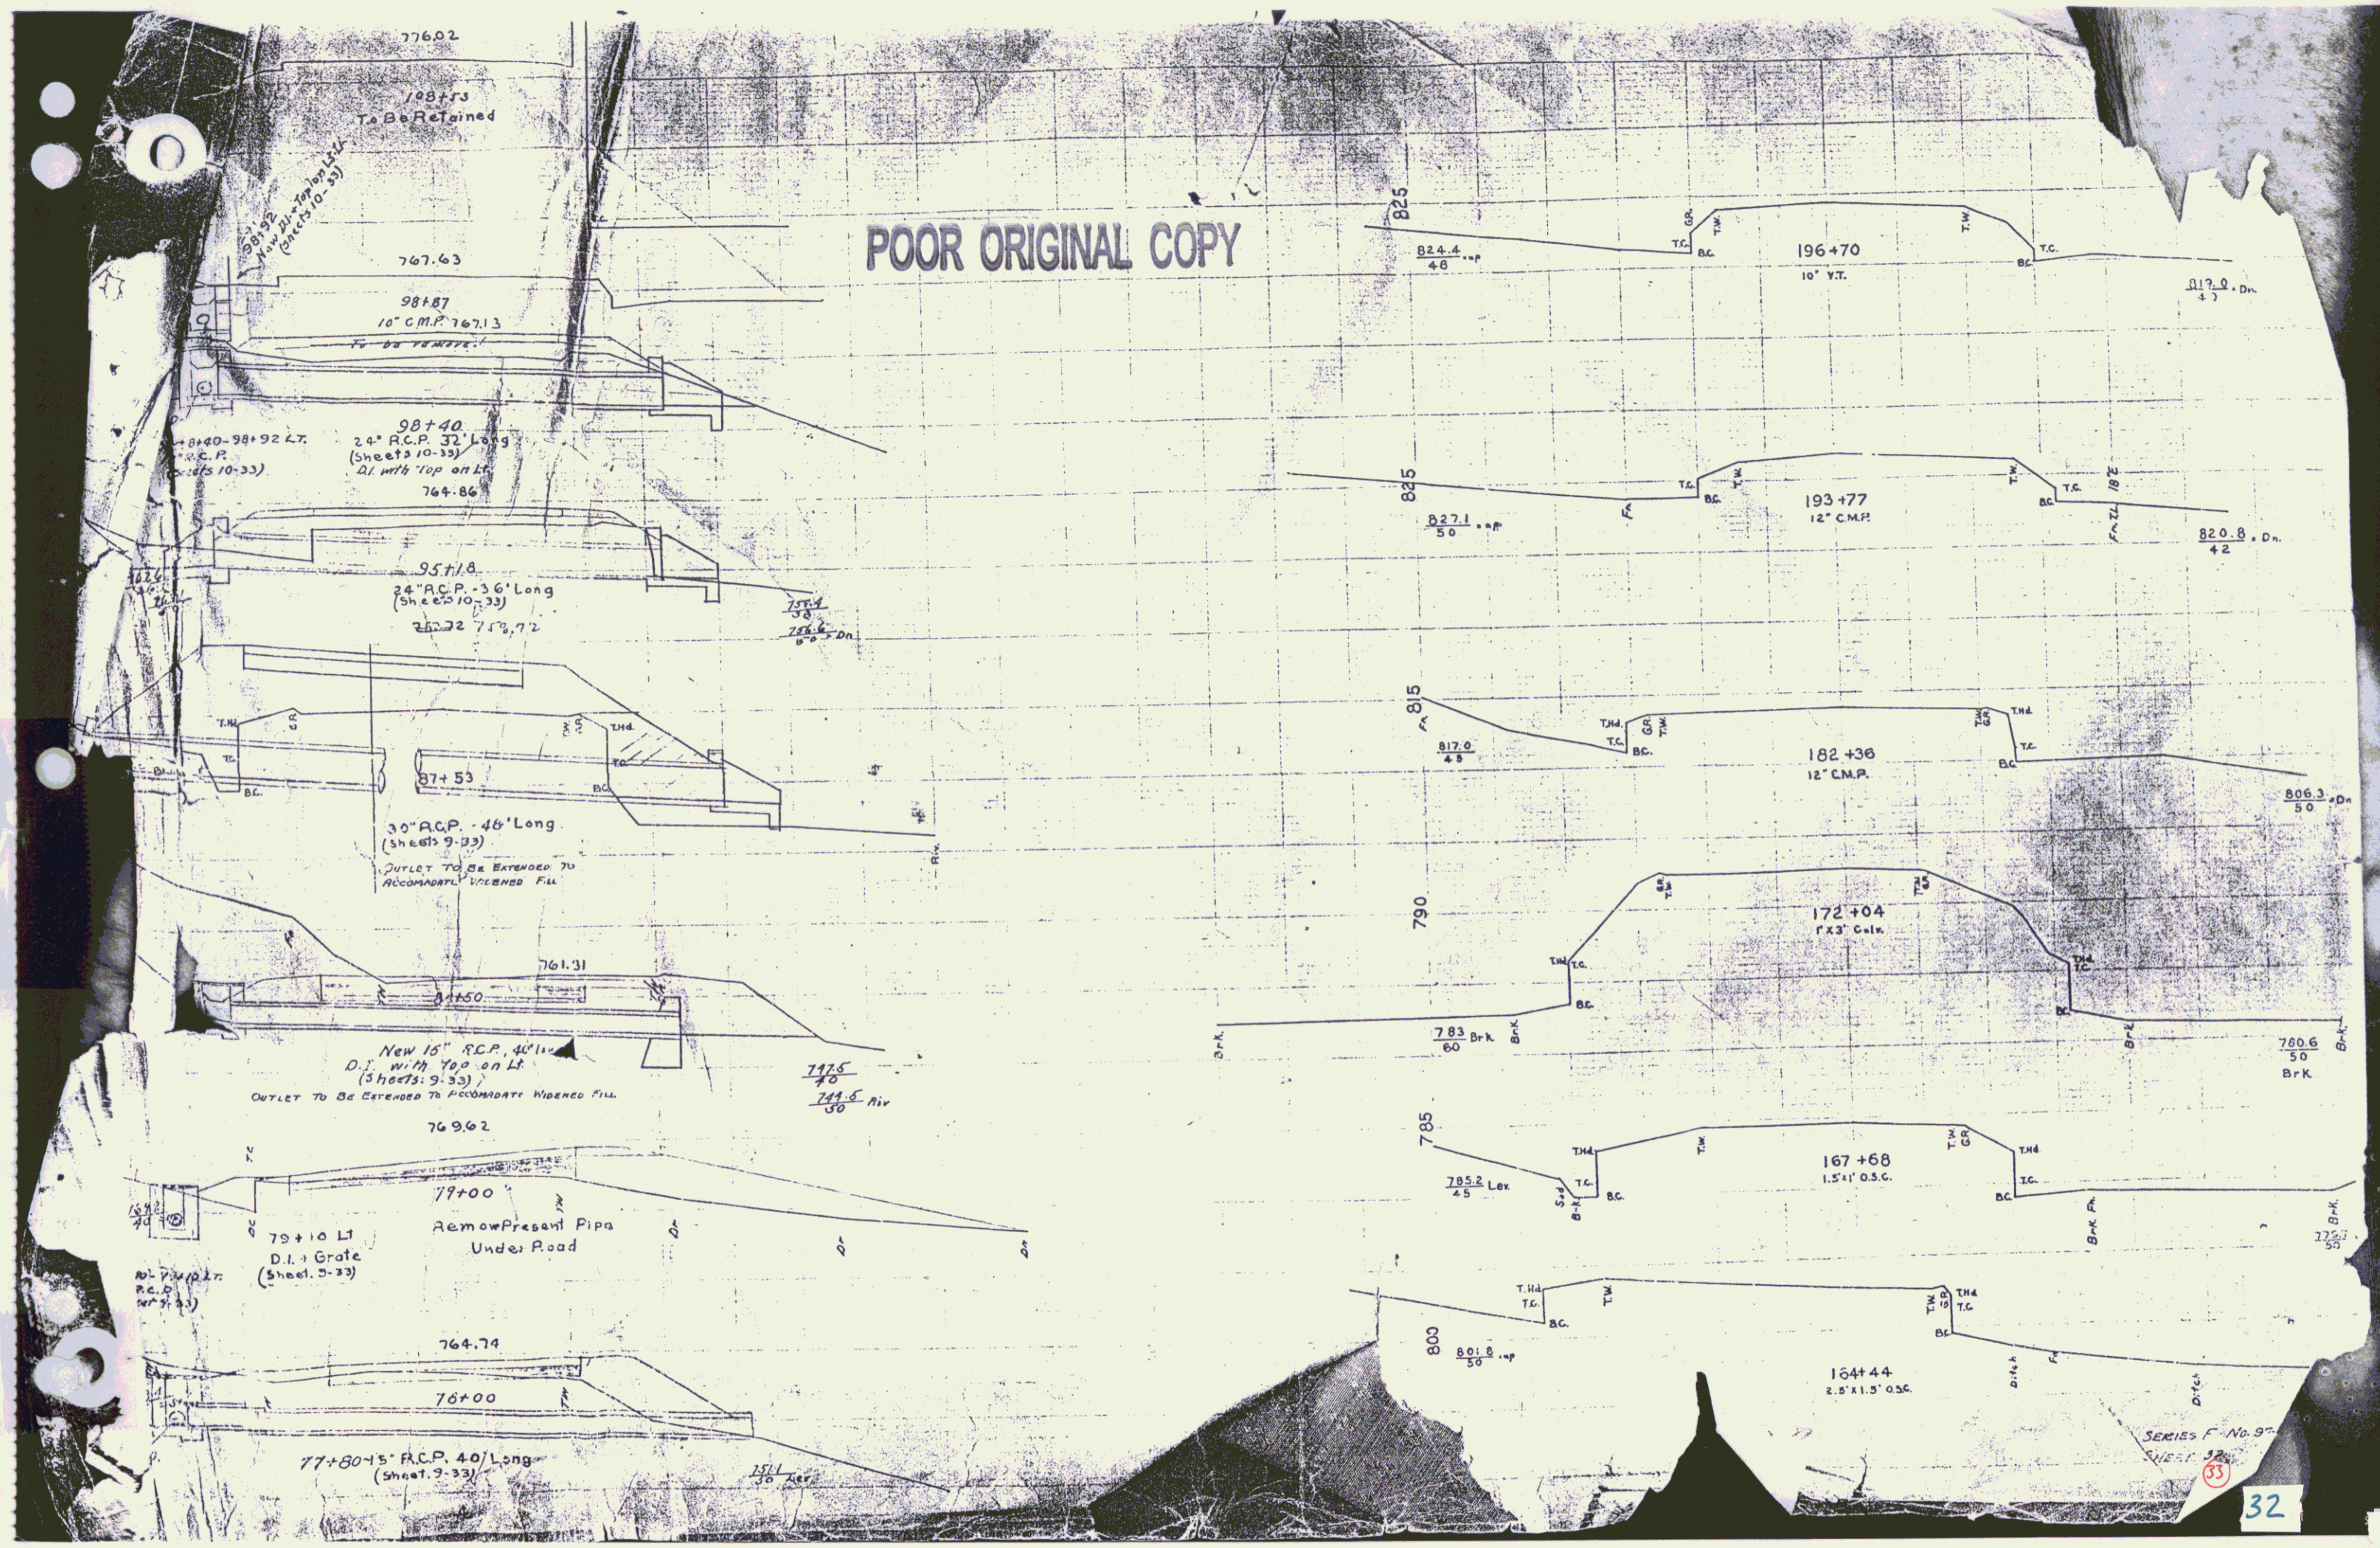

SERIES F-NO. 9-
HEET 32