

**GUARD RAIL REQUIRED ON LEFT**  
 Sta. 90+88 to 91+12 Length 24ft  
 - 96+73 - 96+97 - 24'  
 - 100+88 - 101+12 - 24'  
**ON RIGHT**  
 Sta. 90+88 to 91+12 Length 24ft  
 - 92+25 - 98+25 - 600'  
 - 93+25 - 104+69 - 544'  
**TOTAL THIS SHEET 1240ft**

**NEW CULVERTS REQUIRED**  
 Sta. 98+85 2'x2' Concrete 6.8cu yds  
 1-2-4 concrete 8.6 -  
 1-3-6 - 1.7cu yds  
 Sta. 101+00 16" Cor. I. P. 30ft  
 1-2-4 concrete 1.5cu yds  
 Sta. 103+50 12" Cor. I. P. 32ft  
 1-2-4 concrete 1.0cu yds


**CULVERT REPAIRS REQUIRED**  
 Sta. 91+00 18" Cor. I. P. 10ft  
 Lengthen and build drop inlet  
 1-2-4 concrete 1.7cu yds  
**RELAYING PIPE CULVERTS**  
 Sta. 91+00 16" Cor. I. P. 22ft

**STONE BASE REQUIRED**  
 Sta. 92+00 to 95+50 Length 350ft  
**STANDARD UNDERDRAIN REQUIRED**  
 Sta. 90+00 to 92+00 Length 200ft

FIELD NO.	STATE	FED. AID PROJ. NO.	SHEET NO.	TOTAL SHEETS
9	Vt.	27	520-21	7

E. J. Welch  
 C. H. Day  
 1927  
 1928  
 1929  
E. J. Welch  
 A. J. Johnson  
 M. E. Conkern  
 1927  
 1928  
 1929  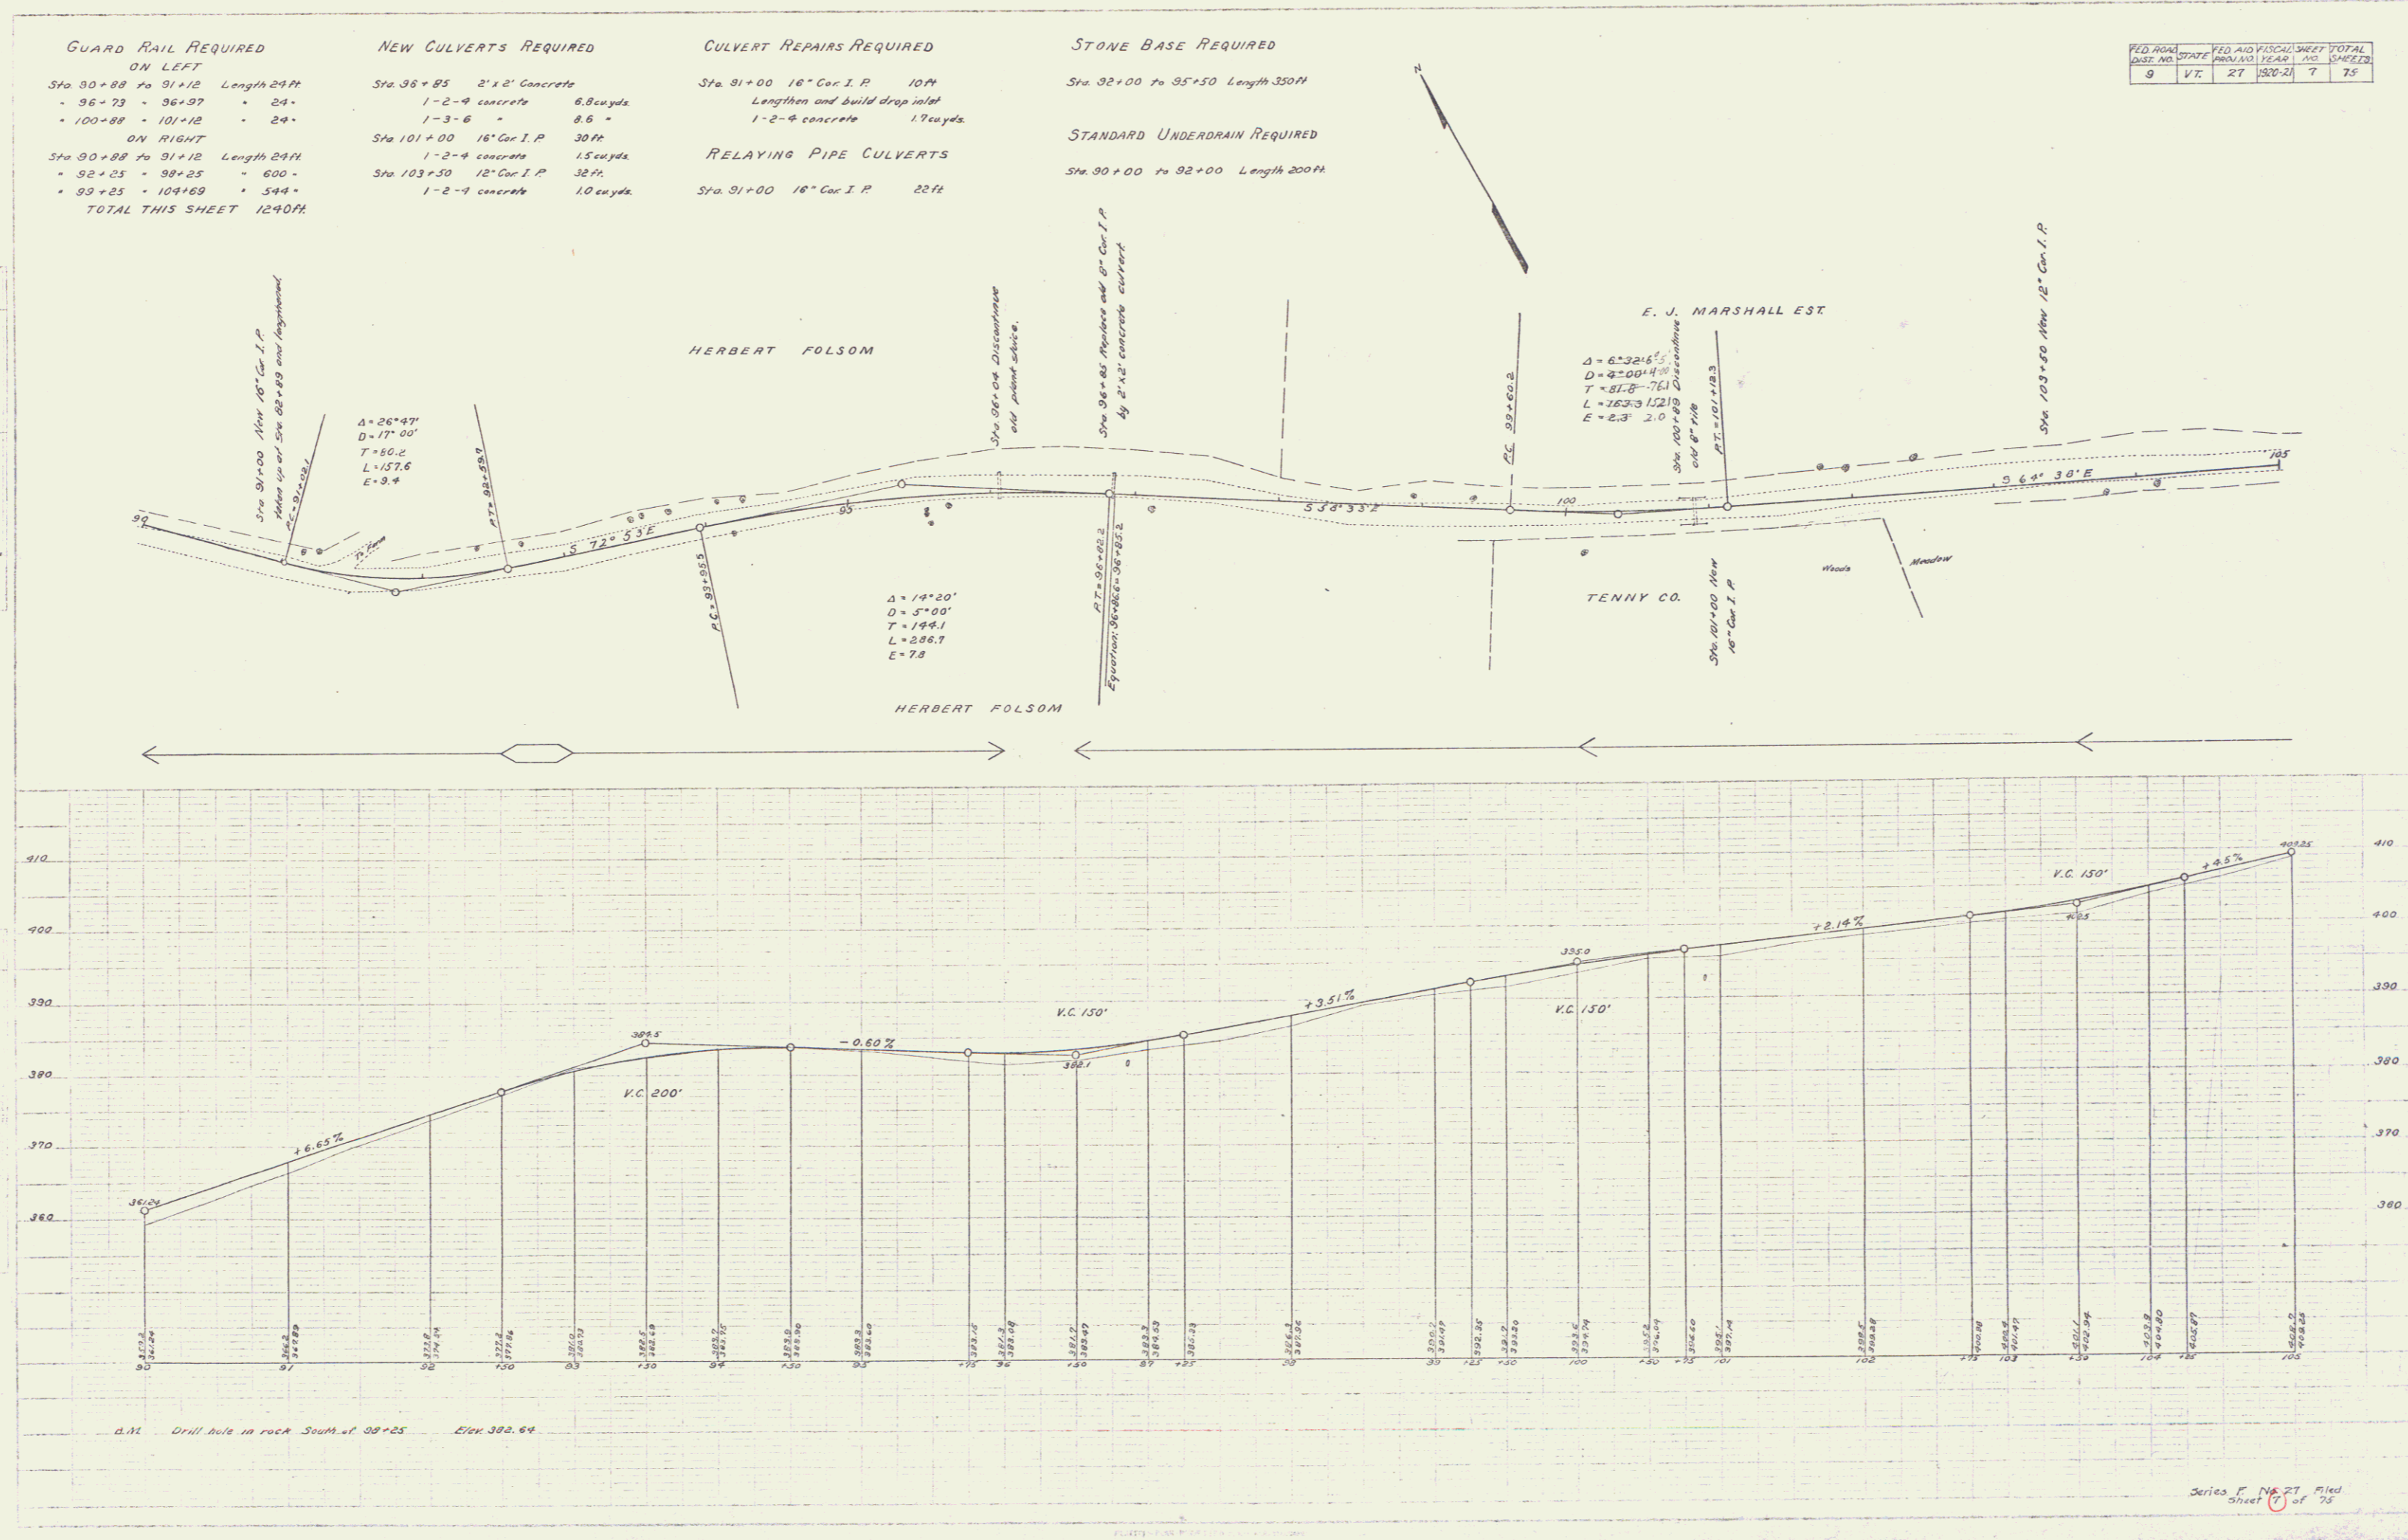
Series F No. 27 Final Sheet 6 of 78