

INDEX OF SHEETS

SHEET NO.	TITLE PAGE
2	TYPICAL CROSS-SECTION OF IMPROVEMENT
3	PLAN AND PROFILE STA. 104+00 TO STA. 120+00
4	120+00 TO STA. 136+00
5	136+00 TO STA. 146+00
6	146+00 TO STA. 161+00
7	161+00 TO STA. 176+00
8	176+00 TO STA. 186+00
9	CULVERT AT STA. 128+85
10	157+65
11-22	CROSS SECTIONS

FED. ROAD DIST. NO.	STATE	FED. AID PROJ. NO.	FISCAL YEAR	SHEET NO.	TOTAL SHEETS
3	Vt.	273	1928	1	22


STATE OF VERMONT
STATE HIGHWAY DEPARTMENT

PLAN AND PROFILE OF PROPOSED
STATE HIGHWAY


FEDERAL AID PROJECT

TOWN OF CABOT
MOLLY'S FALLS ROAD
BETWEEN SECTIONS OF 27A

Pin# 99R128

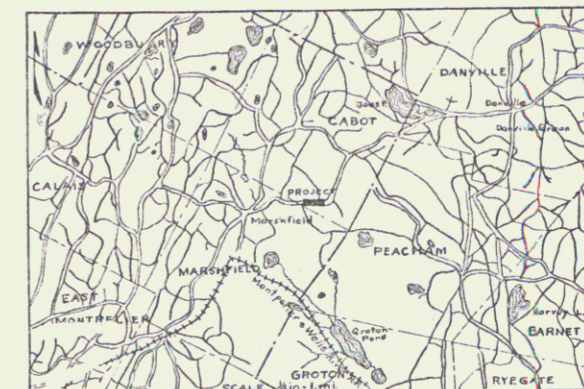

SCALES
Plan 1 in = 50 ft.
Profile Horiz. 1 in = 50 ft. Vert. 1 in = 10 ft.
Cross Sections 1 in = 5 ft.

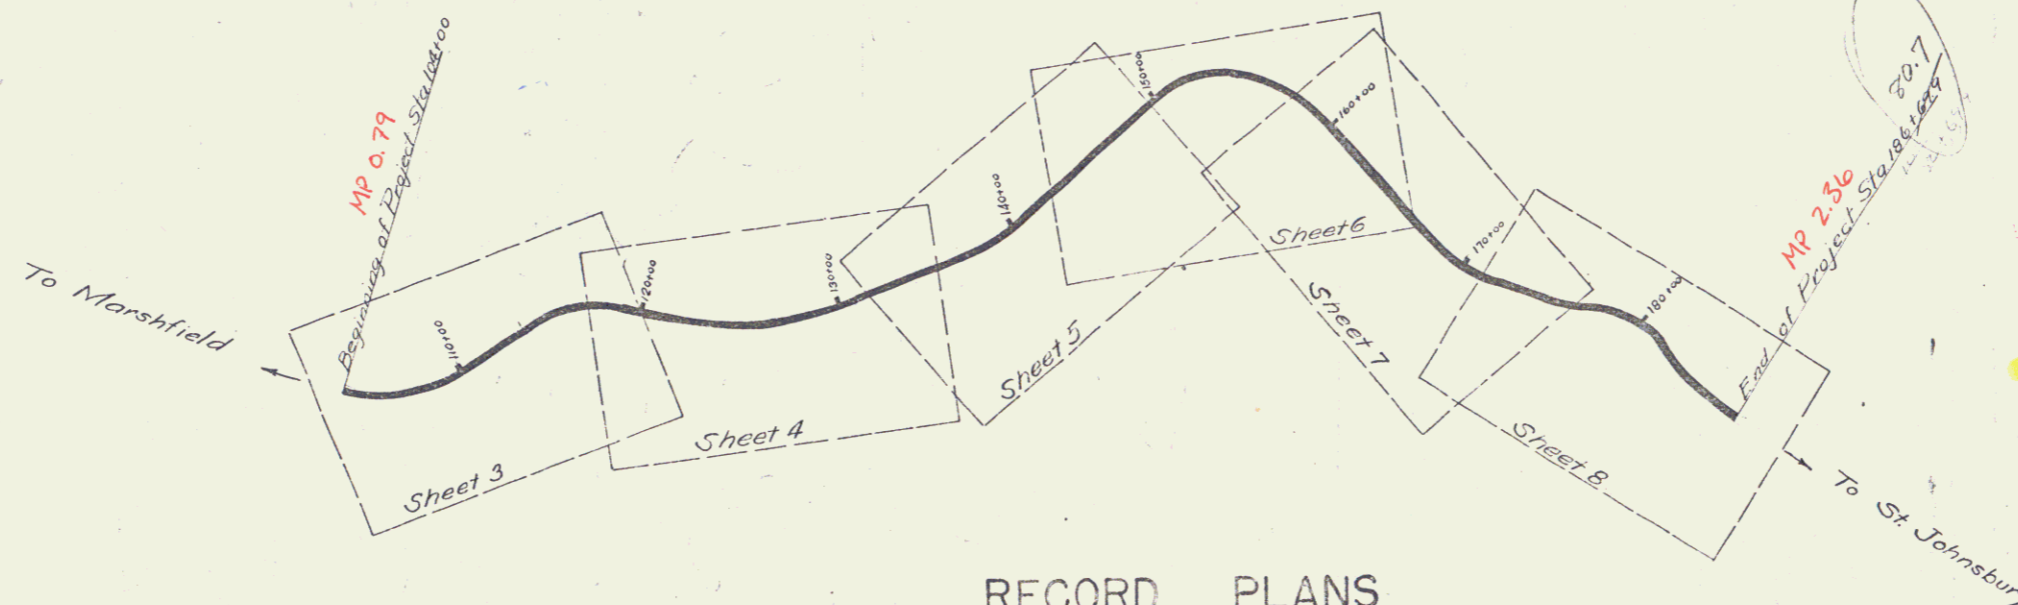

RIGHT-OF-WAY DIVISION
TOWN FILE
PERPETUAL
Town of US 2
(To Be Returned To R.O.W. Division)

RECORD PLANS

LAYOUT
SCALE 1 in = 500 ft.

CONVENTIONAL SIGNS

COUNTY LINE	GROUND ELEVATION	DATUM	LINE
TOWN LINE	GRADE ELEVATION	DATUM	LINE
FENCE LINE			
STONE WALL			
UNFENCED PROPERTY			
GUARD RAIL			
TRAVELED WAY			
RAILROAD			
RETAINING WALL			
CENTERLINE			
SURVEY LINE			
CULVERT			
DROP INLET			
TROLLEY POLE			
POWER POLE			
TELEPHONE POLE			
TREES			
HEDGE			

SUBMITTED BY ORDER OF THE STATE HIGHWAY BOARD
CHIEF ENGINEER
DEPARTMENT OF HIGHWAYS

RECOMMENDED
DISTRICT ENGINEER
BUREAU OF PUBLIC ROADS
RECOMMENDED FOR APPROVAL
CHIEF ENGINEER
BUREAU OF PUBLIC ROADS
APPROVED
DIRECTOR - BUREAU OF PUBLIC ROADS

SERIES F No. 273
SHEET 1 OF 22

01/01/23