


INDEX OF SHEETS

SHEET	TITLE PAGE
1	TITLE PAGE
2	TYPICAL CROSS SECTIONS OF IMPROVEMENT
3	DETAILS OF CONSTRUCTION (BANKING AND WIDENING)
4-28	PLAN AND PROFILE
29	STANDARD STRUCTURE SHEET 520 PIPE CULVERTS
30	" " " 521 BOX CULVERTS
31	" " " 522 GUARD RAIL
32	CULVERT " 521
33-39	CROSS SECTIONS

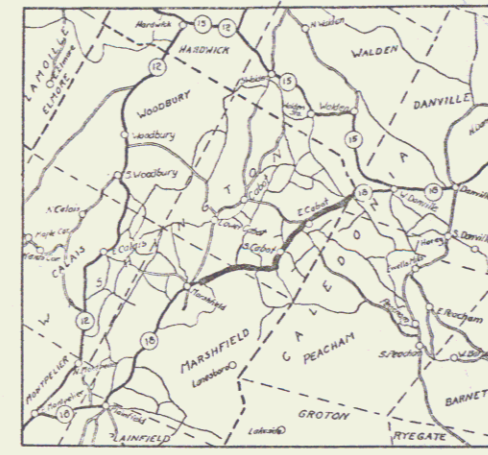


SCALE 1 INCH = 5 MILES

TOWNS OF MARSHFIELD-CABOT

MONTPELIER ST. JOHNSBURY ROAD

FROM THE MOLLY FALLS BRIDGE
 EAST 7.212 MILES TO THE
 CABOT DANVILLE TOWN LINE
 LENGTH OF PROJECT
 38,081.1 FT. = 7.212 MILES

Pin# 99R129

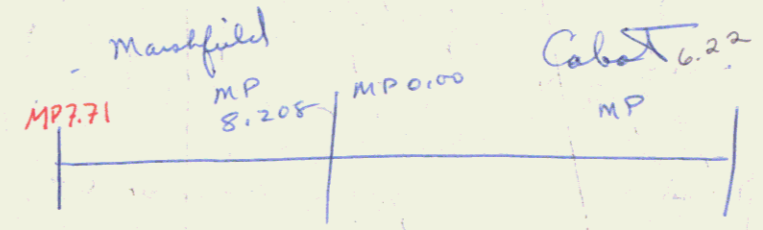

SCALES
 PLAN 1" = 50'
 PROFILE 1" = 30'
 VERT 1" = 10'
 SECTIONS 1" = 5'

RIGHT-OF-WAY DIVISION
 TOWN FILE
 PERPETUAL
 Town of US2
 (To Be Returned To R.O.W. Division)

PROJECT	Marshfield-Cabot
DRAWN	27 L
TYPE	
CONTRACTOR	
LOCATION	See file card
YEAR	
LENGTH	
MI.	

CORRECT
 ROAD ENGINEER

Surveyed by
 Designed by
 Drawn by
 Traced by
 Checked by
 Series F No. 27L Filed
 Sheet 1 of 34 Sheets

6/9/1932