
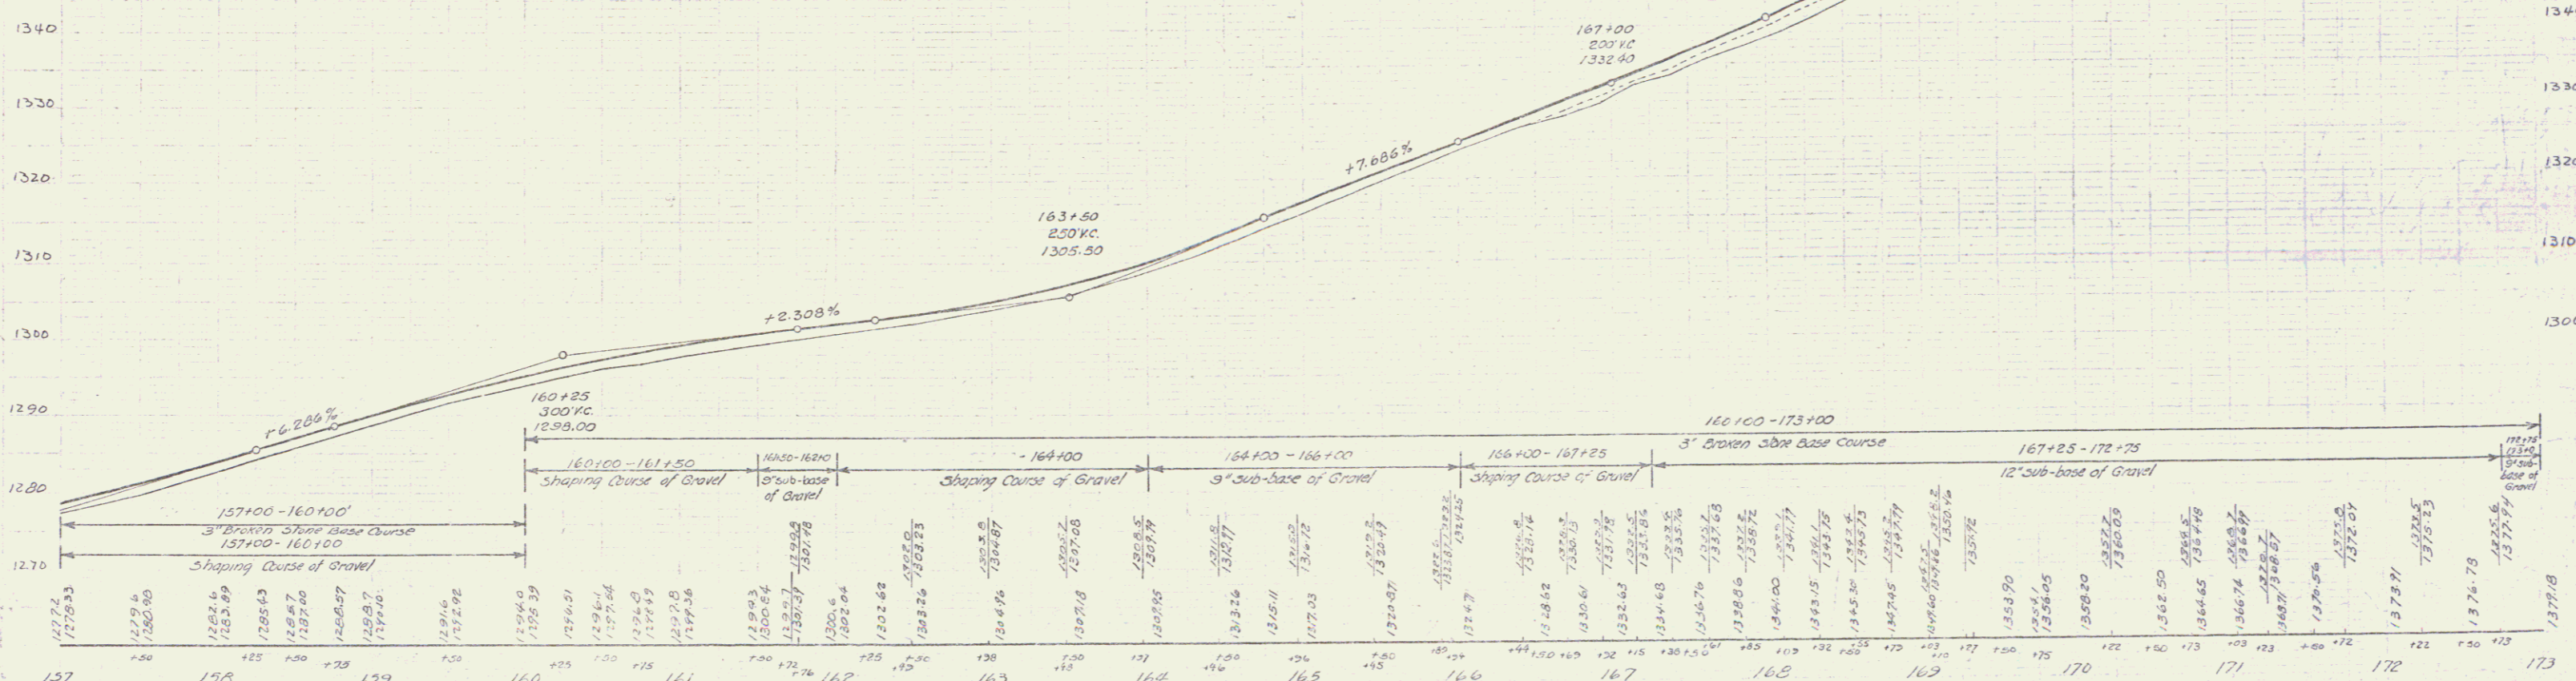


Parcel	Kind of Instrument	Date of Grant	Grantor	Grantee	Recorded	Remarks
A88	G.C.D	11-14-31	H.F. & J.B. Morse	St. of W. 13	537	A-31-31

27-L 1302 14 84

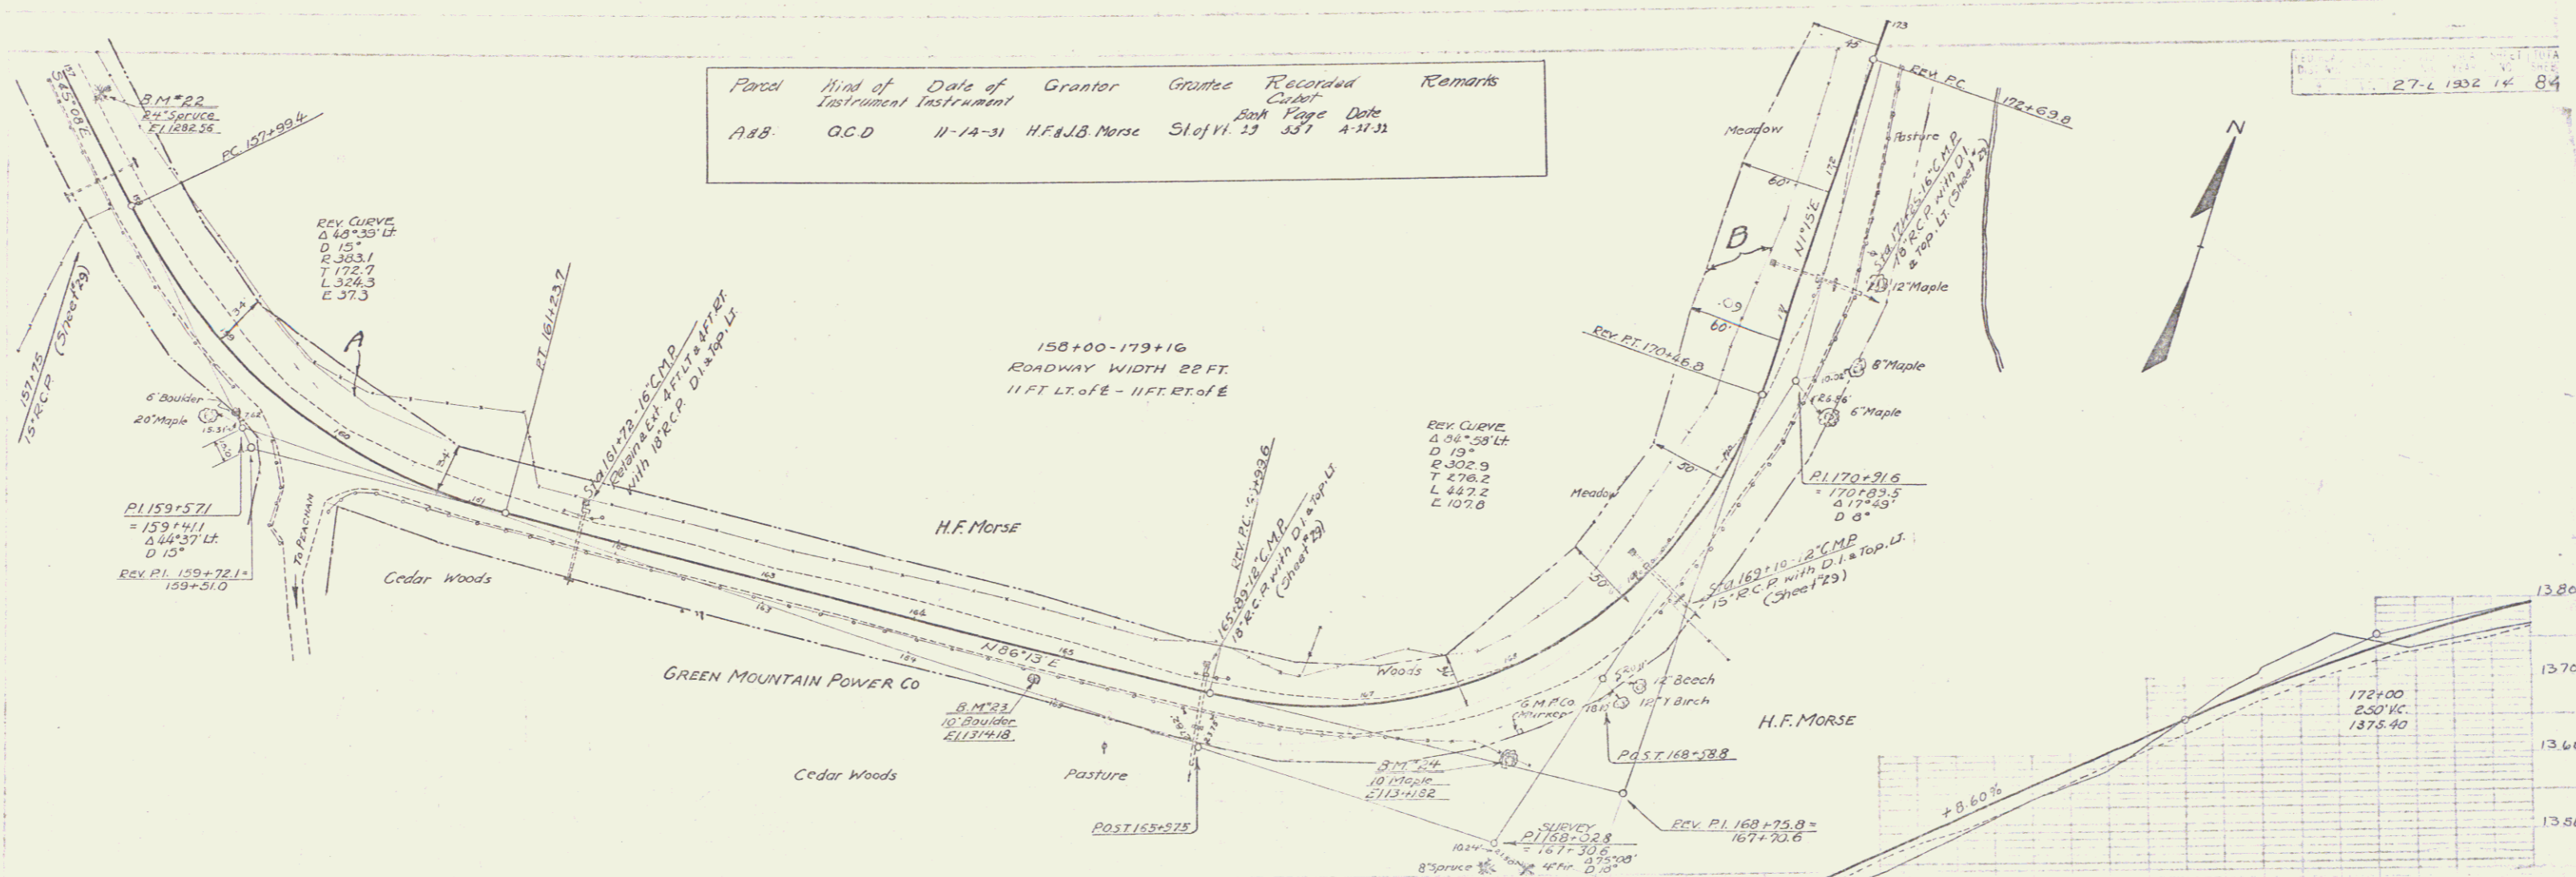

B.M.*22 Spike in Root 24' Spruce 16' Lt. Sta. 157+23. El. 1232.56
 B.M.*23 Spot on 10' Boulder 7' Lt. Sta. 164+85 El. 1314.18
 B.M.*24 Spike in Root 10' Maple 33' Rt. Sta. 167+51 El. 1341.82

SERIES F No 27-L
 SHEET 4 OF 8