

LEASE AREA <sup>1998</sup> not an active lease.

N/F  
ASTLE

JOE'S POND  
COUNTRY STORE

HASTINGS STORE

GARAGE

RTE. 15 TO HARDWICK

TO MARSHFIELD

CENTERLINE

U.S. RTE. 2

TO ST. JOHNSBURY

PARKING LOT

REV. 91+30

58' RT.

REV. 91+30

68' RT.

REV. 92+72

80.5' RT.

REV. 92+85.5

62.5' RT.

94+39.5

19.5' RT.

94+42.5


47' RT.

(0.19A±)

LAMOILLE VALLEY RAILROAD

STATE OF VERMONT  
AGENCY OF TRANSPORTATION

TOWN OF DANVILLE (7A)

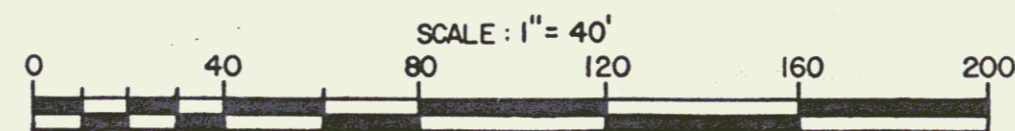

APPROX. SCALE 1" = 40' DATE 7-24-84 DRAWN BY D.E.M.

3