
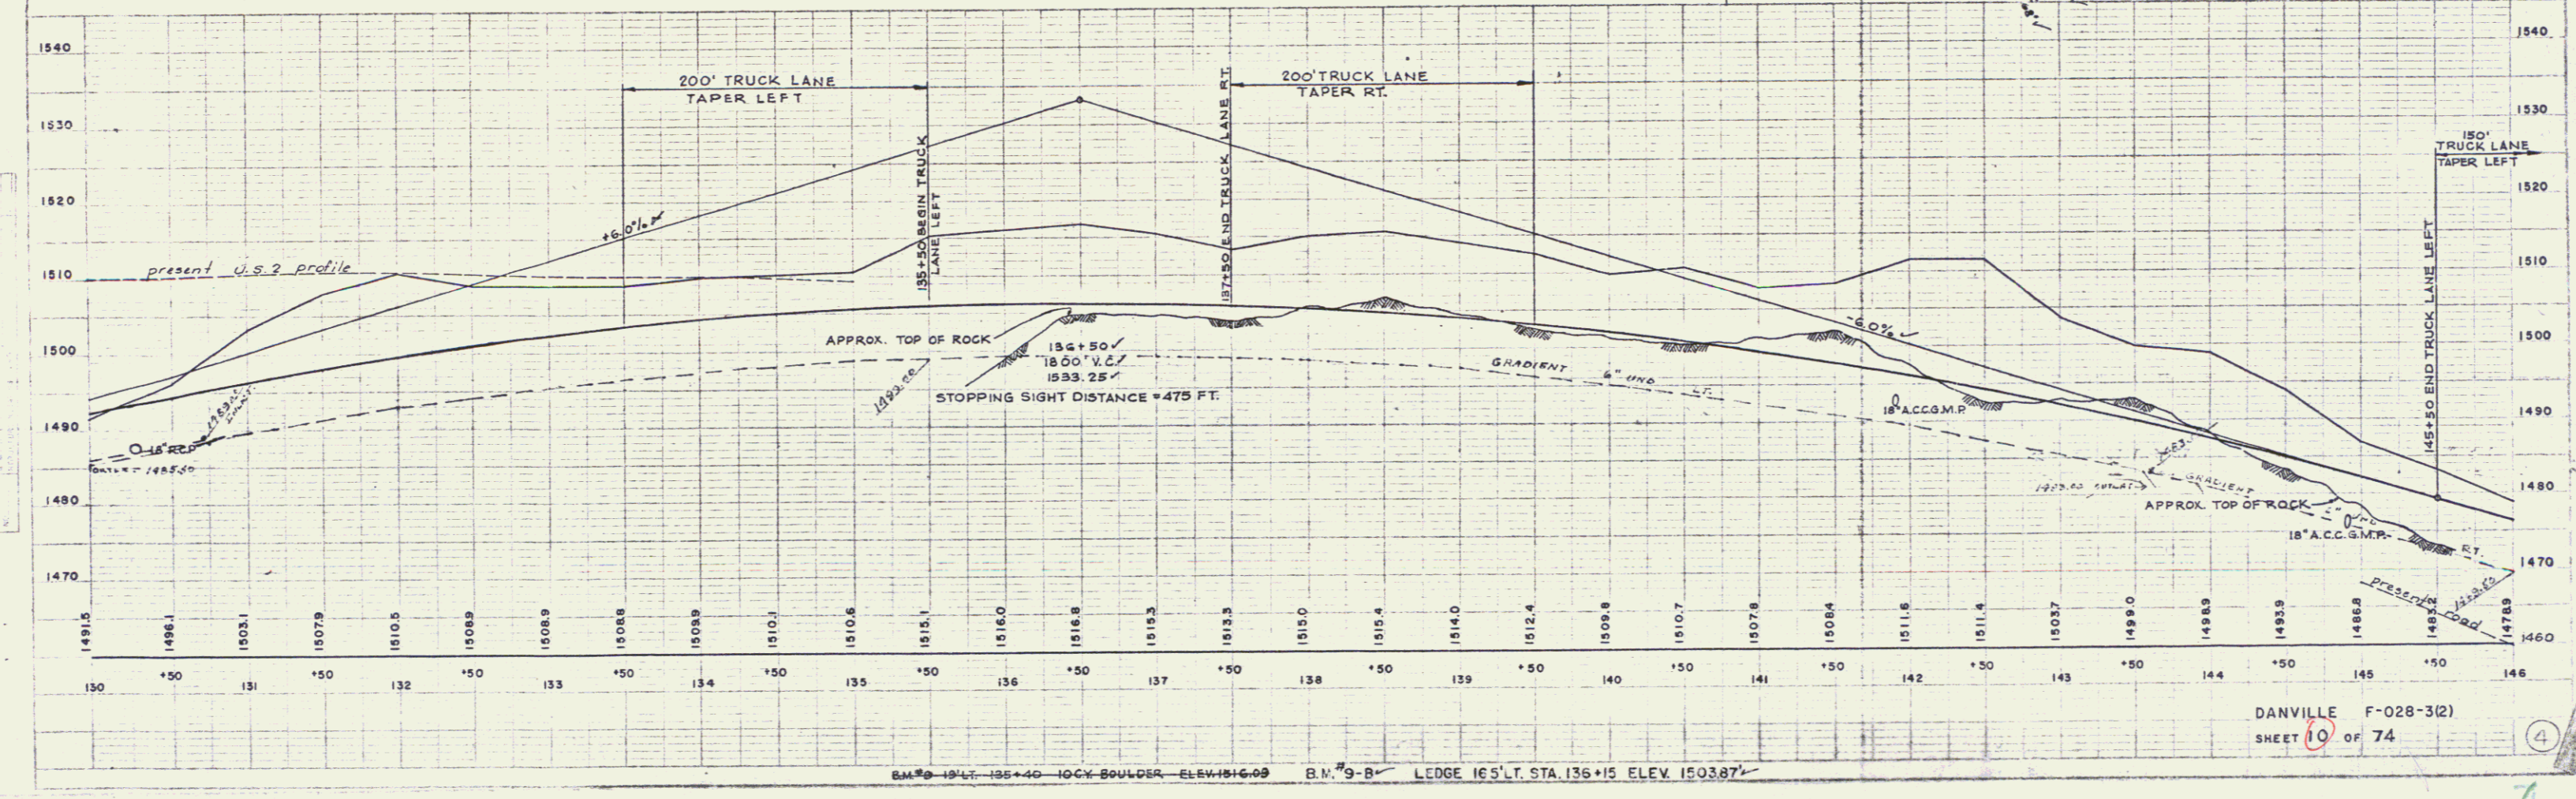


VT. HIGHWAYS DEPT. 6-58  
 FENTON & KEYS ASSOC. 6-58  
 PLAN  
 NO. 100-100-00-01

VT. HIGHWAYS DEPT. 6-58  
 FENTON & KEYS ASSOC. 6-58  
 PROFILE  
 NO. 100-100-00-01

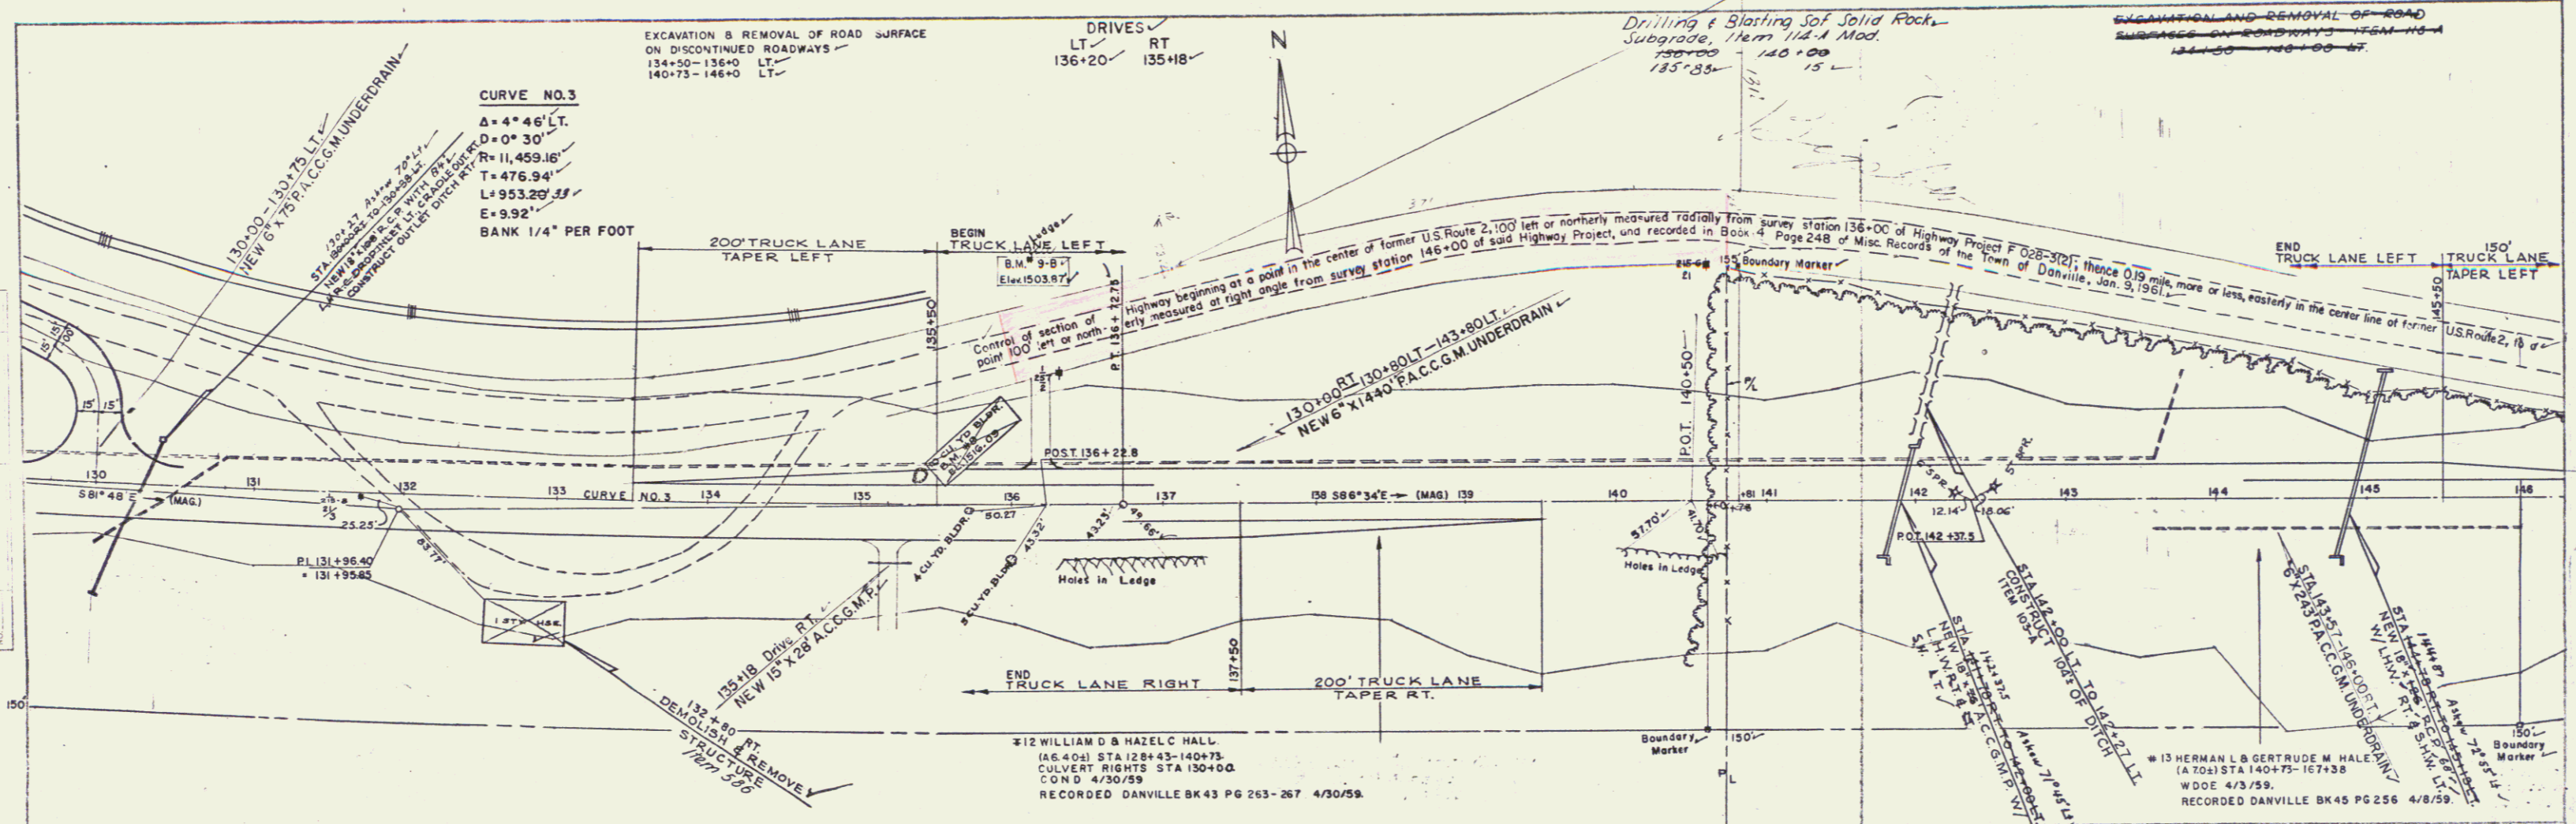

6