
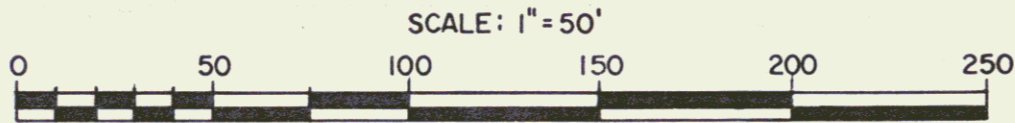


FORMERLY PART OF US RT. 2 RELINQUISHED TO THE TOWN OF DANVILLE
 BY CERTIFICATE OF HIGHWAY RELINQUISHMENT DATED DEC. 30, 1960 AND
 RECORDED JAN. 9, 1961 IN BK. 4 PG. 248 OF THE MISCELLANEOUS RECORDS
 OF THE TOWN OF DANVILLE

MP 0255 - M.P. 0275

COULD FIND NO
 DOCUMENTATION OF
 THIS IN MAINTENANCE
 OR DIST. TOWN FILES
 OR ON MICROFILM

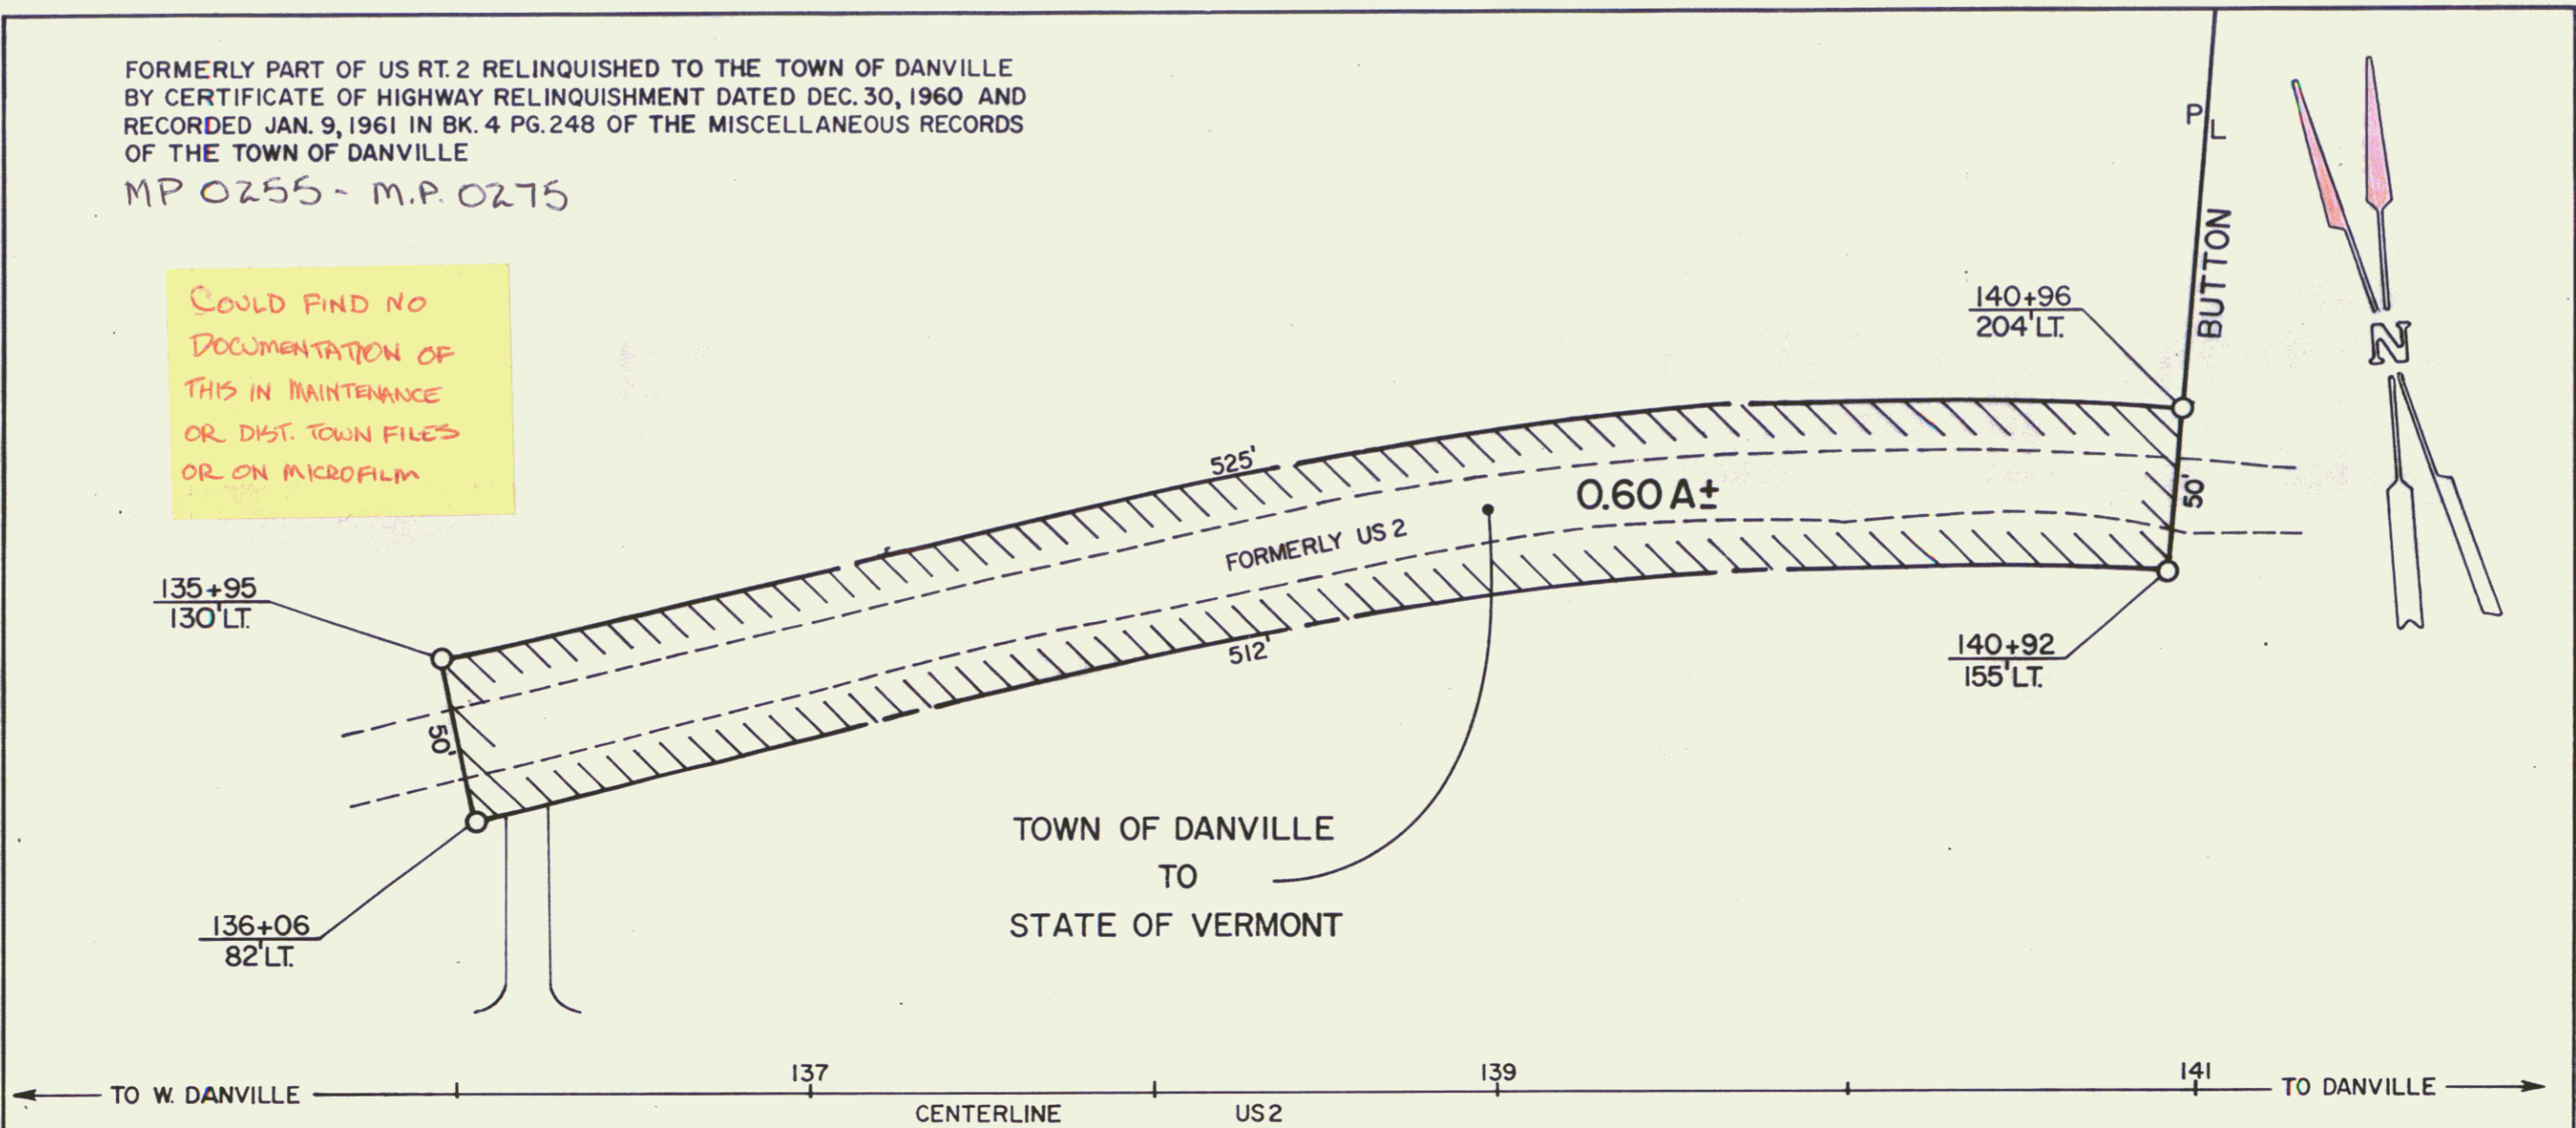

REF. SHEET 10 OF 74		
STATE OF VERMONT AGENCY OF TRANSPORTATION		
TOWN OF DANVILLE		(10A)
PROJECT: DANVILLE F 028-3(2)		
APPROX. SCALE 1"=50'	DATE 4-18-83	DRAWN BY D.E.M.