

EXCAVATION AND REMOVAL OF ROAD SURFACES ON ROADWAYS - ITEM 118-A  
146+00 - 159+50 - LT. 148+50

14A RAYMOND R & MARTHA S SEVIGNY  
(A.O. 574) STA 149+71-157+30  
WDOE 2/21/59  
RECORDED DANVILLE BK 43 PG 240 2/26/59

CONSTRUCT DRIVES

153+18.5	LT.
154+82	LT.
157+83	LT.
158+80	LT.
160+28	LT.
161+67	LT.
155+00	RT.

147.90 4



THREE CABLE GUARD RAIL MUCK EXCAVATION 154+75 to 156+75  
WITH STEEL POSTS  
LT. 4L 149+50. RT. 148+19 - 150+50  
LT. 4 RT. 144+50 - 144+50  
150+13 - 150+13.52  
158+04 - 158+52

REMOVAL AND DISPOSAL OF PRESENT GUARD RAIL  
LT. 4 RT. 156+06 - 156+50

15 PAUL & NILA S BERARD  
(A.O. 094) STA 157+30-158+30  
WDOE 2/21/59  
RECORDED DANVILLE BK 43 PG 243 2/26/59

14B RAYMOND R & MARTHA S SEVIGNY  
(A.O. 281) STA 158+30-161+50  
WDOE 2/21/59  
RECORDED DANVILLE BK 43 PG 240 2/26/59

VT. HIGHWAYS DEPT. 5-58  
DIVISION & DISTRICTS 5-58  
PLAN  
DATE 10/1/58  
BY [Signature]

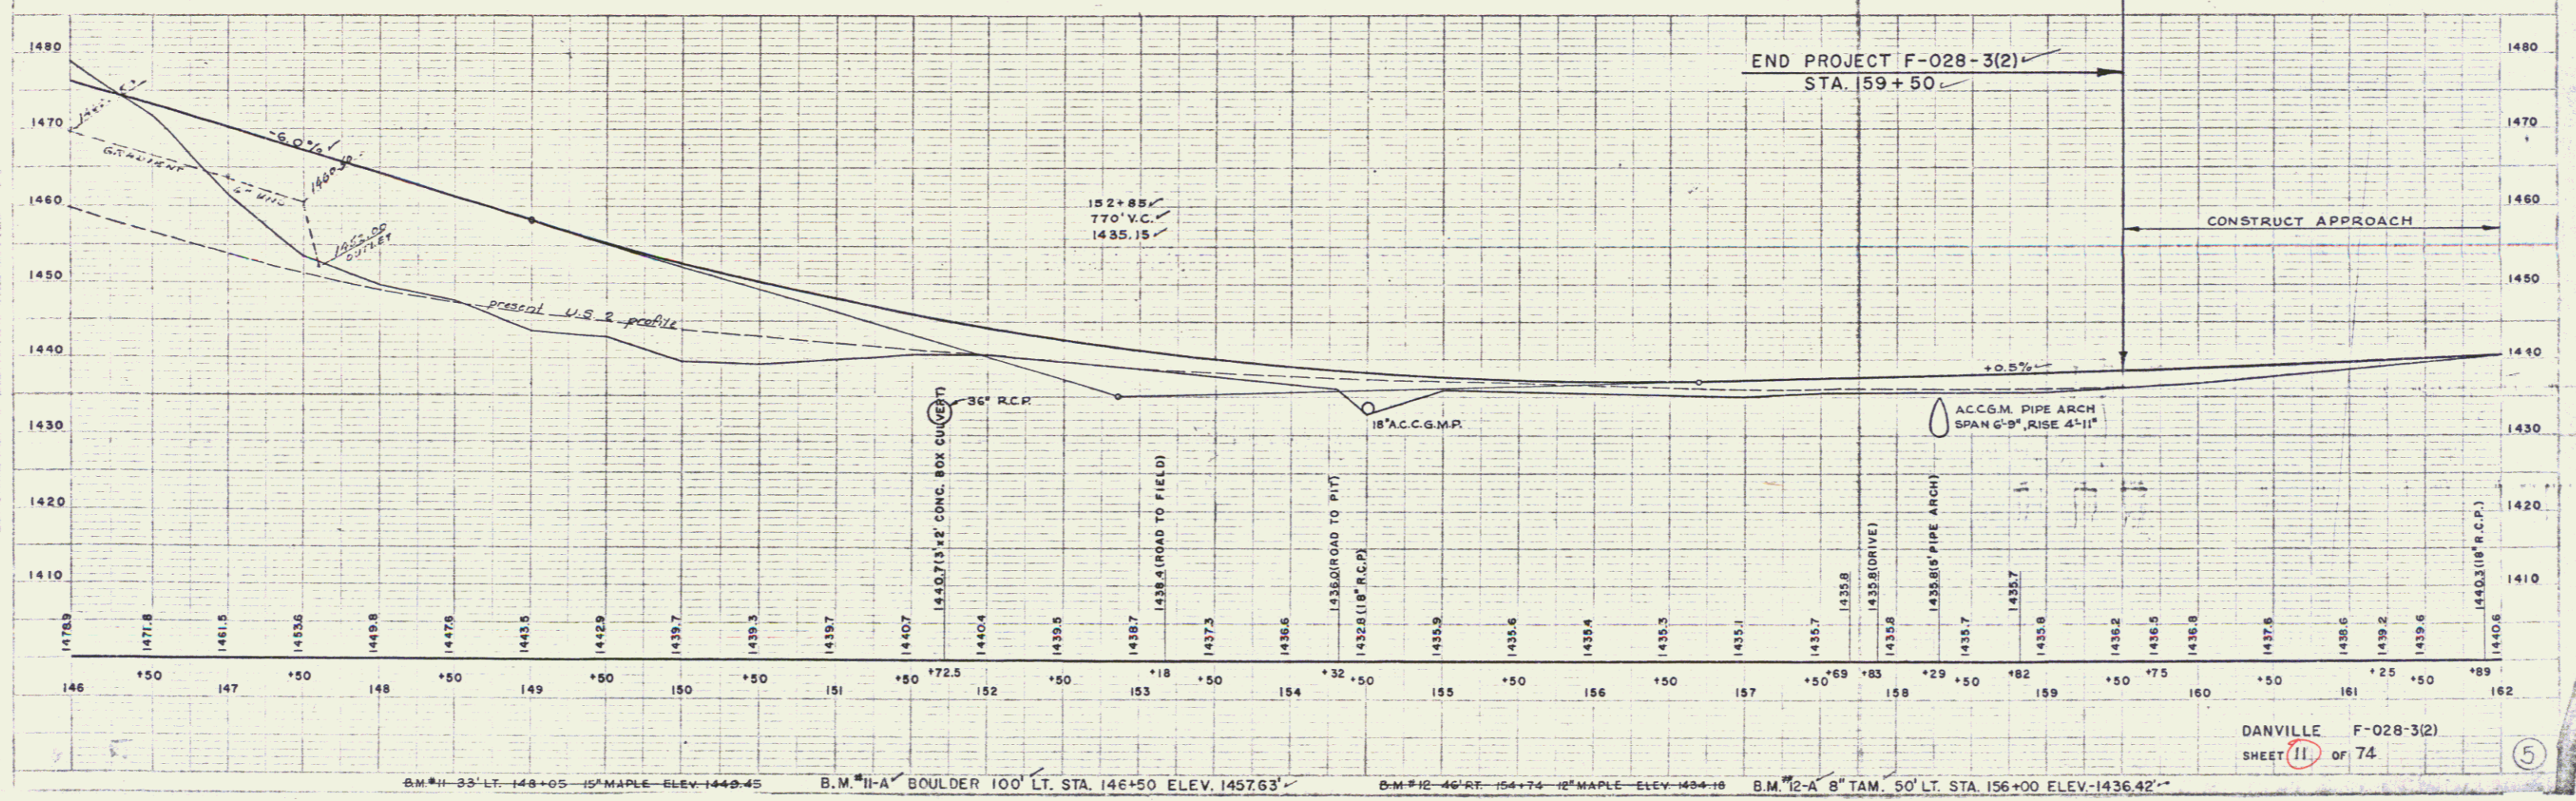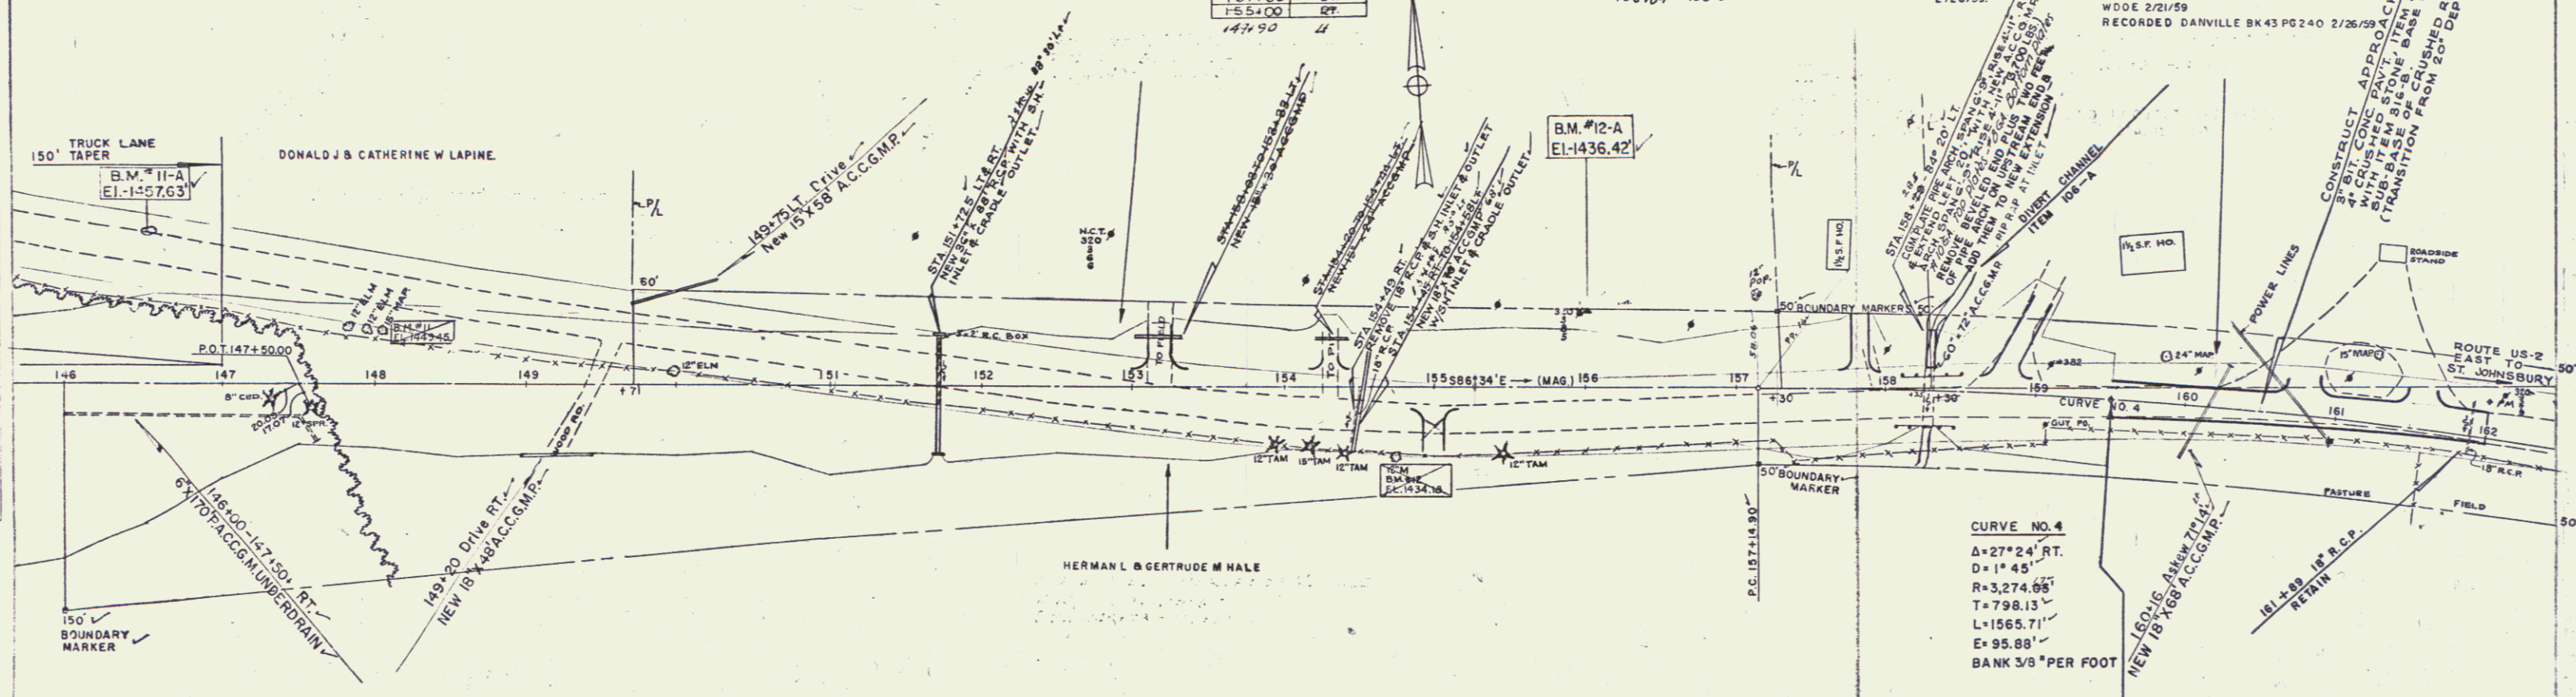

B.M. #11-33 LT. 146+05 - 12\"/>

8