

INDEX OF SHEETS

SHEET NO. 1	TITLE PAGE
2	TYPICAL CROSS-SECTION OF IMPROVEMENT (UNIMPROVED)
3	DETAILS OF CONSTRUCTION SHEET (UNIMPROVED)
4	20' PLAN AND PROFILE SHEET
5	STANDARD STRUCTURE SHEET 3-80 PIPE CULVERTS
6	STANDARD STRUCTURE SHEET 3-21 BOX CULVERTS
7	STANDARD STRUCTURE SHEET 3-22 GUARD RAIL - UNDERDRAIN
8	STANDARD STRUCTURE SHEET 3-23 CURB & GUTTER
9-27	CROSS SECTIONS

FED. ROAD DIST. NO.	STATE	FED. AID PROJ. NO.	SHEET NO.
8	VT.	P-26/231	1

**STATE OF VERMONT
STATE HIGHWAY DEPARTMENT**

**PLAN AND PROFILE OF PROPOSED
STATE HIGHWAY**

FEDERAL AID PROJECT


TOWN OF DANVILLE

Project # F R-26

MONTPELIER - ST. JOHNSBURY ROAD


FROM THE END OF F.A.P. 95-A IN DANVILLE VILLAGE
EAST 4.750 MILES TO THE ST. JOHNSBURY TOWN LINE

LENGTH OF PROJECT 25.0829 FT. = 4.750 MILES

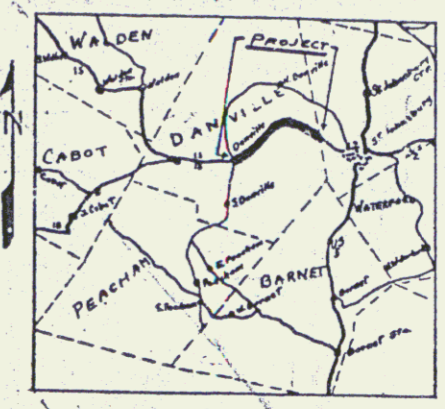

RECORD PLANS

SCALES:
PLAN 1 IN. = 50 FT.
VERTICAL 1 IN. = 10 FT.
HORIZONTAL 1 IN. = 50 FT.

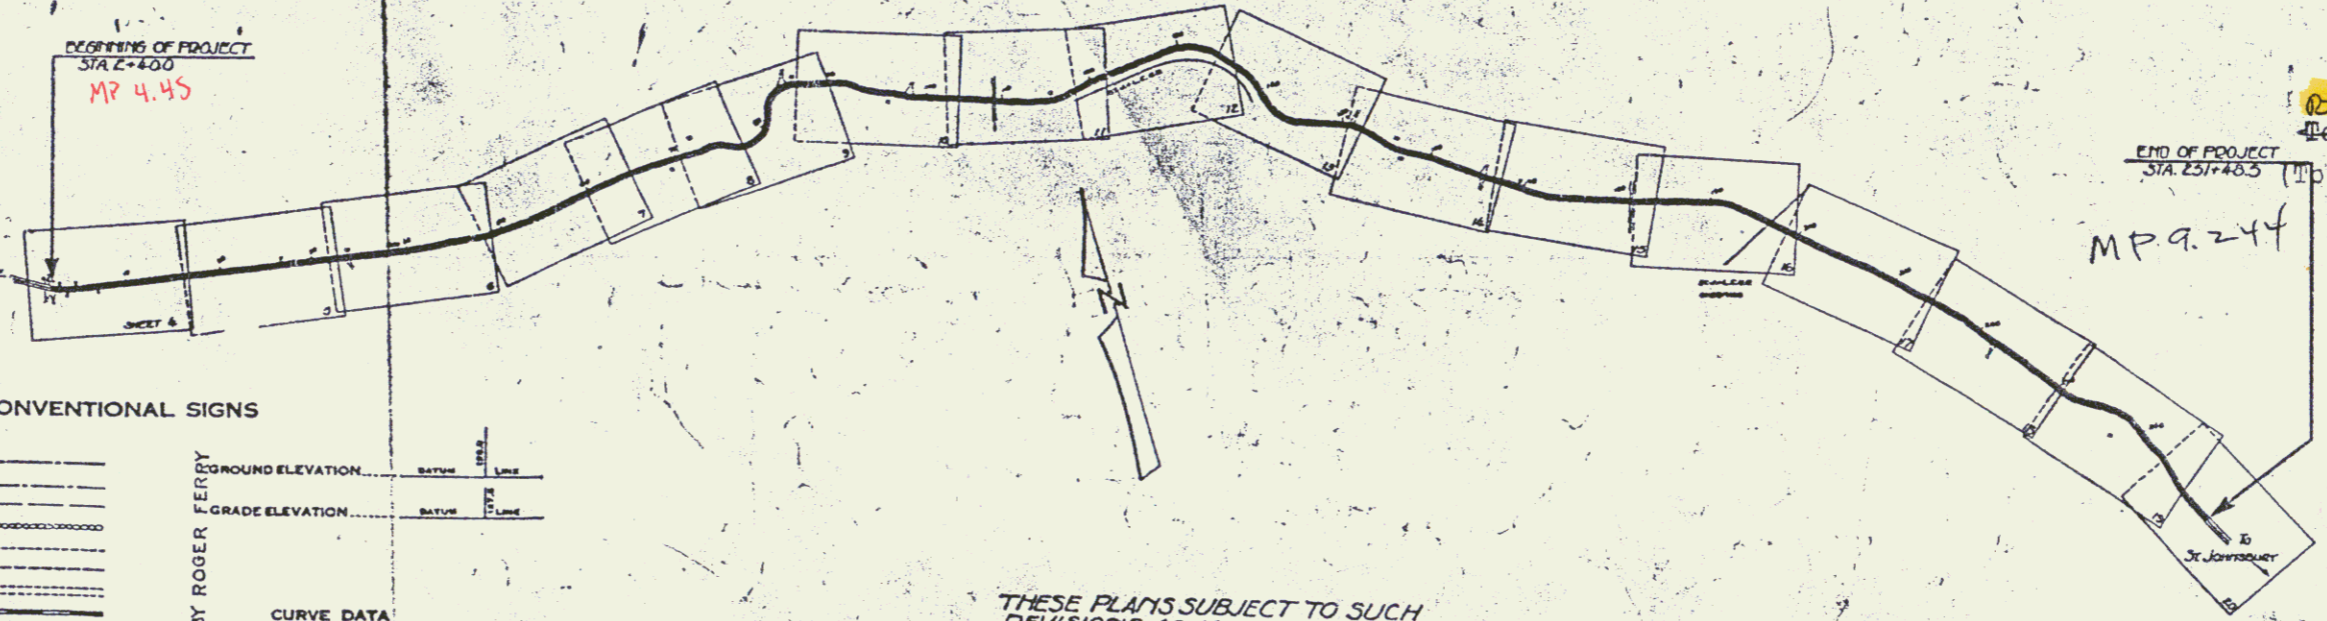

FOR ANY FURTHER INFORMATION CONCERNING PARTICULARITIES, AMOUNTS OR OTHER DETAILS RELATIVE TO THIS PROJECT MAY BE FOUND IN EITHER THE FIELD BOOKS OR THE ESTIMATE FILE.

RIGHT-OF-WAY DIVISION
TOWN FILE
PERPETUAL

END OF PROJECT STA. 251+48.5
Town of US 2
To Be Returned To R.O.W. Div

APPROVED May 7, 1931
R. J. Johnson
Commissioner of Highways
SUBMITTED BY ORDER OF THE STATE HIGHWAY DEPARTMENT

Pin # 99R133

RECOMMENDED [Signature]
DISTRICT ENGINEER BUREAU OF HIGHWAYS
RECOMMENDED FOR APPROVAL [Signature]
CHIEF ENGINEER BUREAU OF HIGHWAYS
APPROVED [Signature]
DIRECTOR - BUREAU OF HIGHWAYS

CONVENTIONAL SIGNS

COUNTY LINE	GROUND ELEVATION	DATE	LINE
TOWN LINE	GRADE ELEVATION	DATE	LINE
FENCE LINE			
STONE WALL			
UNFENCED PROPERTY			
GUARD RAIL			
TRAVELED WAY			
RAILROAD			
RETAINING WALL			
CENTER LINE			
SURVEY LINE			
CULVERT			
DROP INLET			
TROLLEY POLE			
POWER POLE			
TELEPHONE POLE			
TREE			
MEADOW			

CURVE DATA

DEFLECTION ANGLE	Δ
DEGREE OF CURVE	D
RADIUS OF CURVE	R
TANGENT DISTANCE	T
LENGTH OF CURVE	L
EXTERNAL DISTANCE	E
POINT OF INTERSECTION	P. I.
POINT OF CURVE	P. C.
POINT OF TANGENT	P. T.
POINT ON TANGENT	P. O. T.

DANVILLE 24-R
FORCE ACCOUNT
YEAR BUILT 1931
RECORD PLANS BY ROGER FERRY

THESE PLANS SUBJECT TO SUCH REVISIONS AS MAY BE REQUIRED BY THE BUREAU OF PUBLIC ROADS OR THE CHIEF ENGINEER.

ml 2/10/31

CORRECT MAY 7 1931
[Signature]
District Engineer
SERIES F. NO. 6
SHEET 1 OF 1