


BOTNAM 7/54
D. MACCHI

BOTNAM 7/54
D. MACCHI

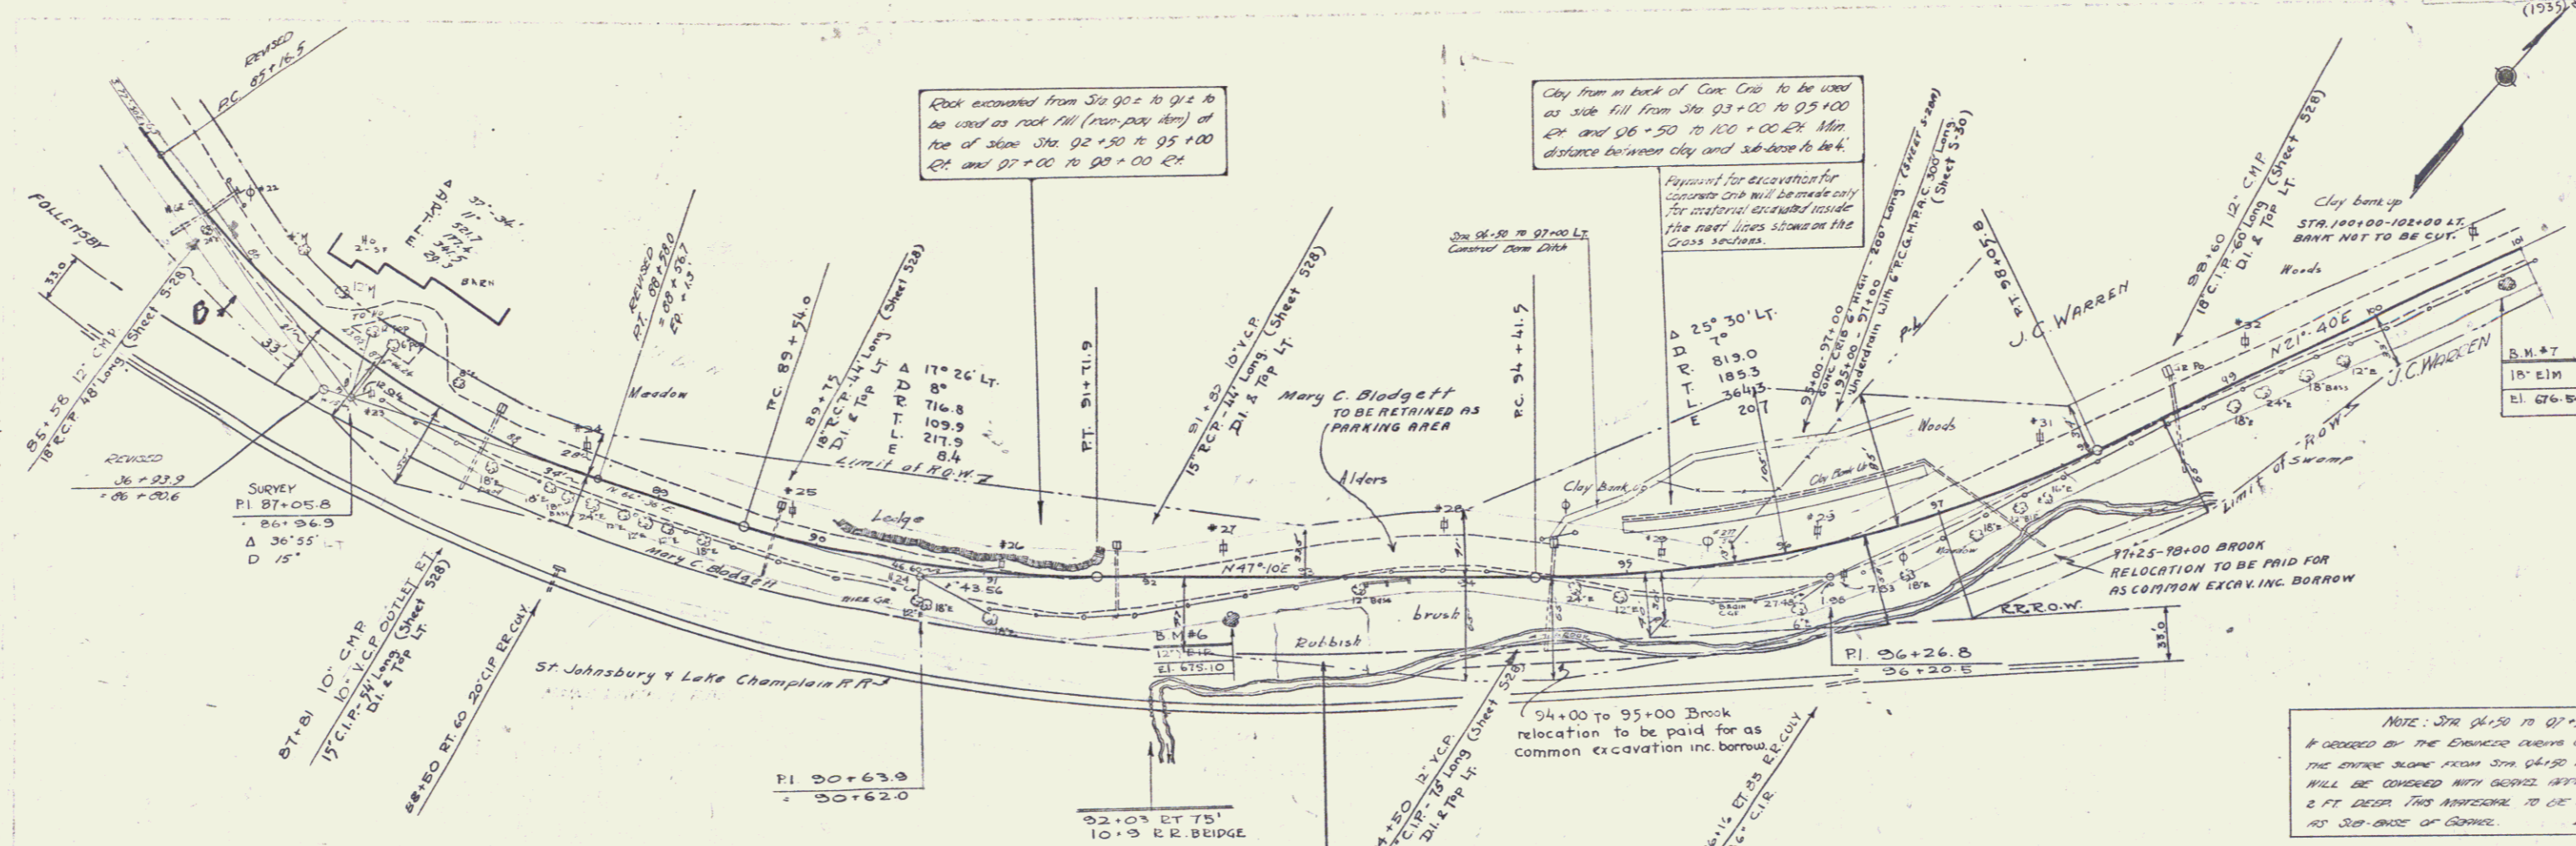

Dump pile to be cleaned out previous to construction of embankment. All refuse removed is to be washed and not used in construction of embankment. Owner of refuse to be paid for as Common Excavation including Dumps.

PARCEL	INSTRUMENT	DATE	GRANTOR	GRANTEE	RECORDED	REMARKS
A-D	G.C.O.	8-24-36	Maude Follenby	d'Al Staff.	78 367-70	7-26-36

