
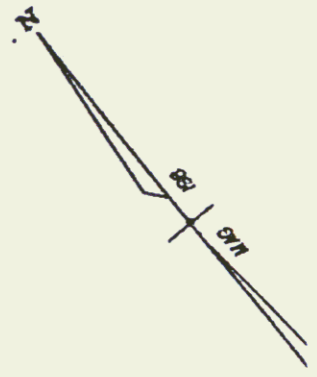
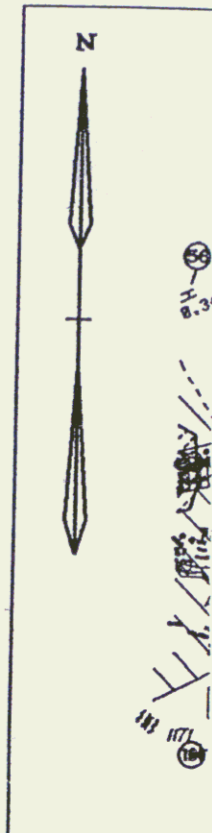


| NO. | QUANTITY | NO. | STATION | ENDING STATION | TAKING | REMARKS | RIGHTS | TITLE TAKEN | DATE | TOWN OR CITY RECORDED | BK. | PG. | REMARKS |
|-----|-------------------------|-----|--------------------------|--------------------------|--------|---------|------------------|-------------|------|-----------------------|-----|-----|---------------------------|
| 1A | AIME'S RESTAURANT, INC. | 1 | 153+28 LT. 154+76 LT. | 155+50 LT. 155+09 LT. | 0.04A± | | EXCEPT & RESERVE | MOOE | | ST. JOHNSBURY | | | 1545 S.F. ± SEWER LINE |
| B | | 1 | 153+76 RT. | 154+17 RT. | 0.01A± | | | | | | | | 650 S.F. ± |
| 2 | BISSON, JOHN & FLORENCE | 1 | 152+92 LT. | 153+34 LT. | 0.01A± | | | MOOE | | ST. JOHNSBURY | | | 84 S.F. ± |

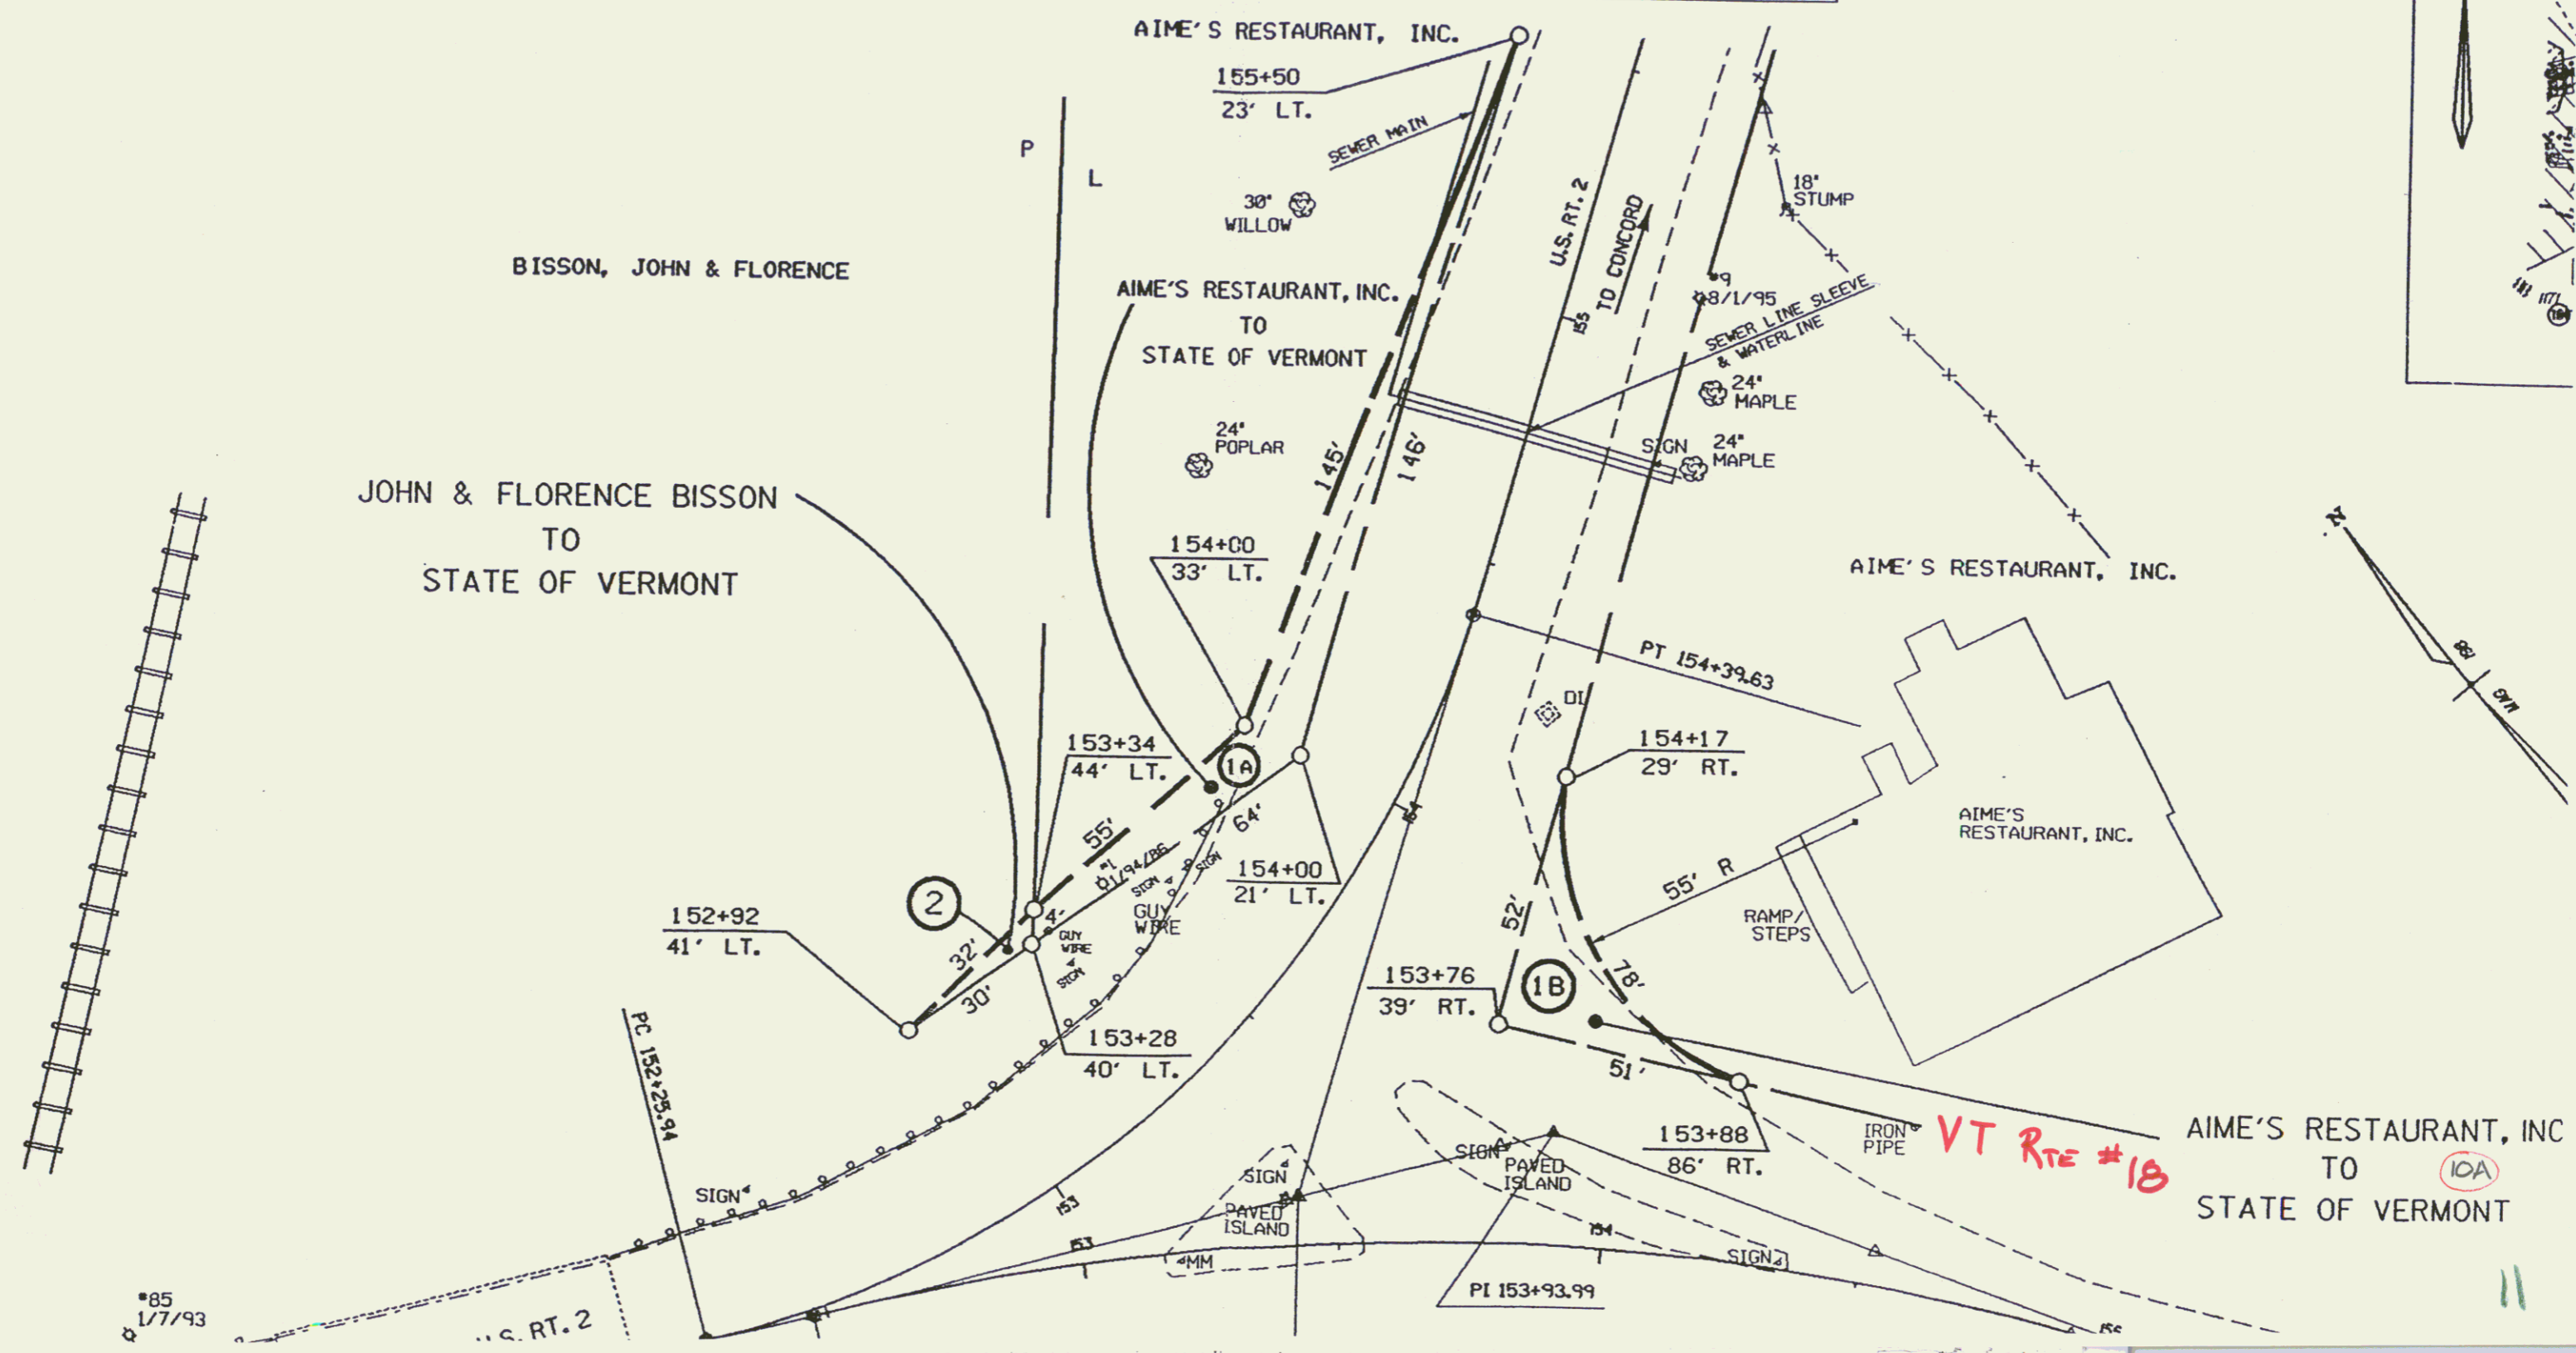

11