


PLAN
 DATE: 11/17/77
 DRAWN BY: [illegible]
 CHECKED BY: [illegible]
 IN CHARGE: [illegible]

PROFILE
 DATE: 11/17/77
 DRAWN BY: [illegible]
 CHECKED BY: [illegible]
 IN CHARGE: [illegible]

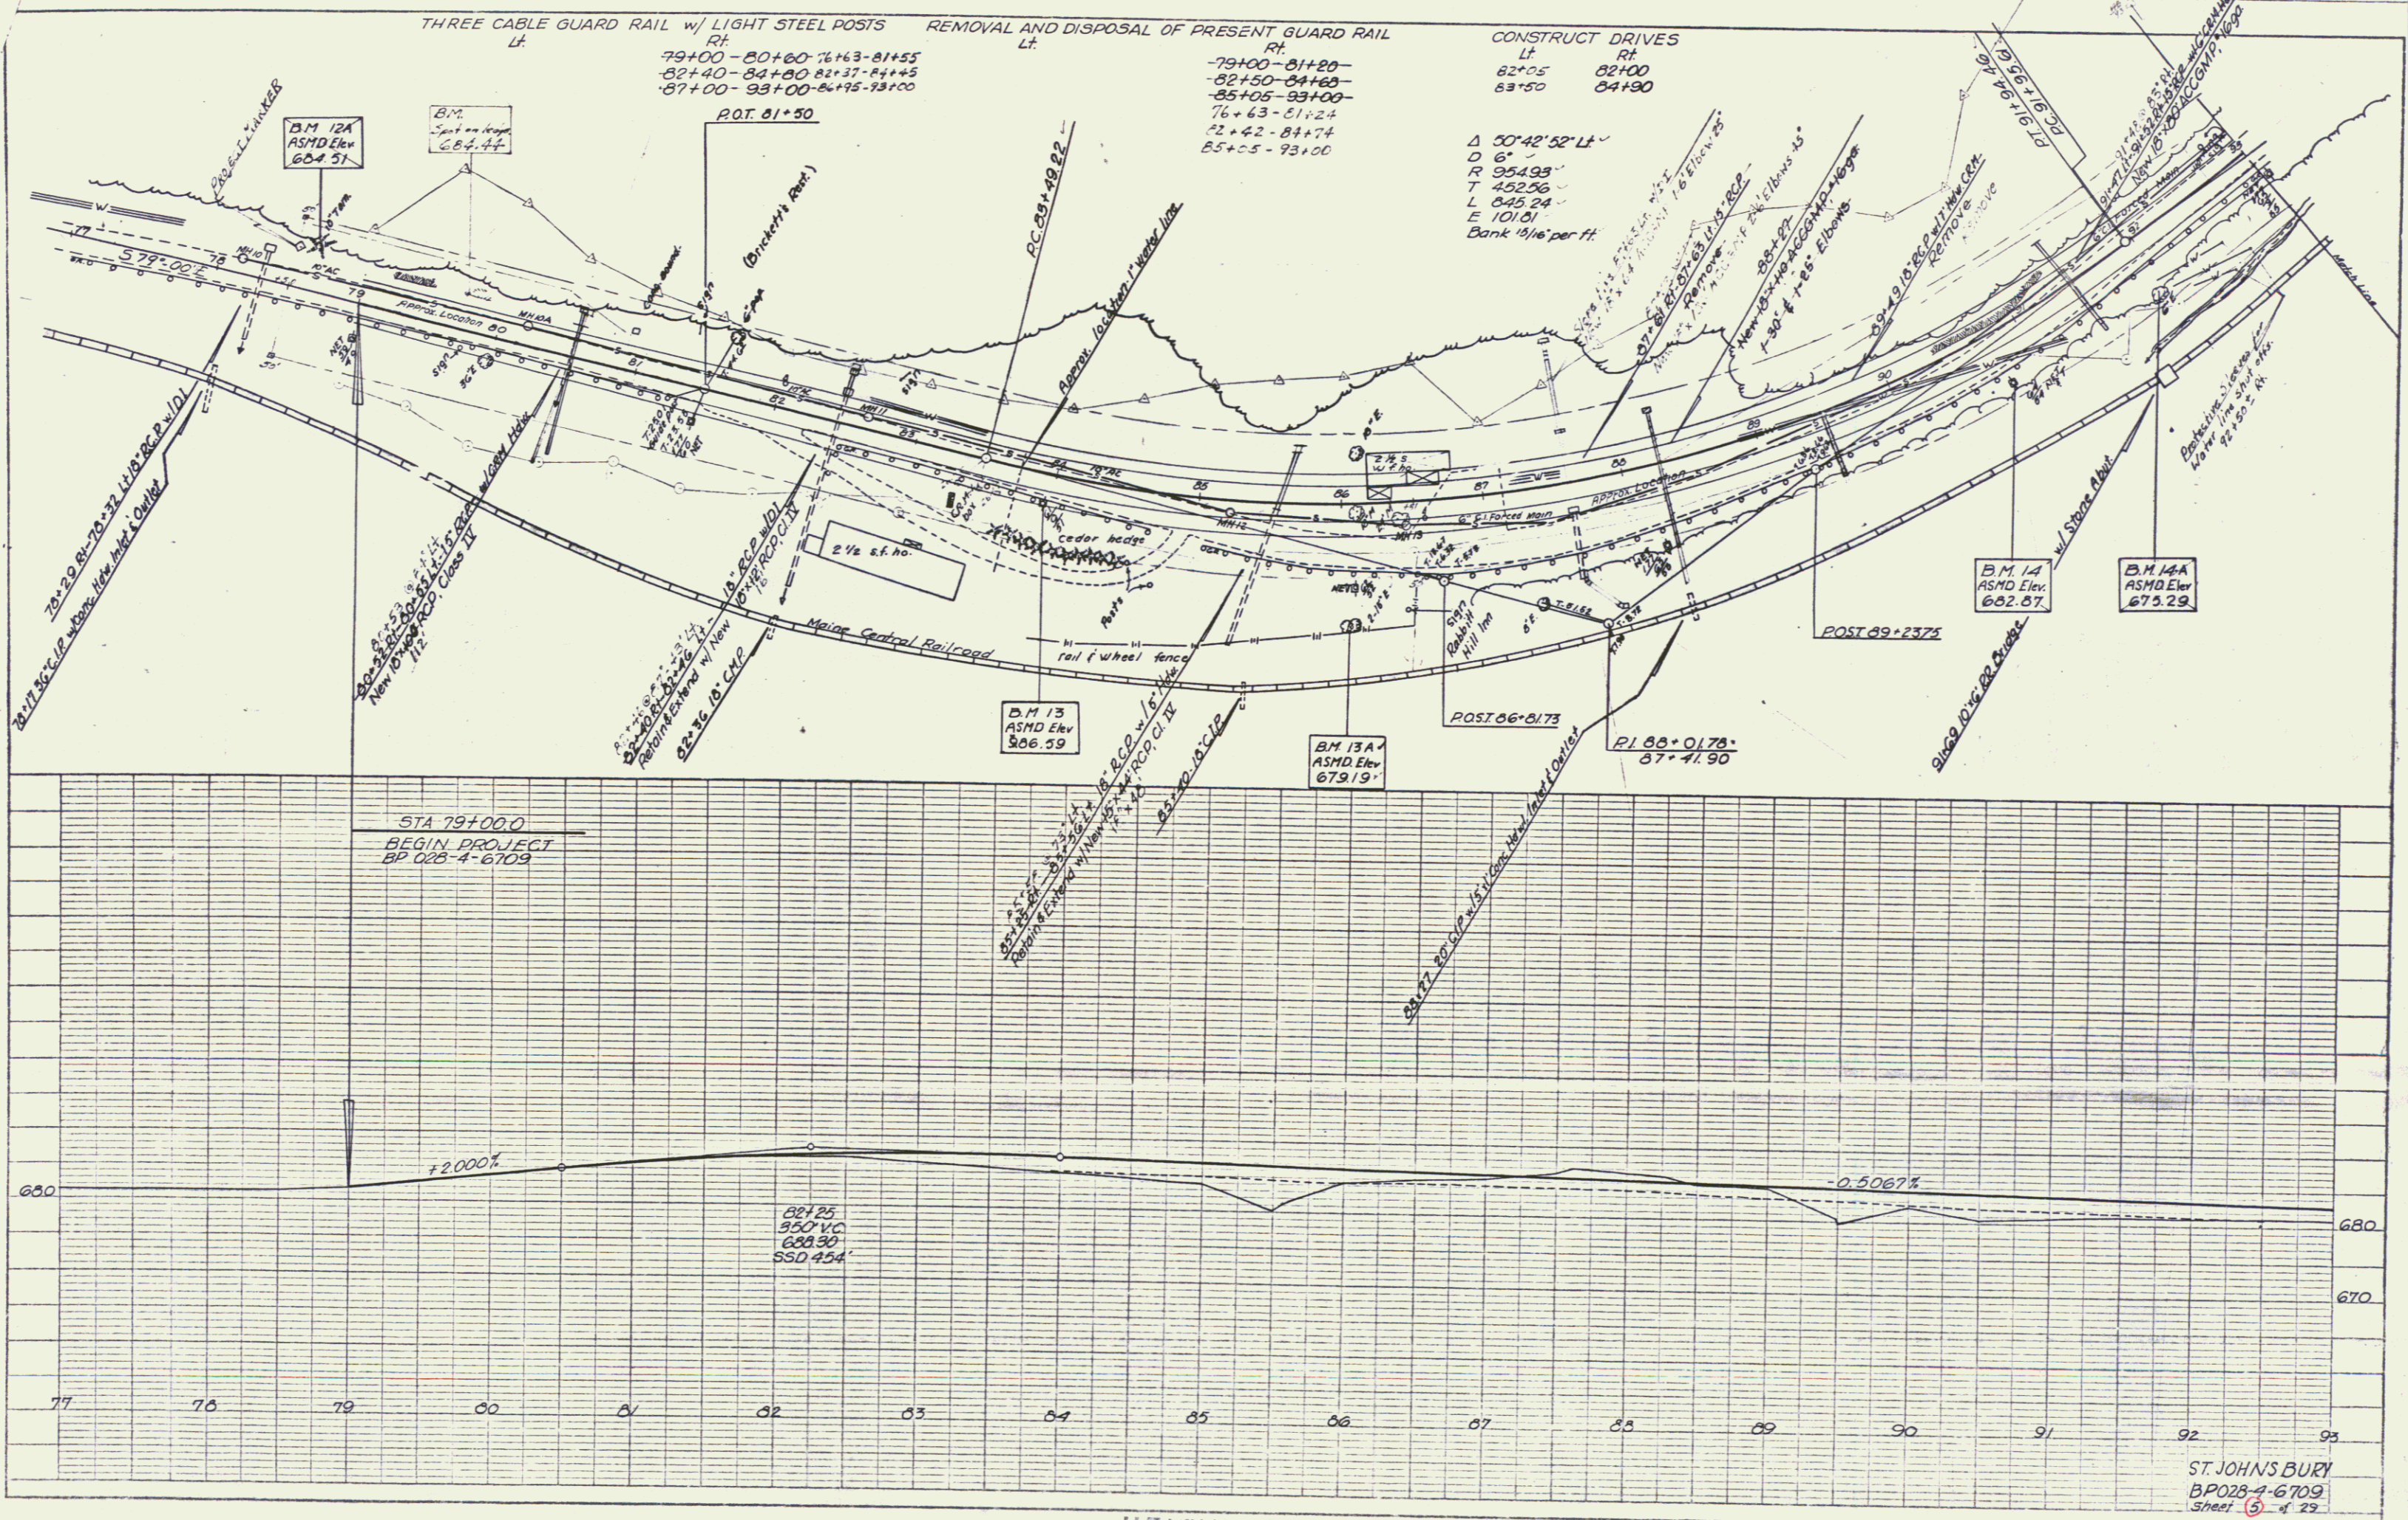

RE PLAN 1, PLAN PROFILE
 ADRIAN & TULLY CO.
 48 7012 IMPERIAL

ST. JOHNS BURY
 BP028-4-6709
 Sheet 5 of 29