


PARCEL	INSTRUMENT	DATE	GRANTOR	GRANTEE	RECORDED	REMARKS
A-1	Q.C.D.	5-20-35	C.H. SIMONS & M.R. GRIVES	J.T. JOHNSBURY	28 10-11	11-7-35
A-2	Q.C.D.	11-2-35	CHARLES J. WARK	J.T. JOHNSBURY	28 10-11	11-7-35

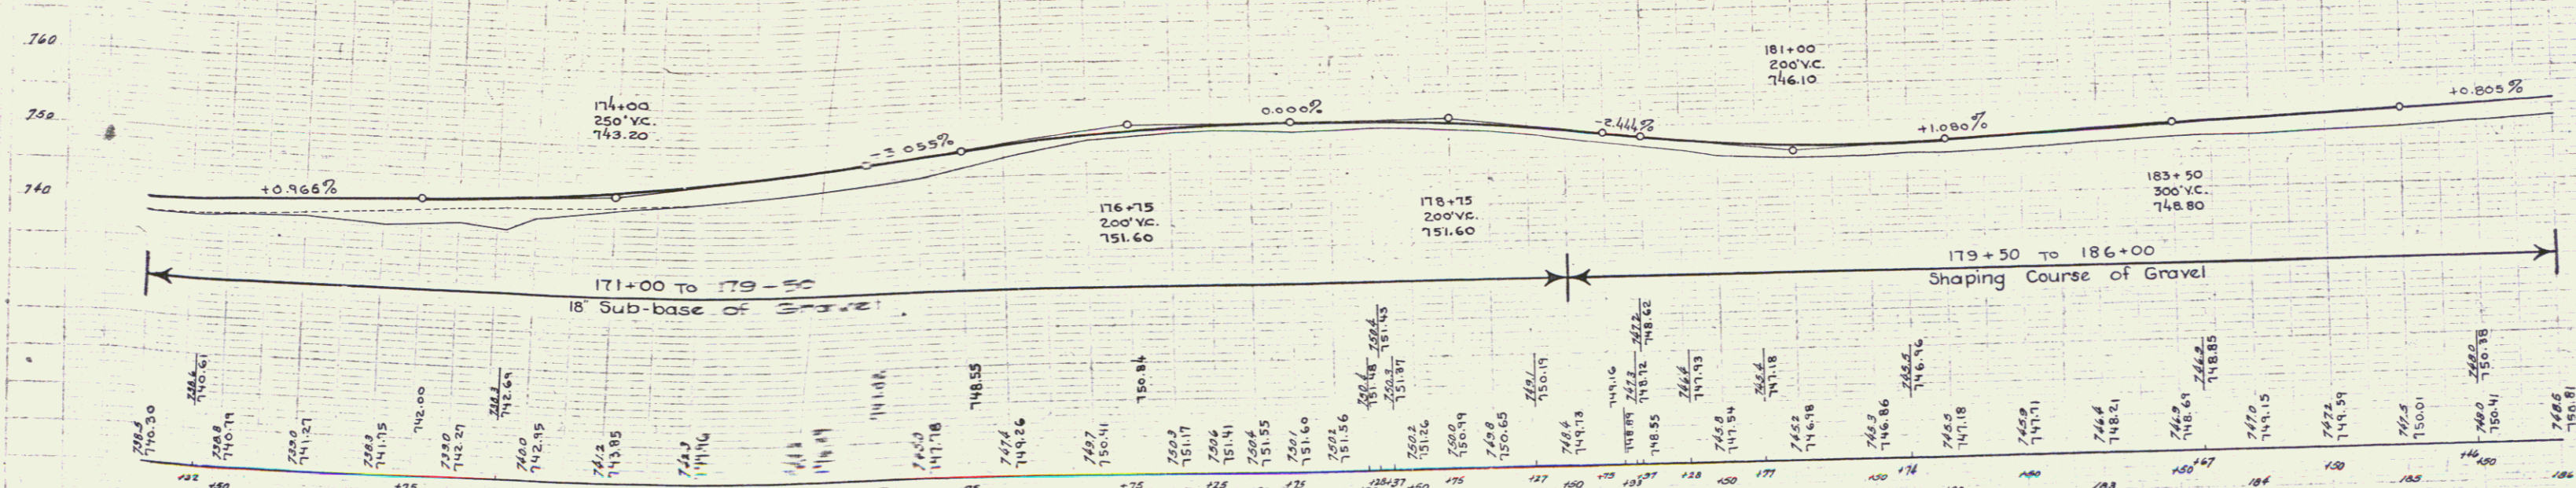

Station	Elevation
171+00	746.30
171+10	746.10
171+20	745.90
171+30	745.70
171+40	745.50
171+50	745.30
171+60	745.10
171+70	744.90
171+80	744.70
171+90	744.50
172+00	744.30
172+10	744.10
172+20	743.90
172+30	743.70
172+40	743.50
172+50	743.30
172+60	743.10
172+70	742.90
172+80	742.70
172+90	742.50
173+00	742.30
173+10	742.10
173+20	741.90
173+30	741.70
173+40	741.50
173+50	741.30
173+60	741.10
173+70	740.90
173+80	740.70
173+90	740.50
174+00	740.30
174+10	740.10
174+20	739.90
174+30	739.70
174+40	739.50
174+50	739.30
174+60	739.10
174+70	738.90
174+80	738.70
174+90	738.50
175+00	738.30
175+10	738.10
175+20	737.90
175+30	737.70
175+40	737.50
175+50	737.30
175+60	737.10
175+70	736.90
175+80	736.70
175+90	736.50
176+00	736.30
176+10	736.10
176+20	735.90
176+30	735.70
176+40	735.50
176+50	735.30
176+60	735.10
176+70	734.90
176+80	734.70
176+90	734.50
177+00	734.30
177+10	734.10
177+20	733.90
177+30	733.70
177+40	733.50
177+50	733.30
177+60	733.10
177+70	732.90
177+80	732.70
177+90	732.50
178+00	732.30
178+10	732.10
178+20	731.90
178+30	731.70
178+40	731.50
178+50	731.30
178+60	731.10
178+70	730.90
178+80	730.70
178+90	730.50
179+00	730.30
179+10	730.10
179+20	729.90
179+30	729.70
179+40	729.50
179+50	729.30
179+60	729.10
179+70	728.90
179+80	728.70
179+90	728.50
180+00	728.30
180+10	728.10
180+20	727.90
180+30	727.70
180+40	727.50
180+50	727.30
180+60	727.10
180+70	726.90
180+80	726.70
180+90	726.50
181+00	726.30
181+10	726.10
181+20	725.90
181+30	725.70
181+40	725.50
181+50	725.30
181+60	725.10
181+70	724.90
181+80	724.70
181+90	724.50
182+00	724.30
182+10	724.10
182+20	723.90
182+30	723.70
182+40	723.50
182+50	723.30
182+60	723.10
182+70	722.90
182+80	722.70
182+90	722.50
183+00	722.30
183+10	722.10
183+20	721.90
183+30	721.70
183+40	721.50
183+50	721.30
183+60	721.10
183+70	720.90
183+80	720.70
183+90	720.50
184+00	720.30
184+10	720.10
184+20	719.90
184+30	719.70
184+40	719.50
184+50	719.30
184+60	719.10
184+70	718.90
184+80	718.70
184+90	718.50
185+00	718.30
185+10	718.10
185+20	717.90
185+30	717.70
185+40	717.50
185+50	717.30
185+60	717.10
185+70	716.90
185+80	716.70
185+90	716.50
186+00	716.30

B.M. 16 SPIKE IN ROOT OF 6" POPULAR 33 FT. RT. STA. 174+75 ELEV. 741.50
B.M. 17 20" POPULAR 23 FT. LT. STA. 175+71 ELEV. 743.71