

WOOD GUARD RAIL REQUIRED

CHY. STA.	LEFT	RIGHT
92+74	24'	24'

CURB GUARD RAIL REQUIRED

STA. TO STA.	LEN. LENS. COST DAY LENS.
94+00 - 94+10	L 4.9 20' 68"
94+00 - 94+40	R 4.9 20' 68"
95+04 - 95+02	L 4.8 20' 68"
95+04 - 95+22	R 4.8 20' 68"

NEW CONCRETE GULLY METAL DRAINAGE PITS REQUIRED


STATION	DIAM.	LENS.	CEMENT PLANK MOUNT
95+50 LT	15"	22"	2.7 C.Y.

NEW COST IRON PIPE CULVERTS REQUIRED

STATION	DIAM.	LENS.	CURB CONV. POINTS	PIPING
92+74	18"	53'	1.5 C.Y.	1.5 C.Y.

131-A 1900 20


C. E. WOOD

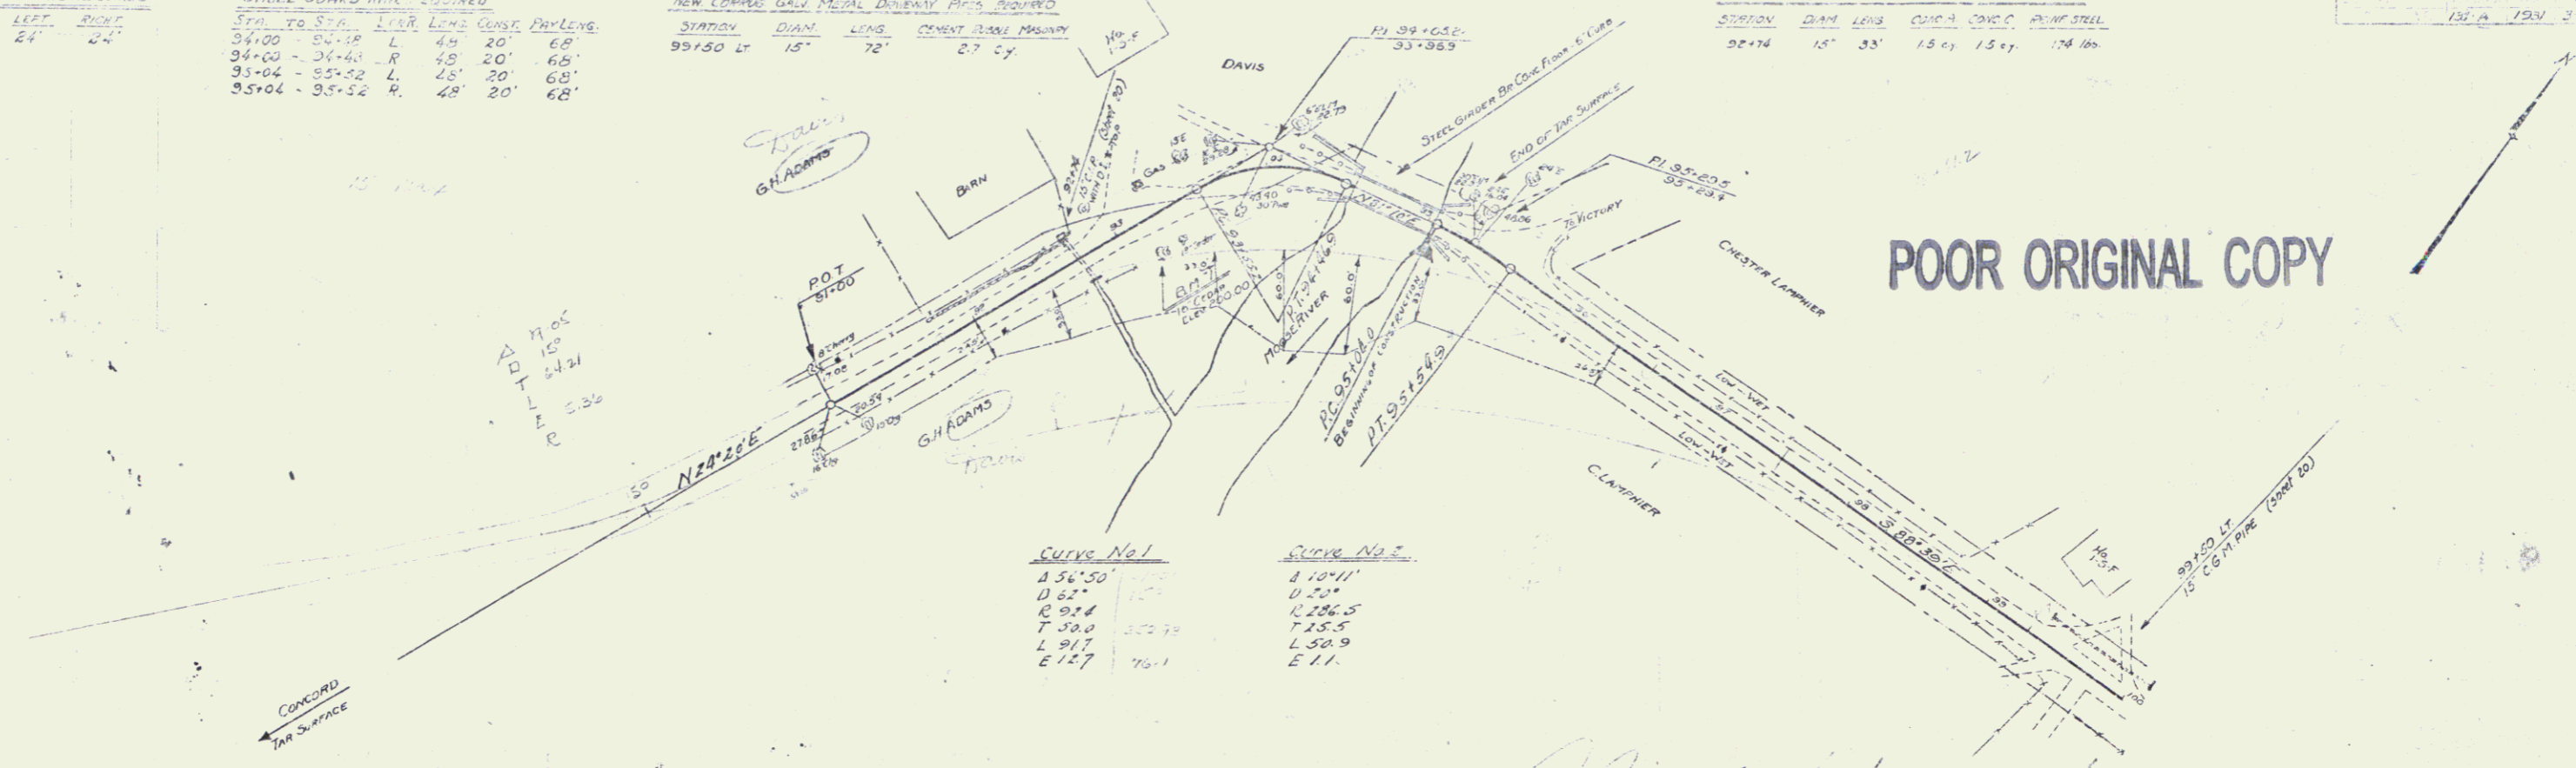

POOR ORIGINAL COPY

Curve No. 1		Curve No. 2	
A	361.50	A	410.11
B	11.51	B	11.51
R	92.4	R	428.5
T	50.0	T	125.5
L	91.7	L	150.9
E	127	E	111

Not Used

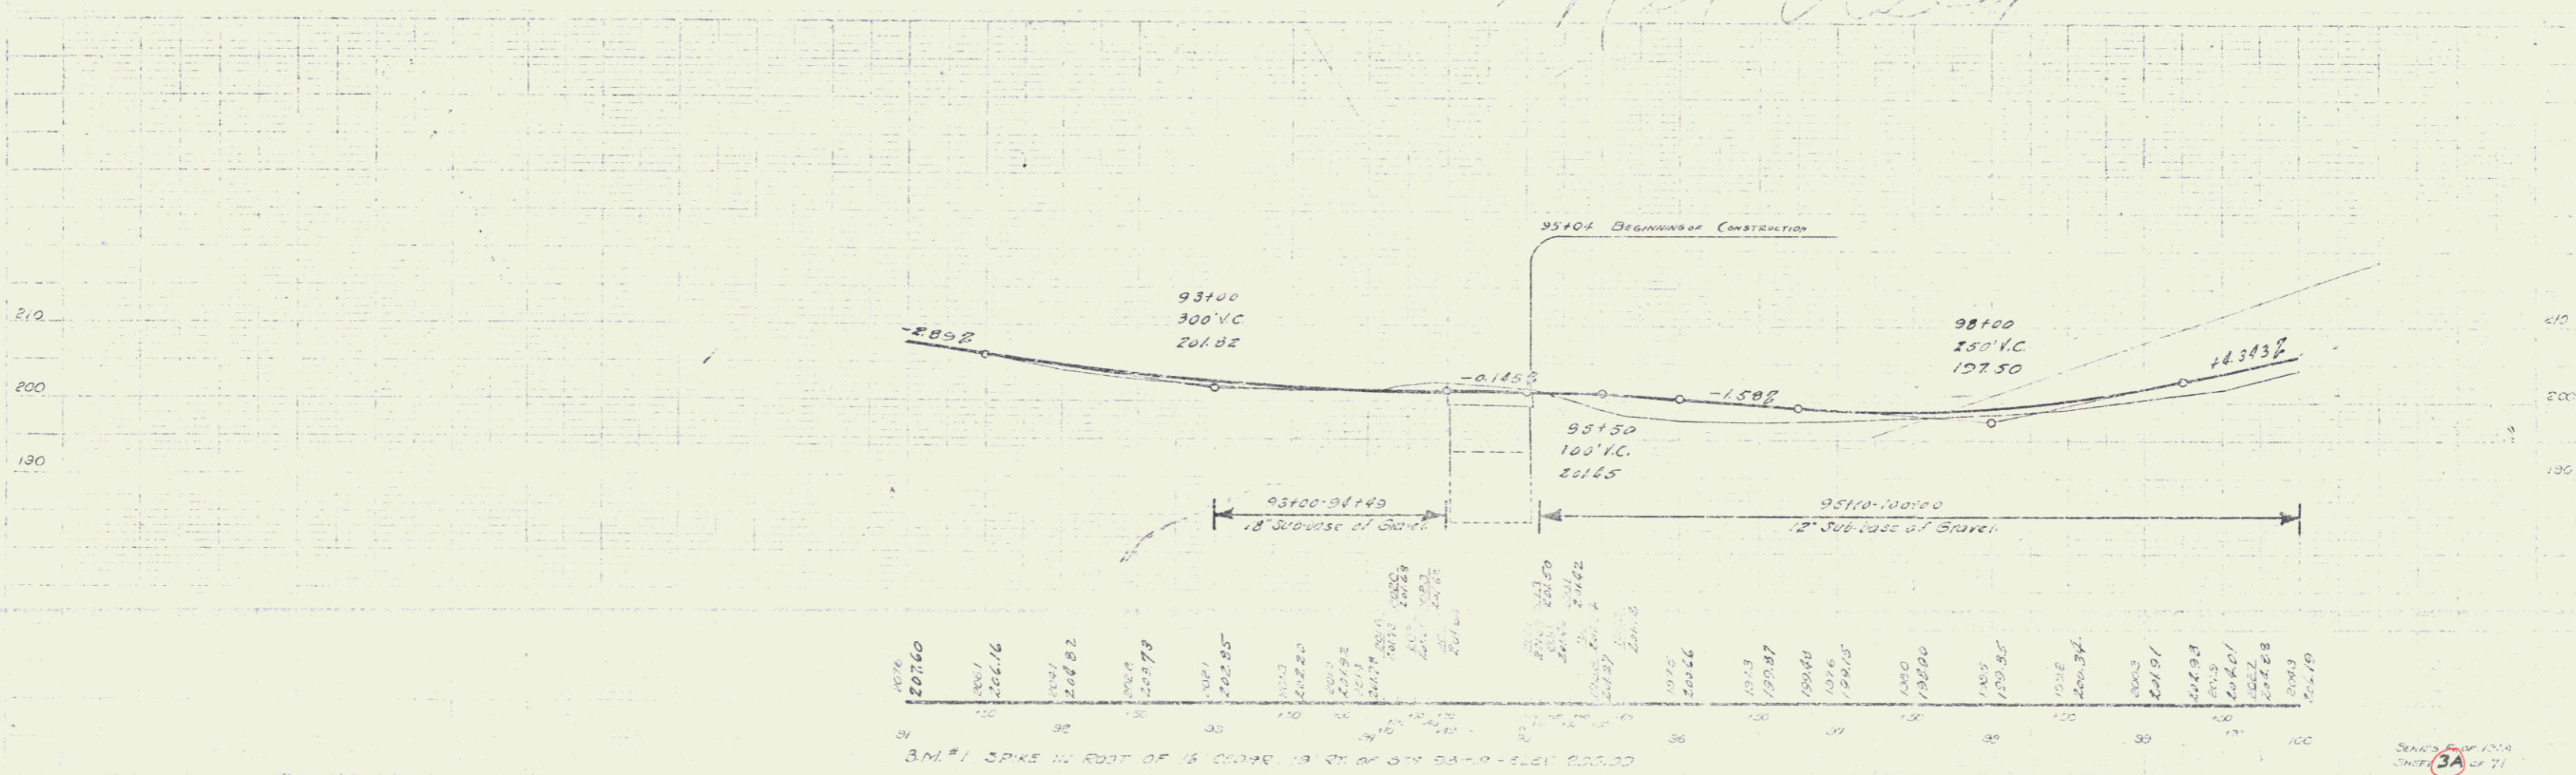

SERIES 3A OF 71