

WOOD GUARD RAIL REQUIRED

CURVE STA.	LEFT	RIGHT
158+88	24'	24'
165+30	24'	24'
169+50	24'	24'



NEW CAST IRON PIPE CURBSETS REQUIRED

STATION	DIAM.	LENG.	CURB	CONC. RAMP	STEEL
158+88	15"	36"	-	3.0 x 7	10 lbs.
165+30	18"	45"	1.8 x 7	-	75 lbs.
169+50	18"	36"	1.8 x 7	-	34 lbs.

NEW CEMENT GRAY METAL DRIVEWAY PIPS REQUIRED

STATION	DIAM.	LENG.	CEMENT	ROBUST	MASONRY
160+35	15"	20"	-	2.7	2.7

Parcel	Kind of Instrument	Date of Instrument	Grantor	Grantee	Recorded Concord	Remarks
1	G.C.D.	7-30-51	Martha D. Ladd	State	22 379	10-6-51
A	"	7-30-51	Flora E. Robbins	"	22 391	10-6-51

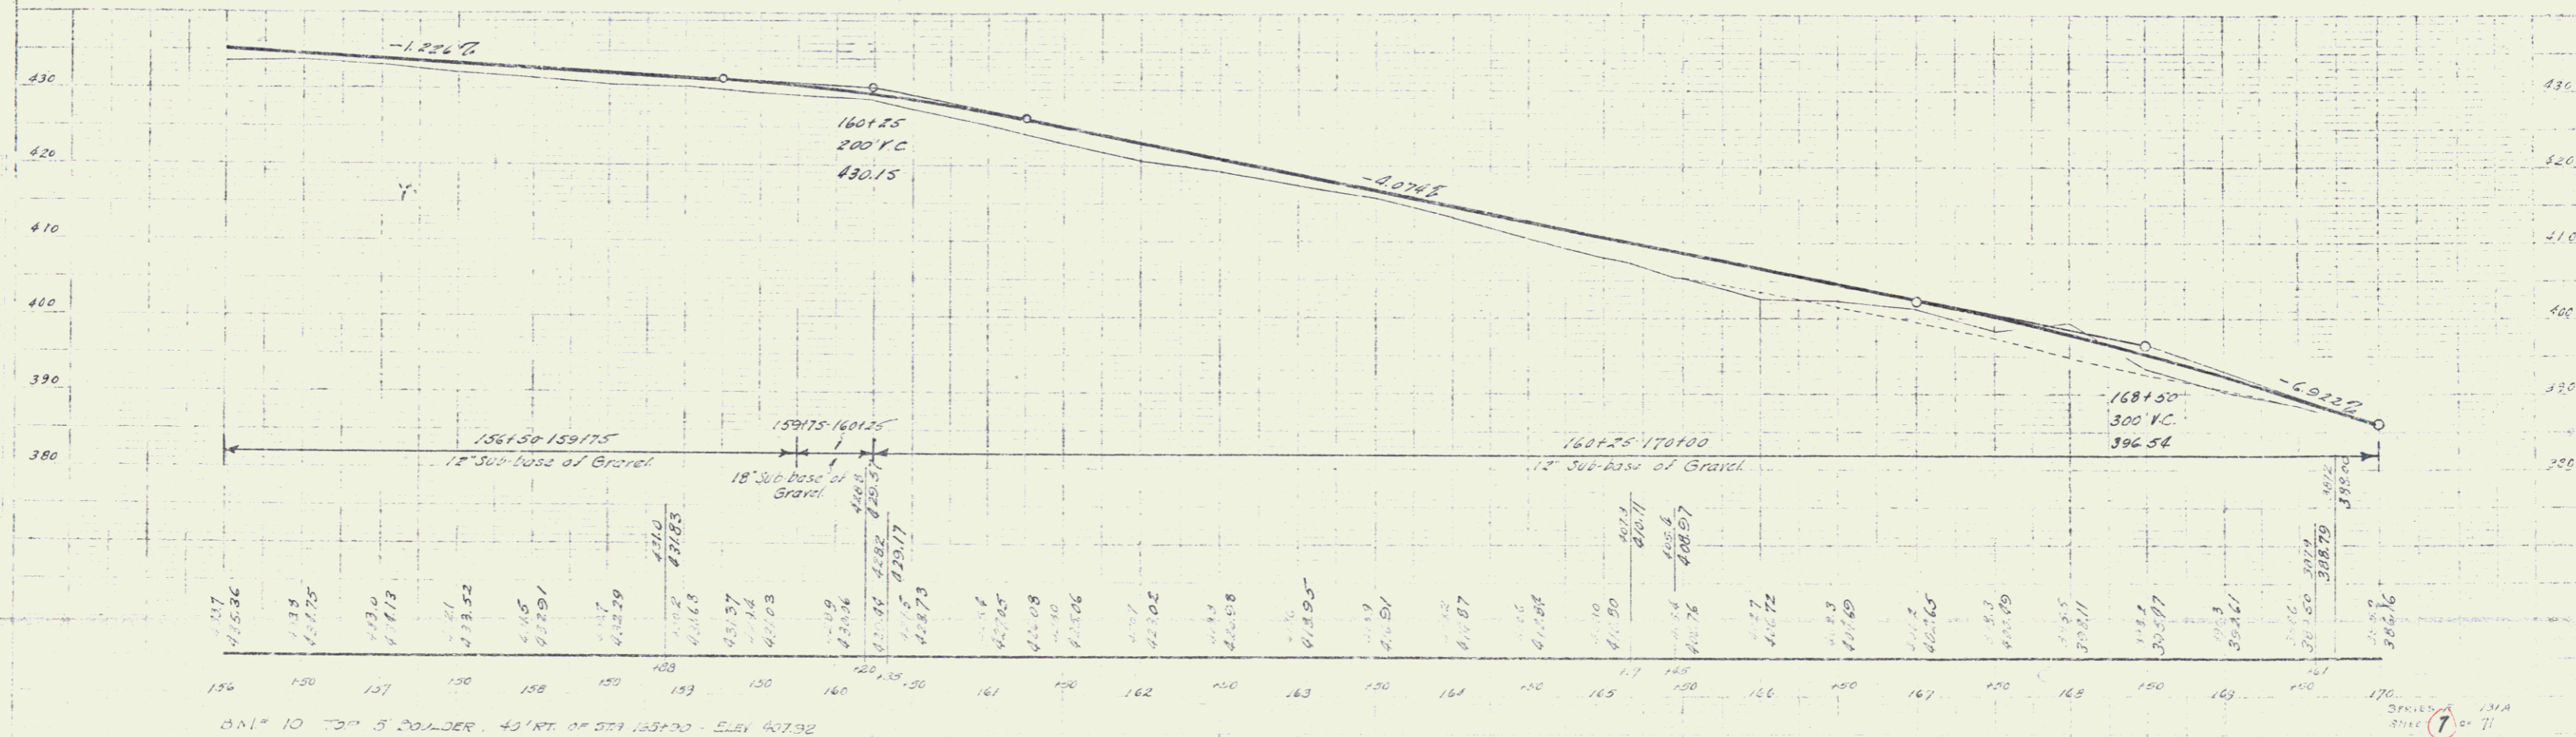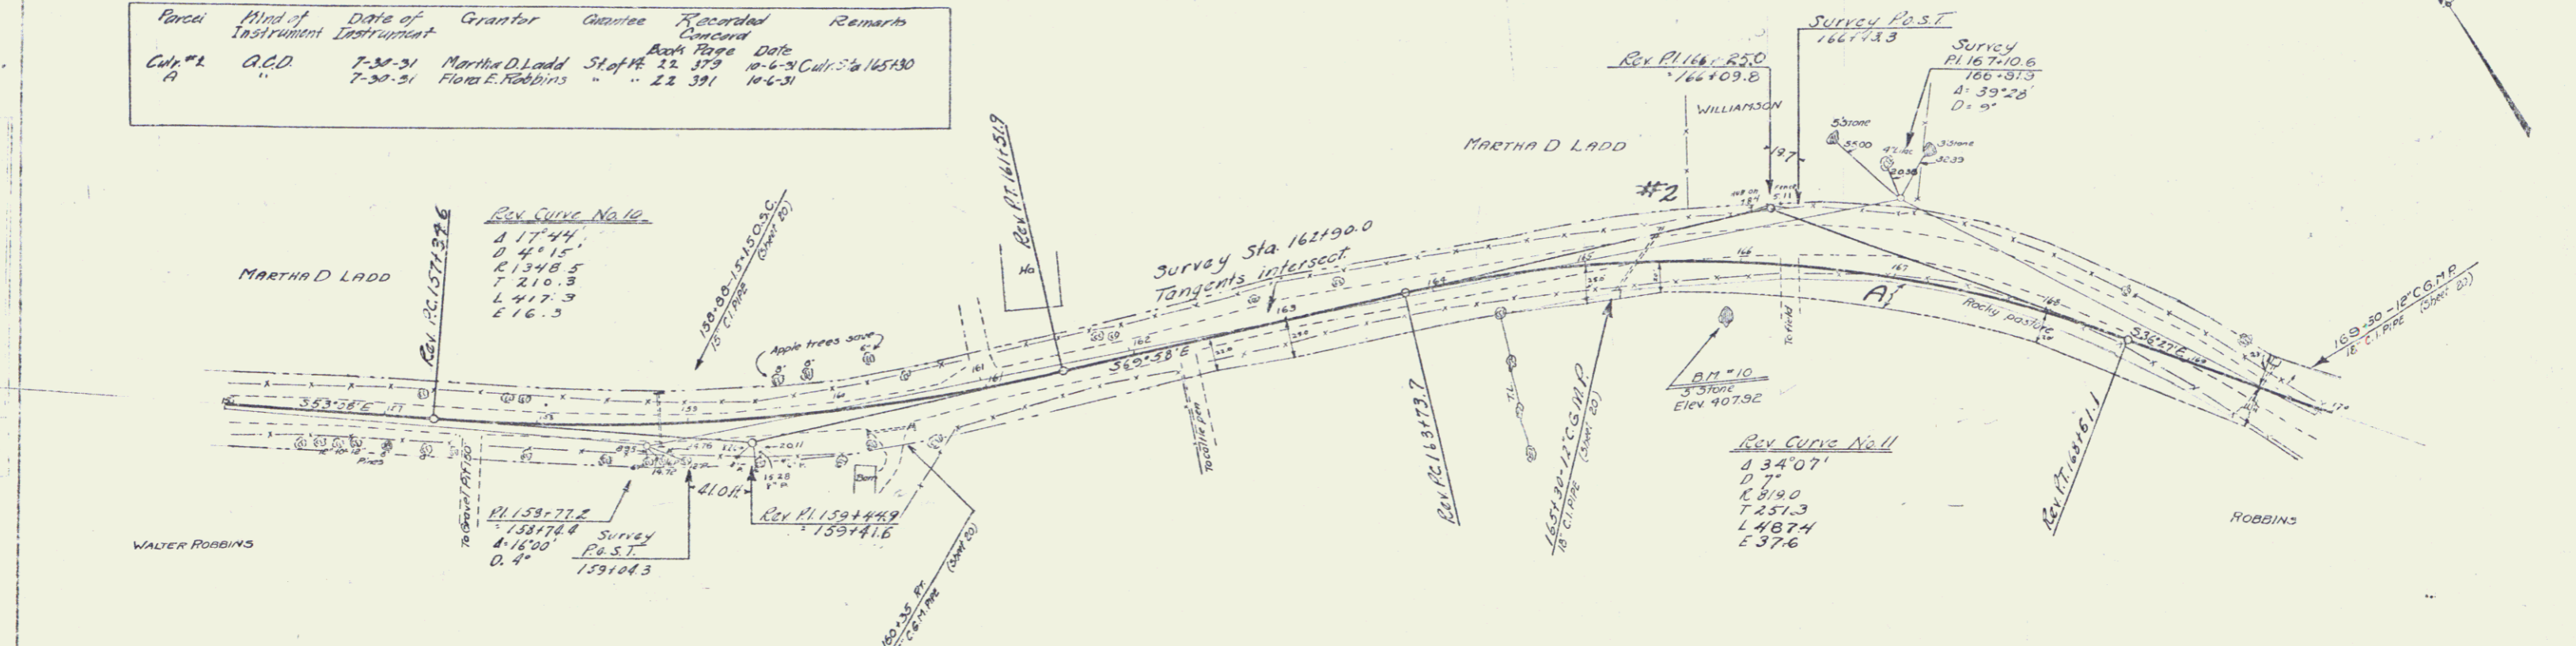

C.C. Robbins 5-21

C.C. Robbins 5-21