

**WOOD GUARD RAIL REQUIRED**

GAUGE STA	LEFT RIGHT
186+76	24' 24'
192+77	24'
198+66	24'

**CABLE GUARD RAIL REQUIRED**


STATIONS	LENG	COST	TOTALS
192+20 193+00	72' 40'	112'	

**NEW CAST IRON PIPE SUPPORTS REQUIRED**


STATION	DIAM	LENG	COST	CHC	POSTS
186+76	18"	35'	2.67	-	109 lbs
192+77	15"	42'	-	1.57	17 lbs
198+66	15"	35'	-	1.57	17 lbs

13-A 193 2 71

THEDA L. RICHARDSON

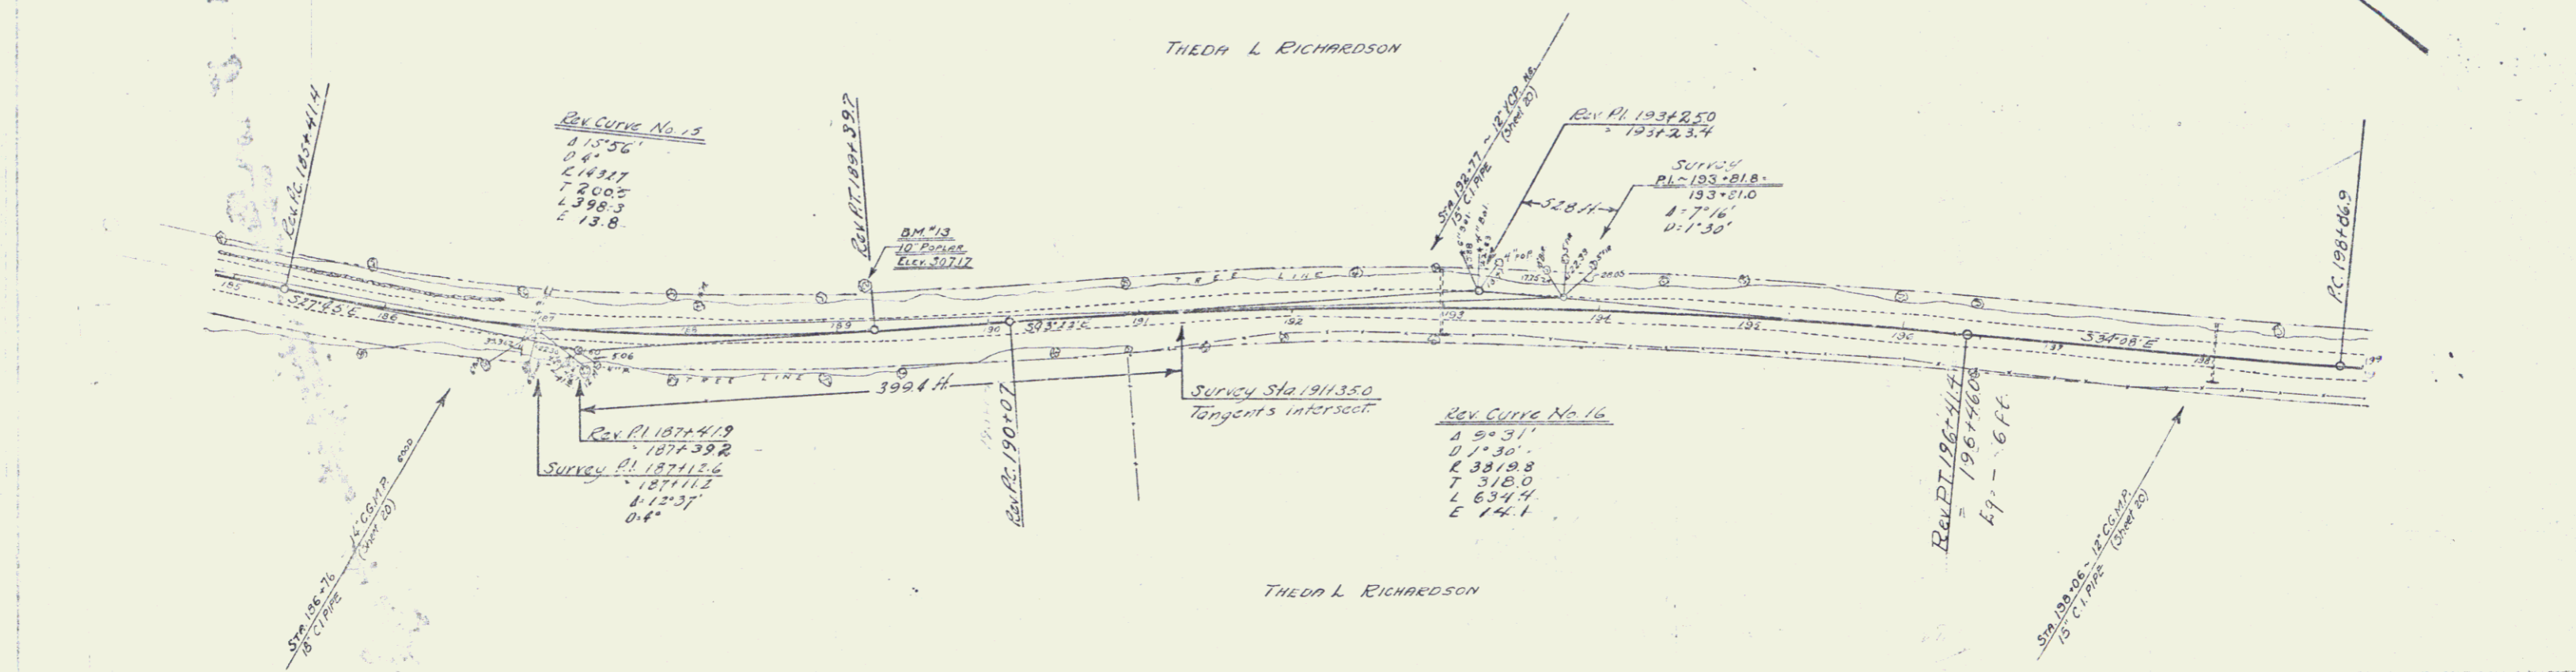

THEDA L. RICHARDSON

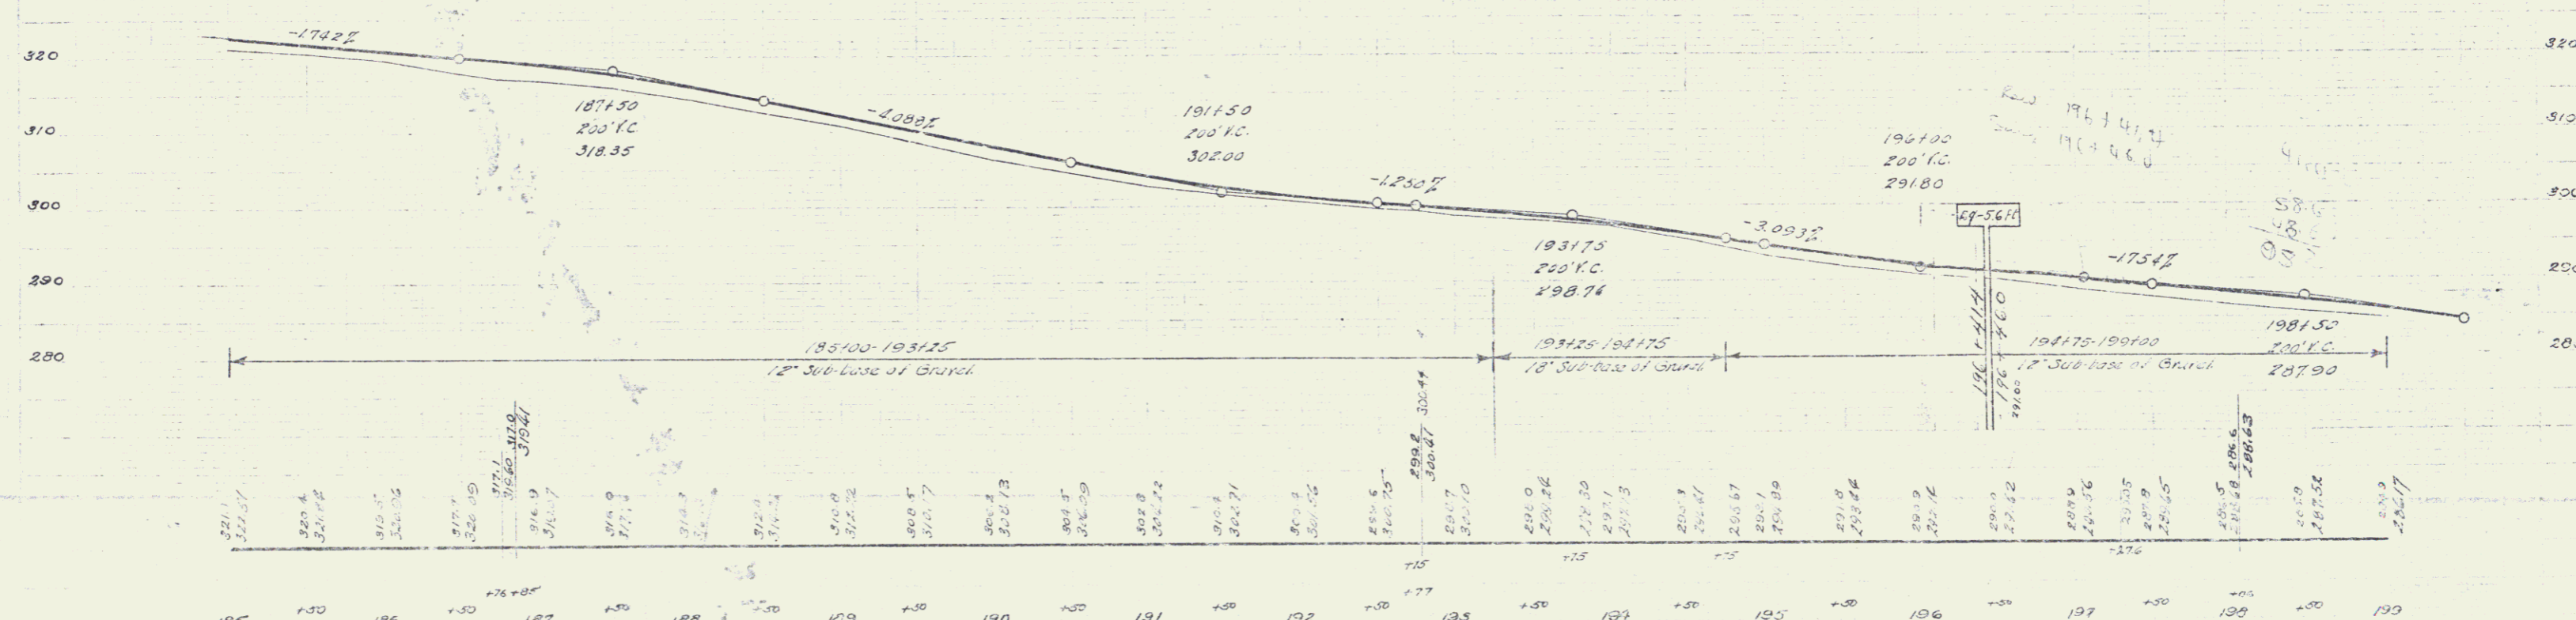

P.M. 13 SPIKE IN ROOT OF 12" PIP. 25' LT. OF STR. 189+31 - ELEV. 307.17

Series P No. 1310  
Sheet 9 of 11

9