
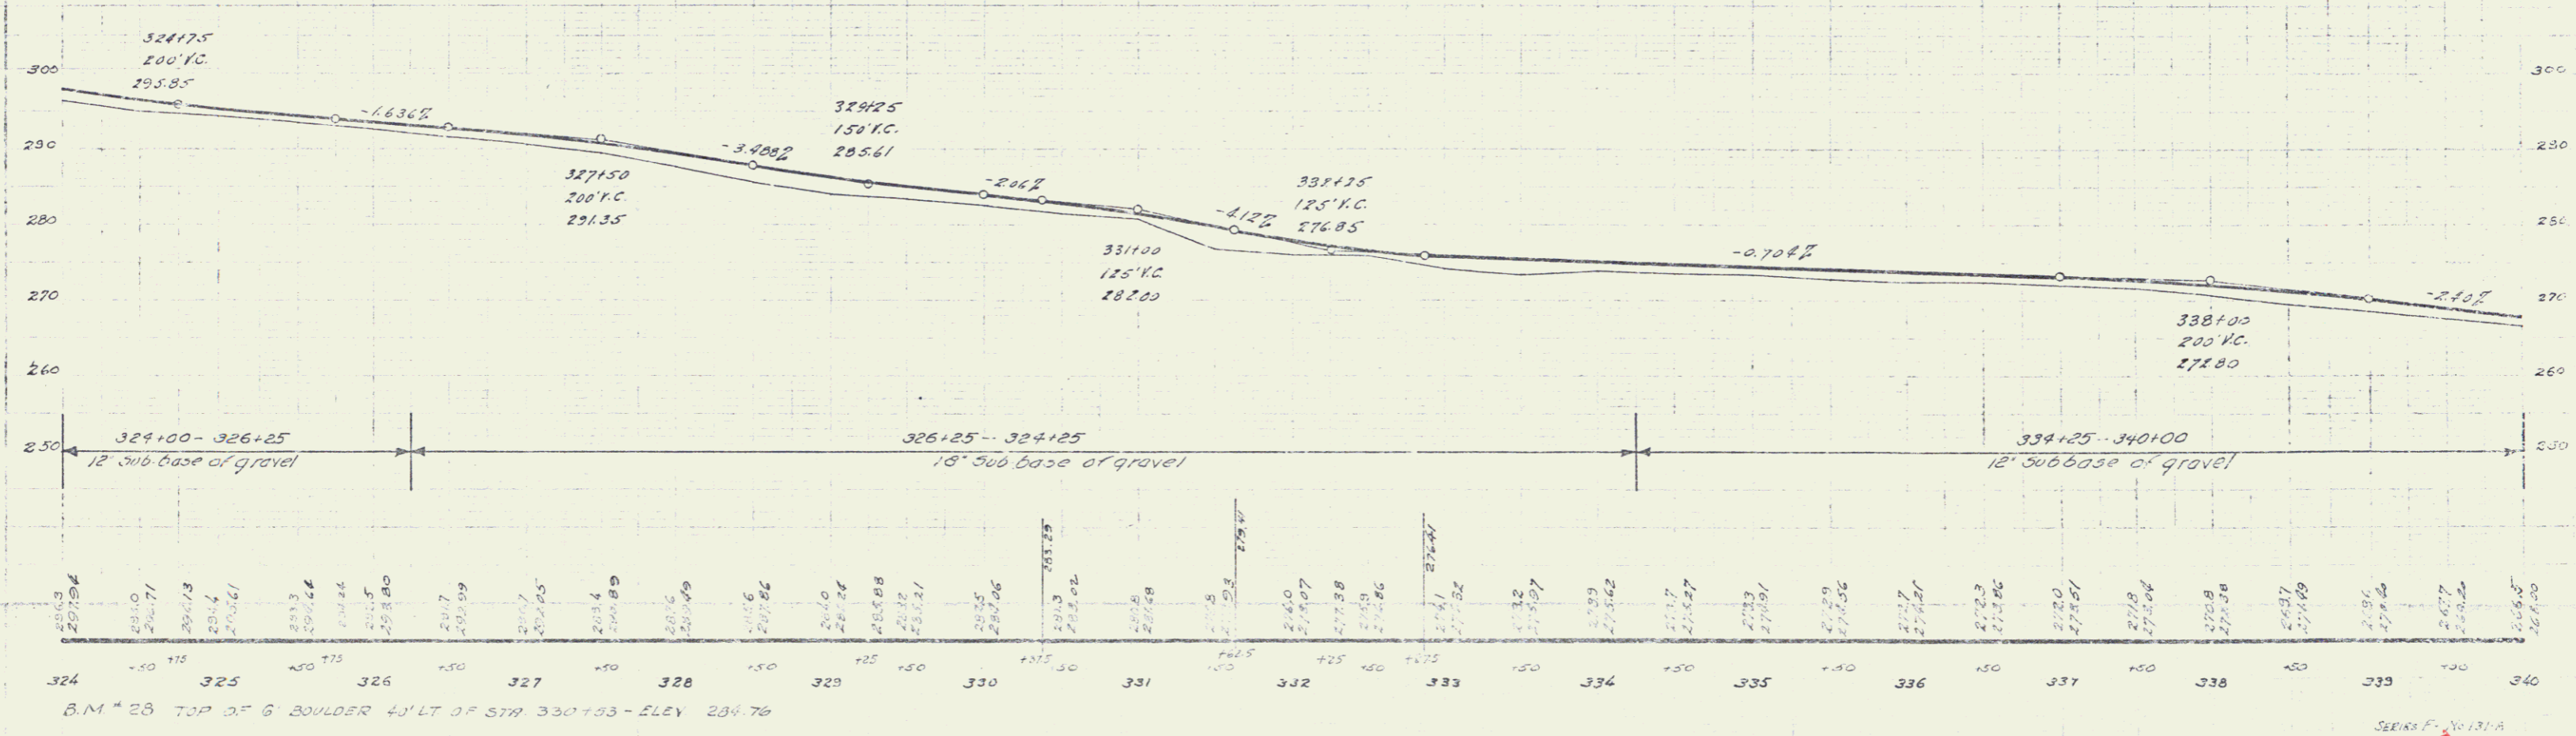


Paved	Kind of Instrument	Date of	Operator	Grade	Revised	Remarks
C	Q.C.D.	7-31-31	Norman Page & Hadley Staff	22	31	24.31
B	"	7-31-31	(H.A. Cline & Brown)	22	31	24.31

131-A 1931 18 71

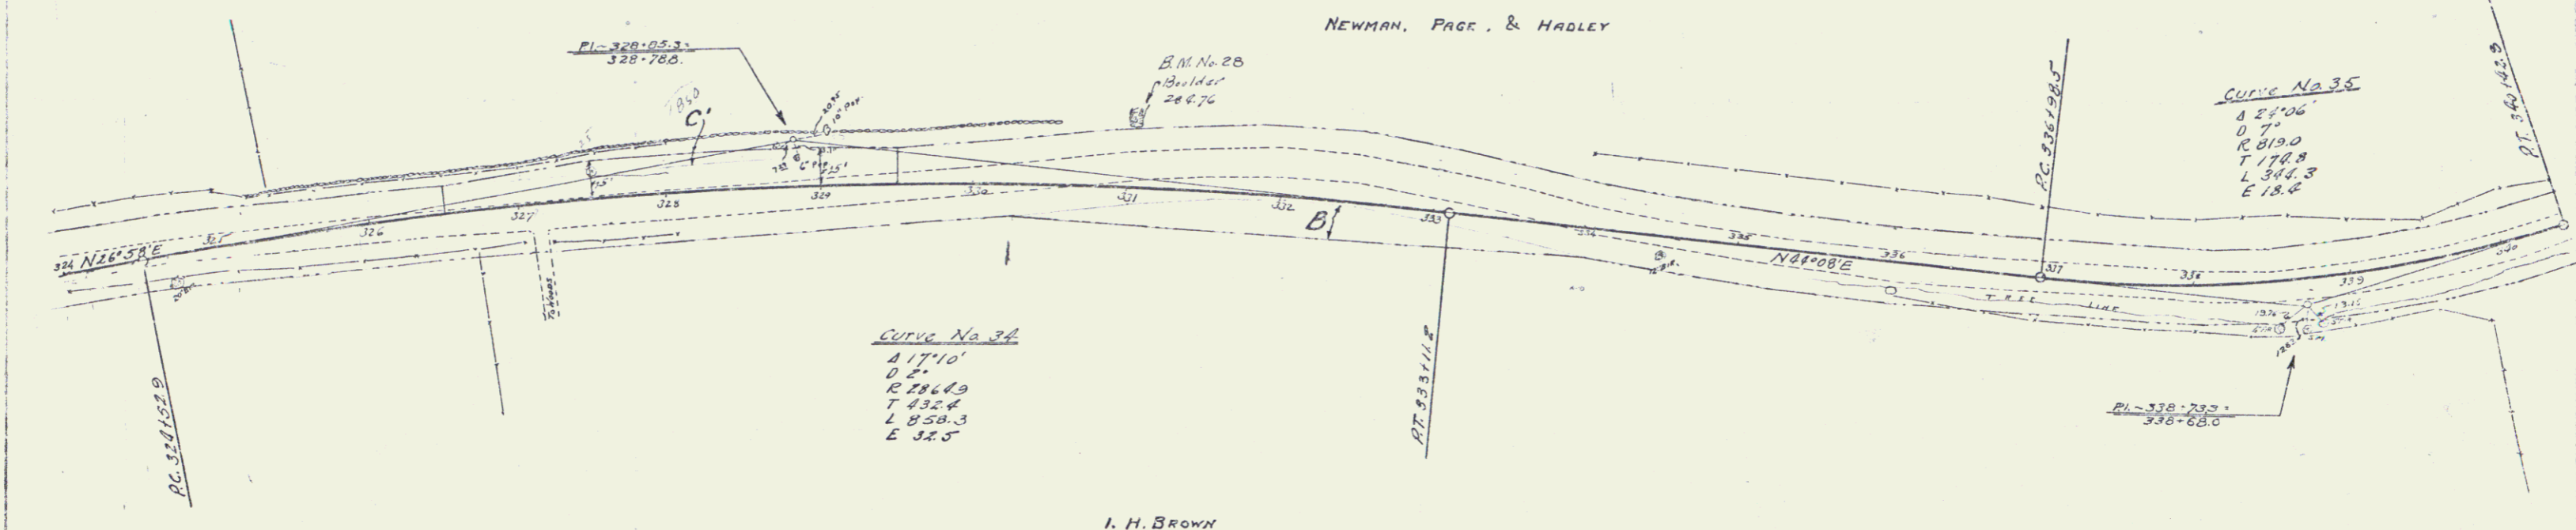

B.M. # 28 TOP OF 6' BOULDER 4 1/2' LT OF STA. 330+53 - ELEV. 284.76

SERIES F-10 131-A SHEET 18 OF 71

18