

WOOD GUARD RAIL RECALC'D

STATION	LEFT	RIGHT
387+78	24'	24'
394+00	24'	24'
397+50	24'	24'
400+75	24'	24'
401+50	24'	24'



NEW CAST IRON PIPE CONCRETE REQUIRED

STATION	DIAM.	LENGTH	CLASS	CLASS	DEPTH	FEET
387+78	24"	45'	27.0		5'	51.0
394+00	18"	33'	18.0		7'	73.0
397+50	18"	34'	18.0		7'	71.0
401+50	18"	45'	18.0		7'	97.0

Parcel Map of Date of Grantor Grantee Recorded Remarks  
 Instrument Instrument  
 31.C. Cult. 11, 283' G.C.D. 3-1A-31 Maude A. Bourdeau Steffli. 22 38A 10-4-31 397+50-401+50

131A 194 22A 71

Curve #43  
 $\Delta 16^{\circ} 03' L.T.$   
 $D 2^{\circ}$   
 $R 2864.9$   
 $T 403.9$   
 $L 802.5$   
 $E 28.3$

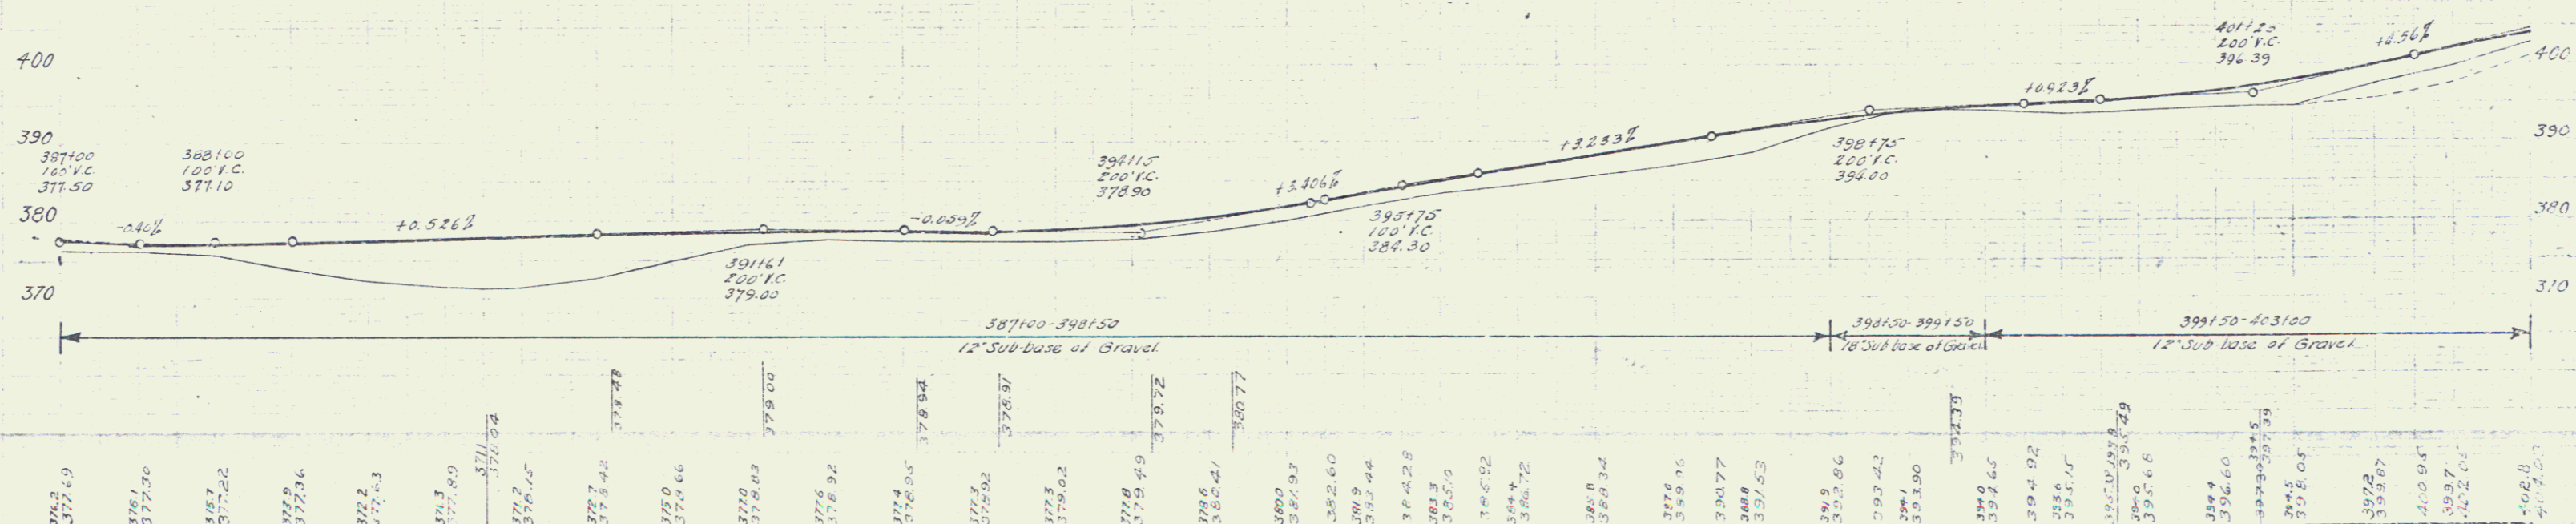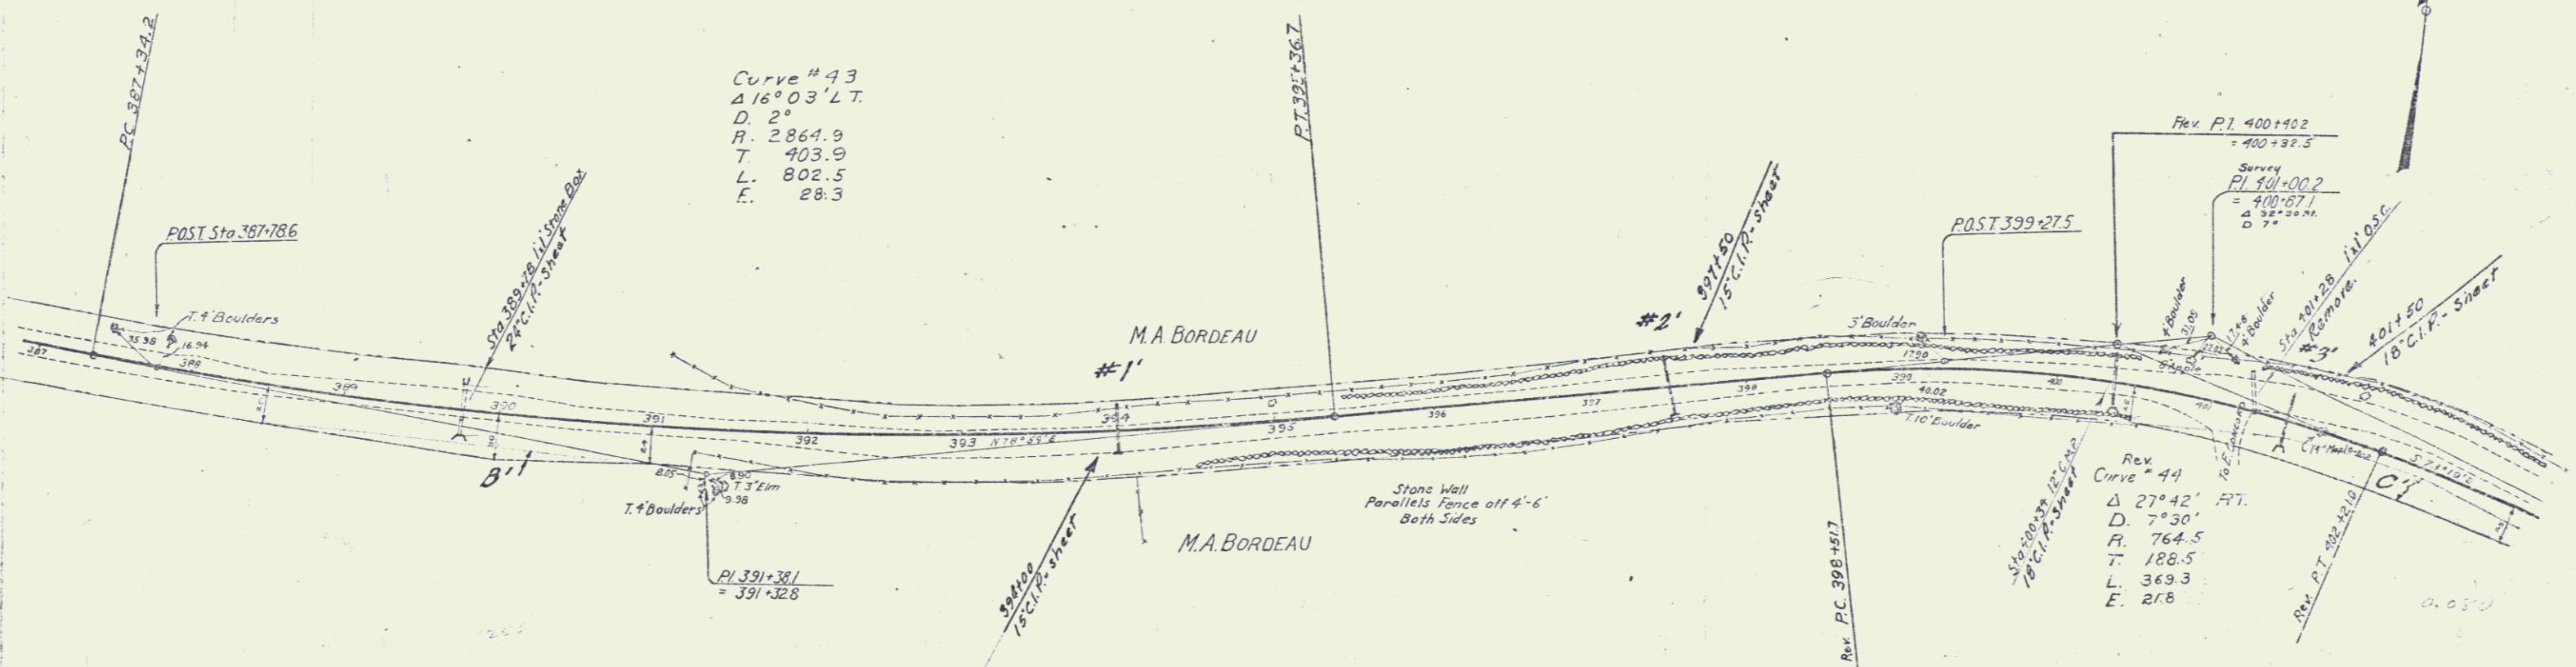

SERIES No. 131A  
 SHEET 22 OF 71