

WOOD SUPPLY RAIL RESERVE



STATION	LEFT	RIGHT
405+00	2.4'	2.4'
406+00	2.4'	2.4'
412+50	2.4'	2.4'

NEW CURVE DATA - SCHEDULE REQUIRED

STATION	FROM	TO	CLASS	GRADE	BELOW	FEET
405+00	18"	42"	10			27.164
406+00	24"	39"	29			59.182
412+50	15"	39"	15			75.182

Parcel	Kind of Instrument	Date of Instrument	Operator	Granice	Granice	Recorded	Remarks
C. J. Clark	Co.D.	9-14-31	Mark A. Boudreau	St. J. H. 22	22	10-5-31	10-5-31 Cult. Sta. 413+00
A. G. H. 1	"	9-14-31	Louis King	"	25	10-5-31	10-5-31 Cult. Sta. 413+00

Curve # 46
 Δ 0° 42' LT.
 D 9° 15'
 R 22918.3
 T 190.0
 L 280.0
 E 0.6

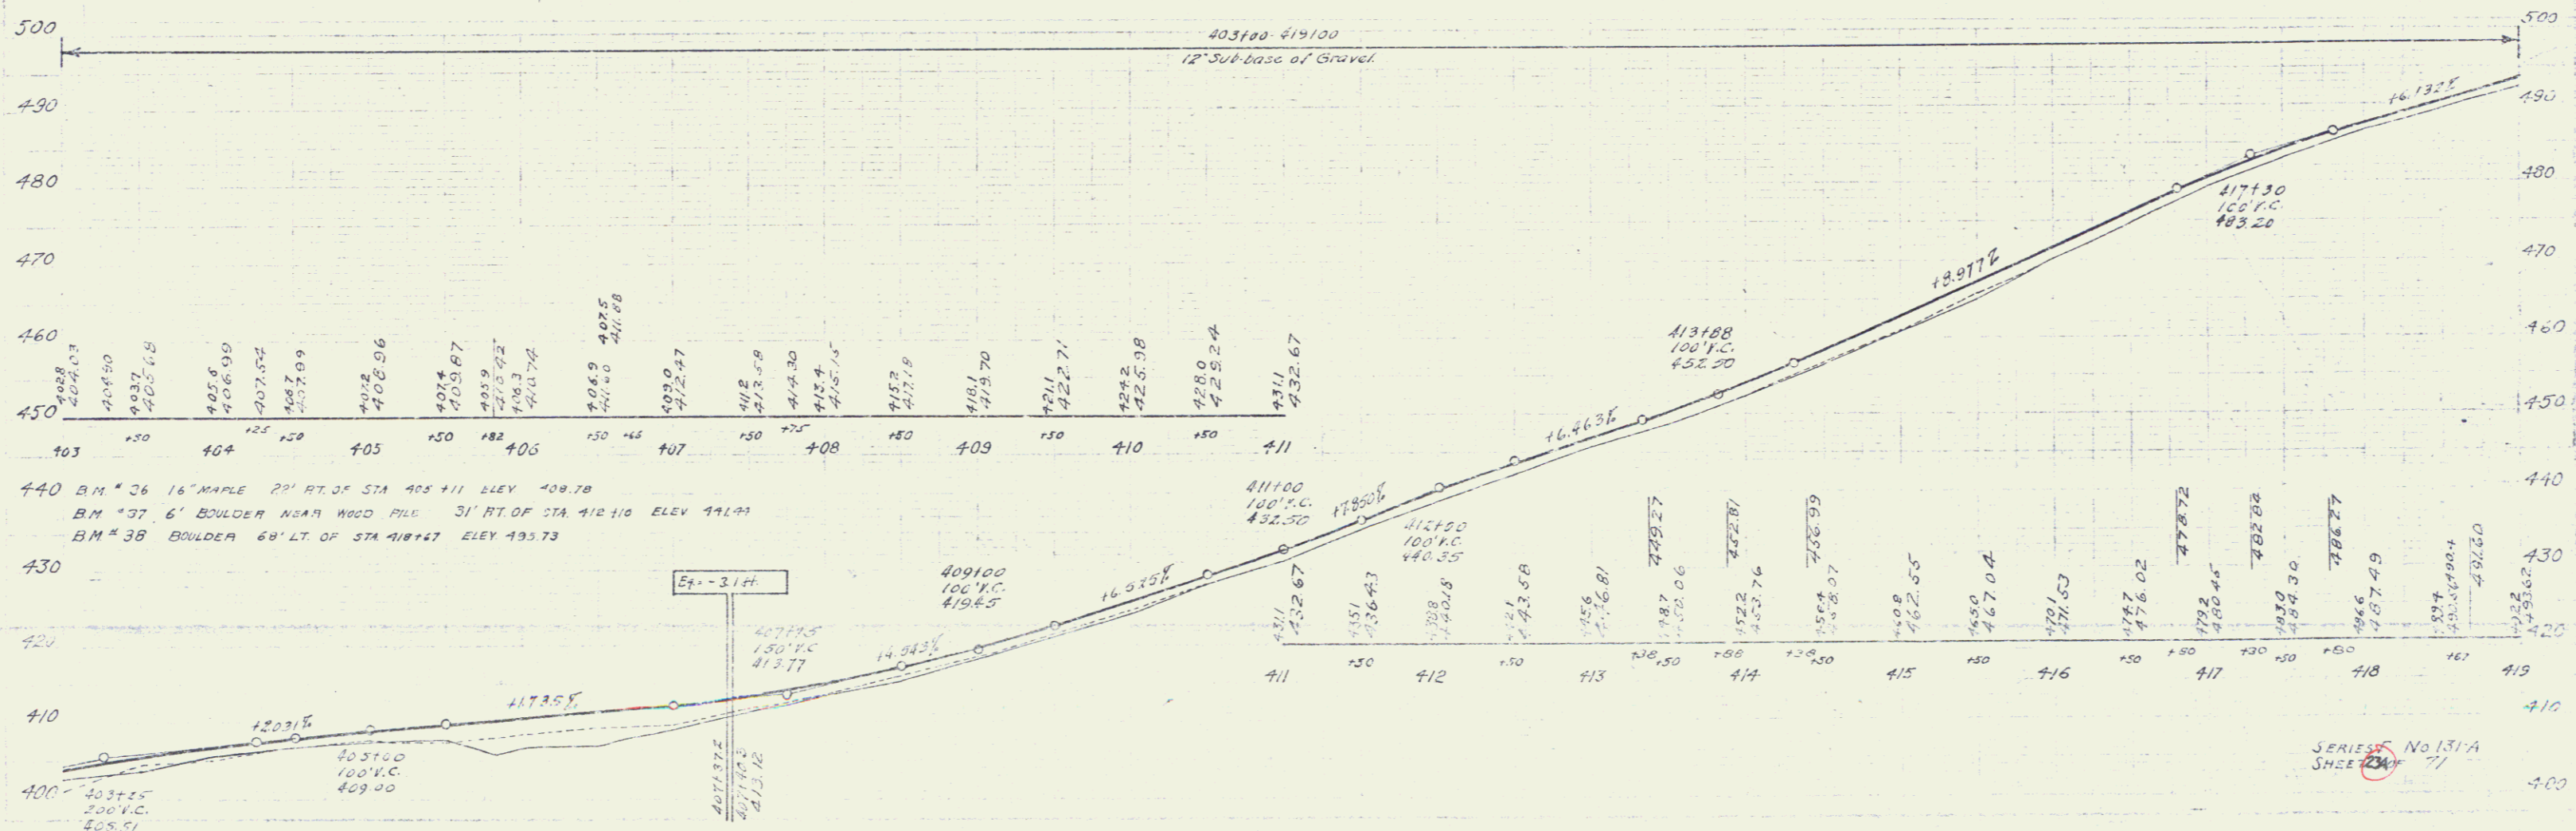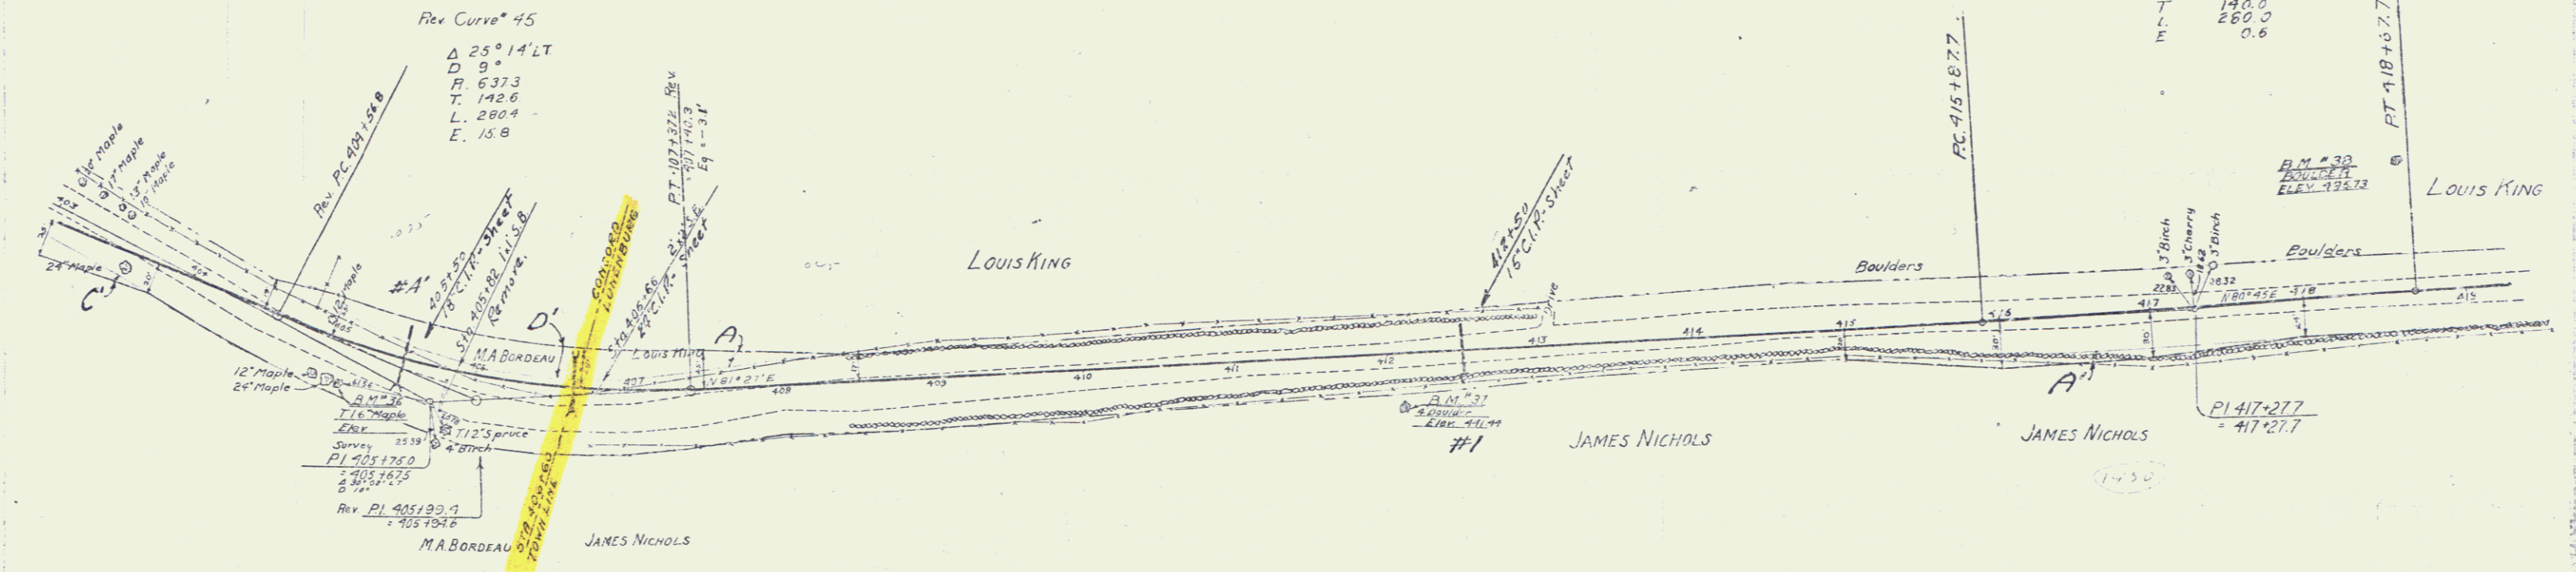

440 B.M. # 26 16" MAPLE 22' RT. OF STA 405+11 ELEV 408.78
 B.M. # 27 6' BOULDER NEAR WOOD PILE 31' RT. OF STA 412+10 ELEV 414.99
 B.M. # 38 BOULDER 68' LT. OF STA 418+27 ELEV 435.73

SERIES No 131-A
 SHEET 77