
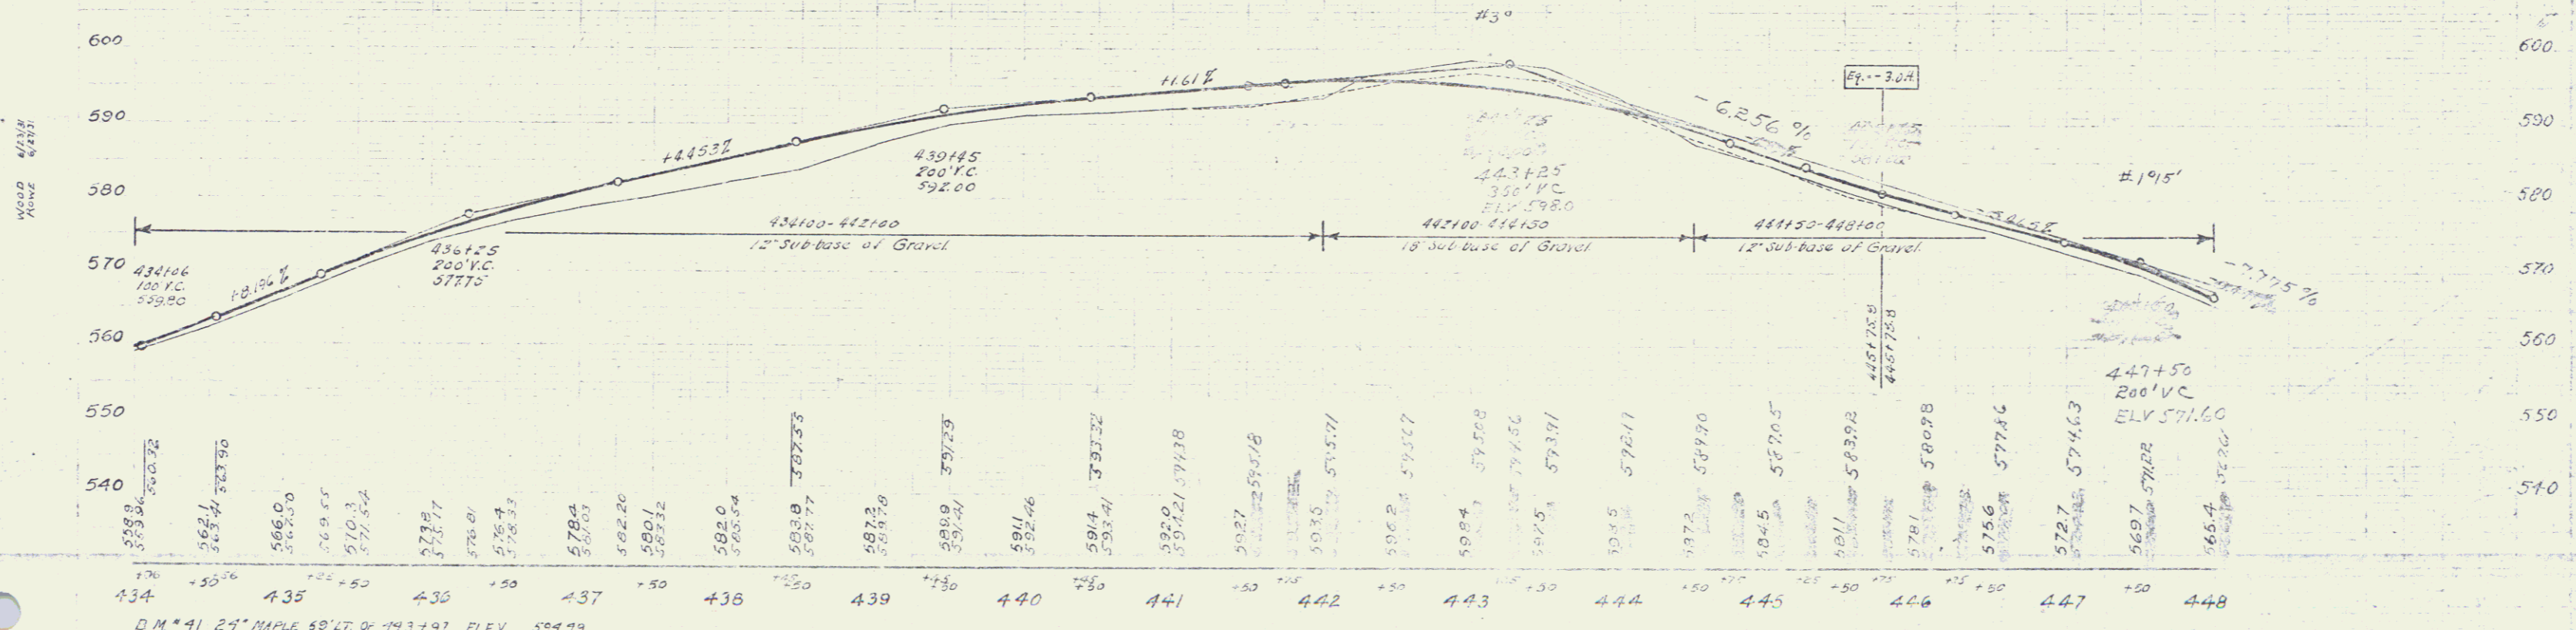


Parcel	Kind of Instrument	Date of Instrument	Grantor	Grantee	Recorded	Remarks
C	O.C.D.	9-11-31	Louis King	St. of Va.	Book Page Date	
D	"	9-14-31	James Nichols	"	25 368 10-5-31	

137A, 1931 25A 71

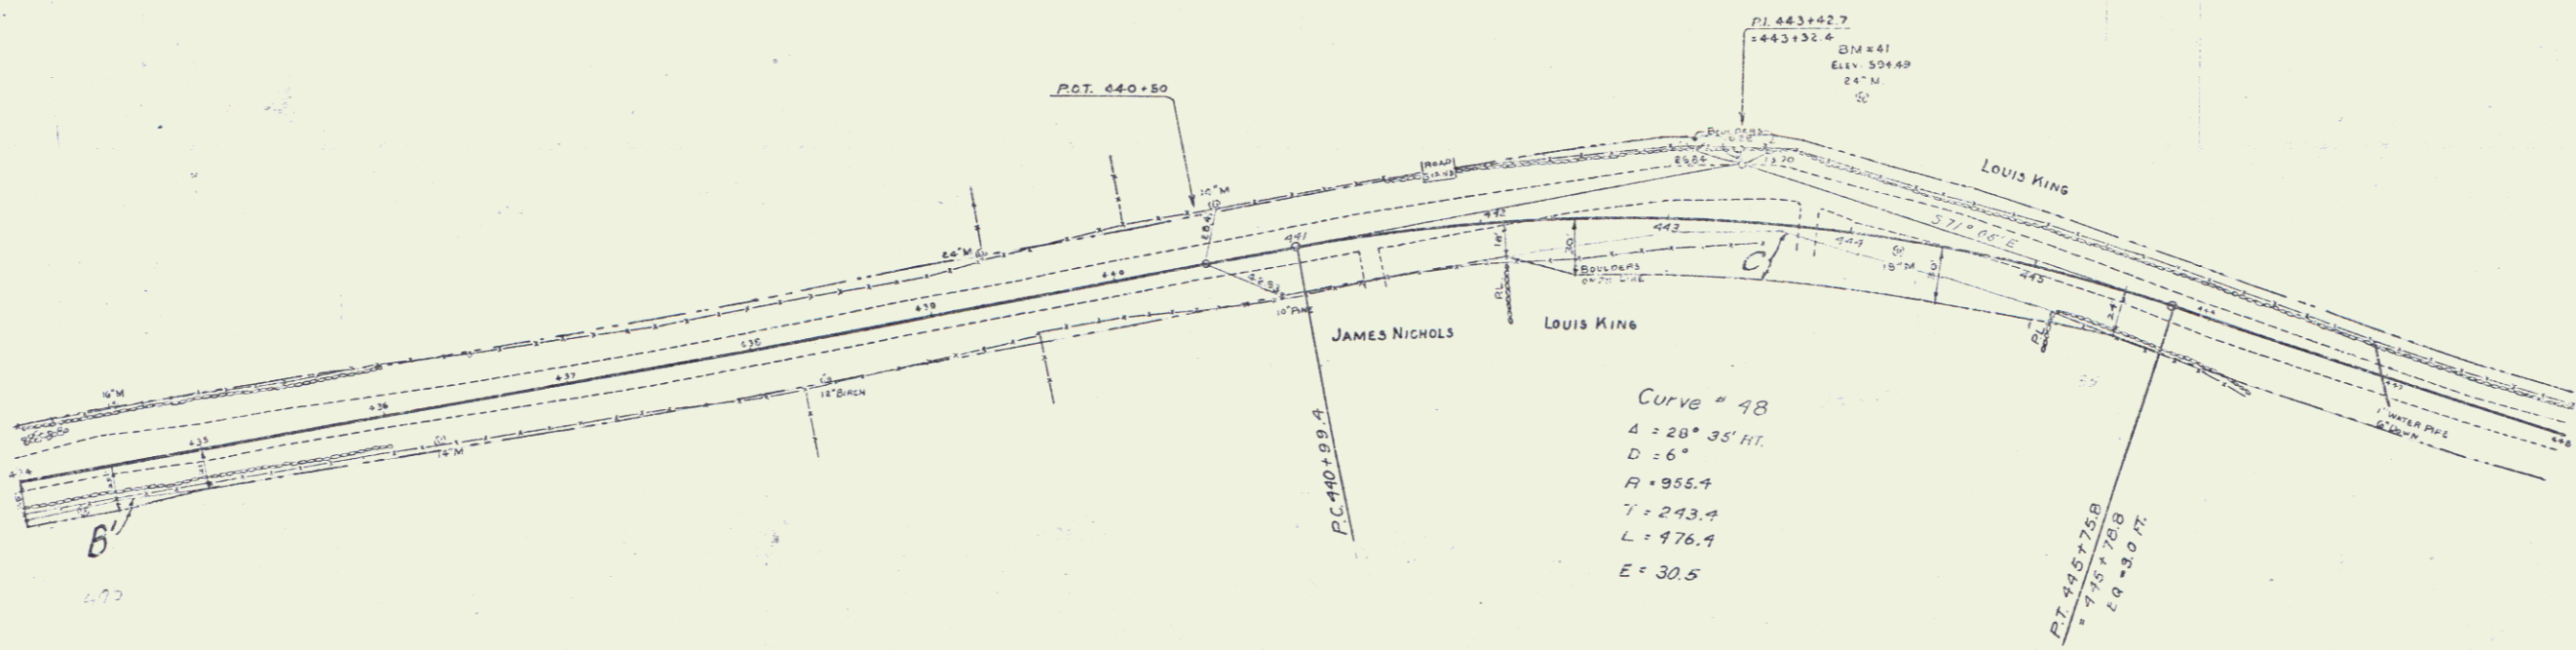

D.M. # 41 29' MAPLE 50' LT. OF 1937 97 ELEV. 594.99

SERIES F No 131-A
SHEET 25A OF 71