

WOOD GUARD RAIL REQUIRED



STATION	LEFT	RIGHT
464+00	2'	2'
465+00	2'	2'
466+00	2'	2'
467+00	2'	2'
468+00	2'	2'
469+00	2'	2'
470+00	2'	2'
471+00	2'	2'
472+00	2'	2'
473+00	2'	2'
474+00	2'	2'

NEW CAST IRON PIPE CULVERTS REQUIRED

STATION	DIAM	LEN	CLASS	CLASS C	PIPE SIZE
465+00	18"	42'	102"		27"
469+00	15"	45'	15"		15"
471+00	15"	42'	2.3 cy		33"

Parcel	Kind of Instrument	Date of Grant	Grantor	Grantee	Recorded	Remarks
C. 22493, 24A	R.C.D.	8-14-31	Ezra Deering	Steph. H. 25	356	100-33 (465140 & 471140)

NO. 131-A 19.4 27A 71

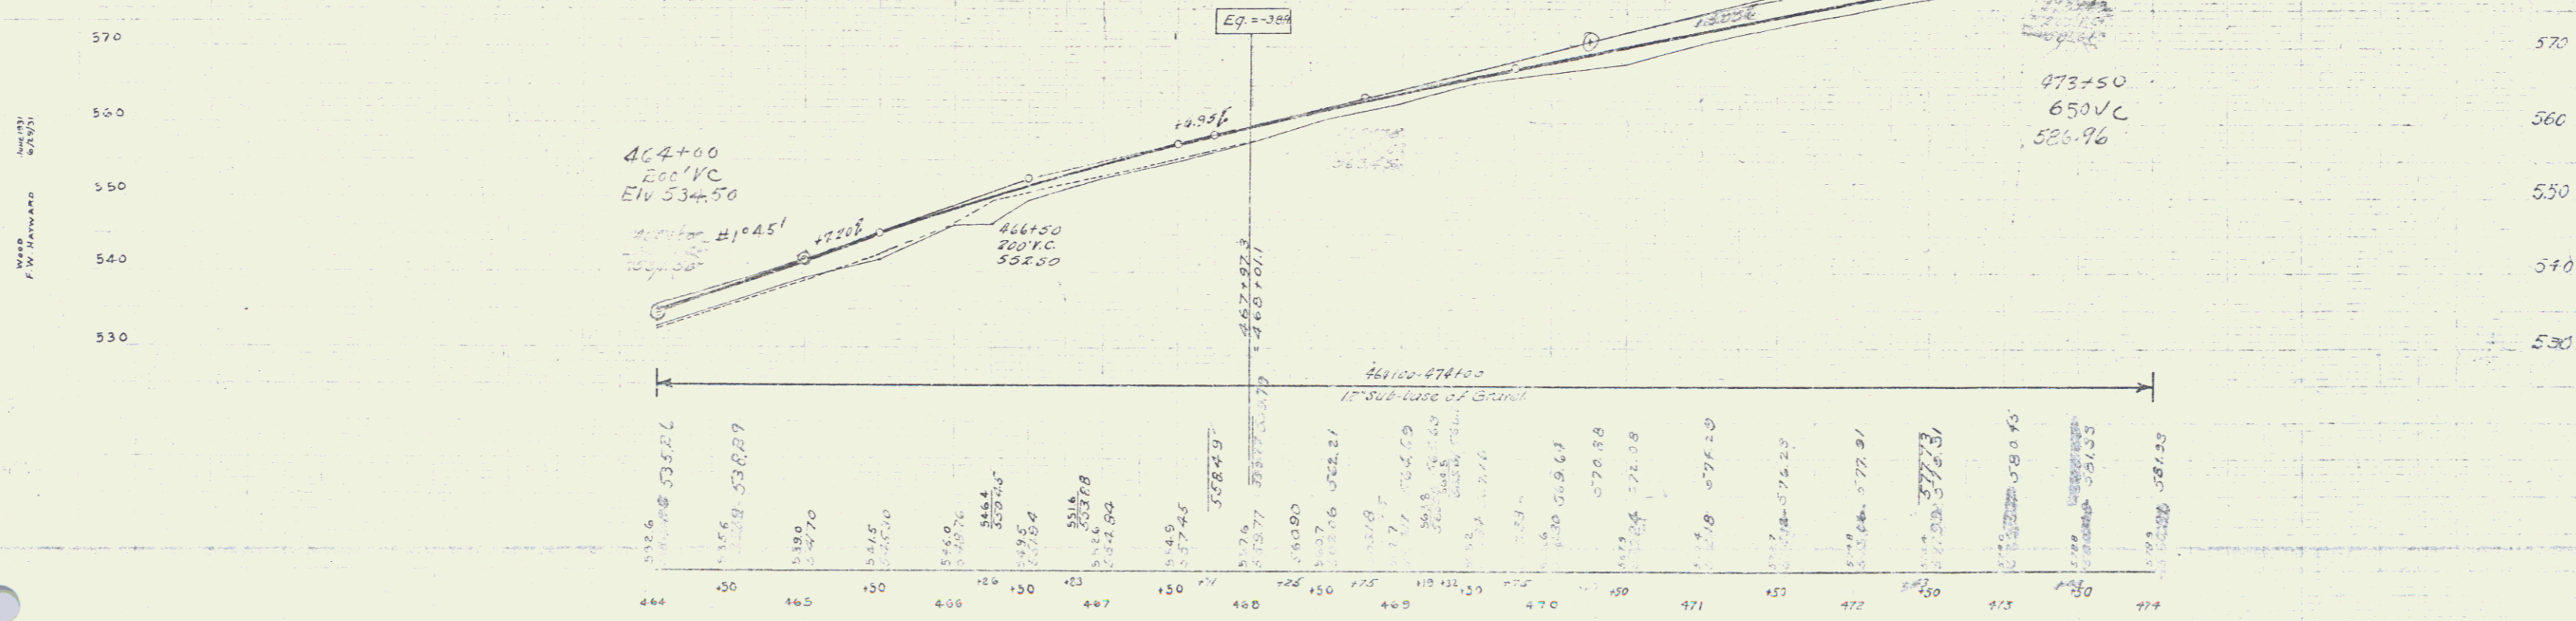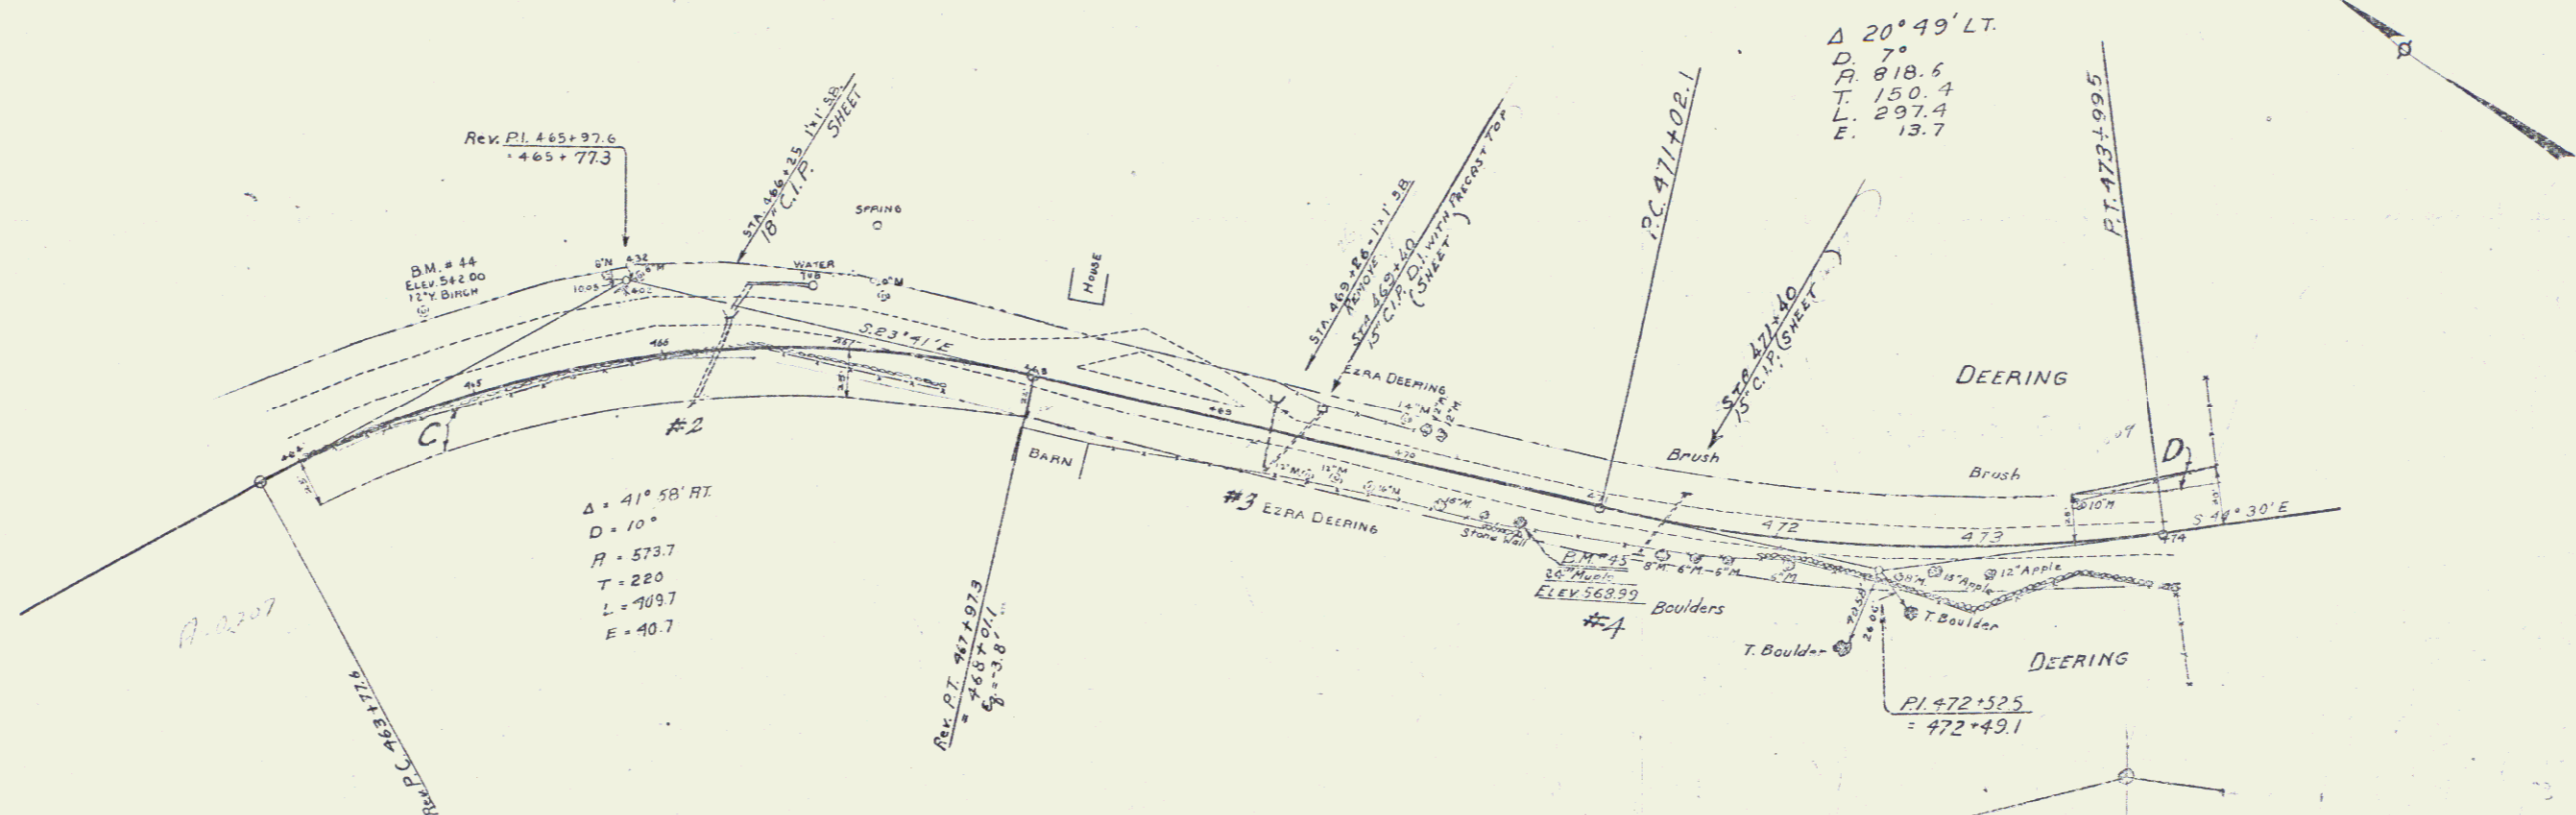

SERIES F No. 131-A
SHEET 27A OF 71