

INDEX OF SHEETS

SHEET NO.	TITLE PAGE
1	TITLE PAGE
2-4	TYPICAL CROSS-SECTION OF IMPROVEMENT (2 1/2" CRUSHED GRAVEL M.P. SURFACE COURSE WITH REFINED TAR)
5	BANKING AND WIDENING TABLES
6-23	PLAN AND PROFILE
24	DETAILS OF 7'x6' R.C. BOX
25	STANDARD STRUCTURE SHEET S-28 PIPE CULVERTS
26	S-30 GUARD RAIL
27	S-30-A UNDERDRAIN & CATCH BASINS
28	S-31 CONCRETE CURB
29	S-40 BARRICADES, SIGNS & LIGHTS
30	S-41 ROUNDING OF SLOPES
31	RCCPI 4.5 X 6 R.C. BOX
32-99	CROSS SECTION SHEETS

STANDARD STRUCTURE SHEETS APPROVED
BY THE CHIEF ENGINEER, VT. ST. DEPT. OF HWYS.

S-28 APRIL 26, 1941
S-30 MAY 12, 1941
S-30-A APRIL 19, 1941
S-40 DEC. 18, 1945

STATE OF VERMONT
STATE HIGHWAY DEPARTMENT

PLAN AND PROFILE OF PROPOSED
STATE HIGHWAY


FEDERAL AID PROJECT

TOWN OF CONCORD
ROUTE U.S. 2

ST. JOHNSBURY - LANCASTER N.H. ROAD
BEGINNING AT A POINT 0.503 MI. SOUTH OF THE KIRBY - CONCORD TOWN LINE
AND EXTENDING SOUTH EASTERLY 2.140 MILES

LENGTH OF PROJECT 11,299.2 FT. = 2.140 MILES

FED. ROAD DIST. NO.	STATE	PROJ. NO.	FISCAL YEAR	SHEET NO.	TOTAL SHEETS
9	Vt.	F31(2)	1946	1	99

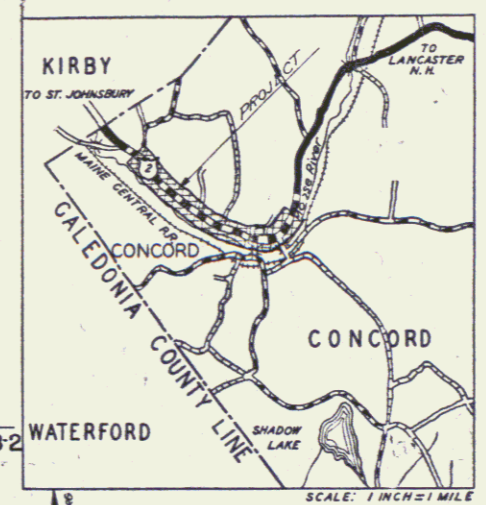


STA. 112+98.9 - STA. 113+50
END F.31(2) BEGINNING OF F.A.P. 131-B-2
113+50 OF F.A.P. 31

M.P. 2.65

RECORD PLANS
By
D.R. Loring & G.E. Guidi
Feb. 1945
Res. Eng.: L.W. Bronnell

Pin# 99R152
Project No F 31(2)

STA. 342+948
END F.131(10) = STA. 0+00
BEGINNING OF F.31(2)
0+00 OF F.A.P. 31

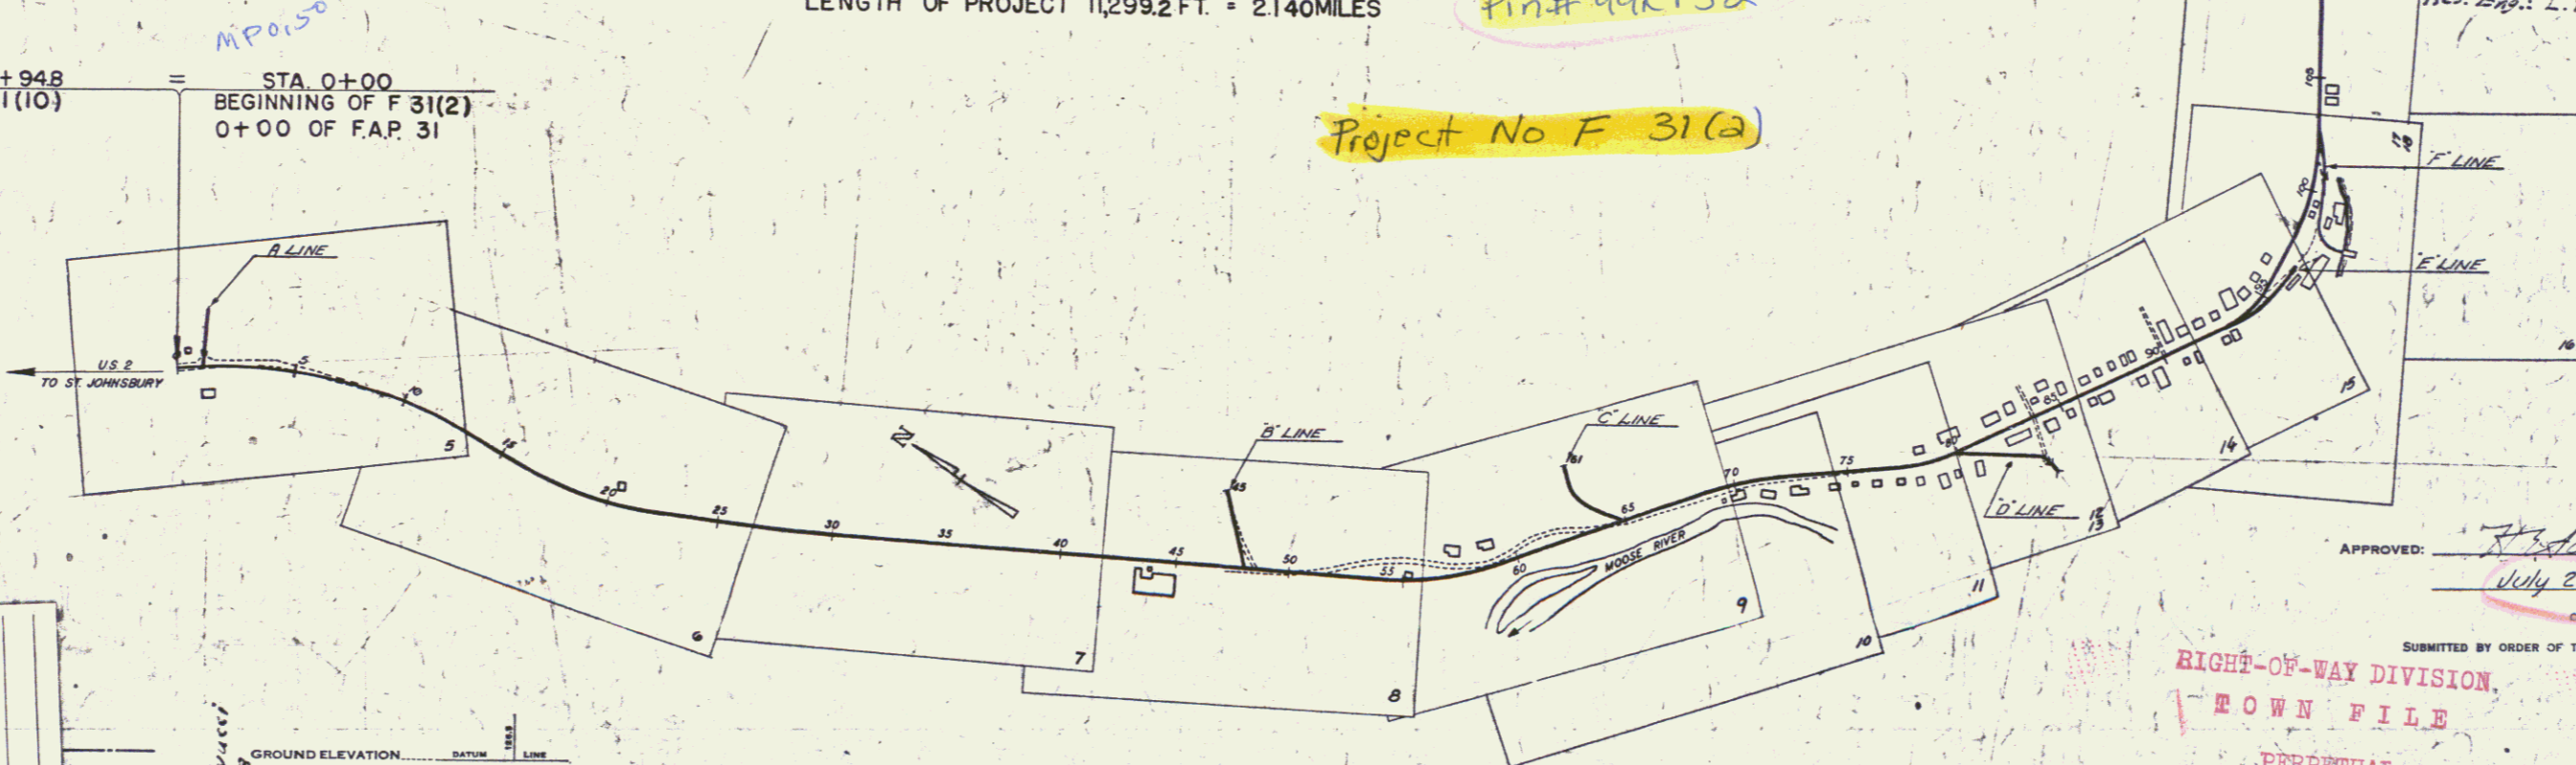

PROJECT Concord
NUMBER F.31(2)
TYPE 2 1/2" Crushed Gravel M.P.
CONTRACTOR
LOCATION Sec 16, Concord
YEAR 1945

RECORD PLANS
Concord F.31(2)
Contractor: Peter Salvucci
Apr 26, 1945

	DATUM	LINE
GROUND ELEVATION	DATUM	LINE
GRADE ELEVATION	DATUM	LINE

CURVE DATA

DEFLECTION ANGLE	Δ
DEGREE OF CURVE	D
RADIUS OF CURVE	R
TANGENT DISTANCE	T
LENGTH OF CURVE	L
EXTERNAL DISTANCE	E
POINT OF INTERSECTION	P.I.
POINT OF CURVE	P.C.
POINT OF TANGENT	P.T.
POINT ON TANGENT	P.O.T.

SCALES

TITLE	1" = 400'
TYPICAL	1" = 2'
PLAN	1" = 50' & 1" = 20'
PROFILE HORIZONTAL	1" = 50' & 1" = 20'
PROFILE VERTICAL	1" = 10'
CROSS SECTIONS	1" = 8'

APPROVED: [Signature]
July 29, 1946
COMMISSIONER OF HIGHWAYS

RIGHT-OF-WAY DIVISION
TOWN FILE
PERPETUAL
Town of US 2
(To Be Returned To R.O.W.)

THESE PLANS ARE SUBJECT TO SUCH REVISIONS AS MAY BE REQUIRED BY THE PUBLIC ROADS ADMINISTRATION OR THE COMMISSIONER OF HIGHWAYS.
CONSTRUCTION IS TO BE CARRIED ON IN ACCORDANCE WITH THE PLANS AND THE STANDARD ROAD AND BRIDGE SPECIFICATIONS OF 1936, AS APPROVED DECEMBER 29TH, 1936 BY THE PUBLIC ROADS ADMINISTRATION, INCLUDING ALL SUBSEQUENT APPROVED REVISIONS AND SUCH REVISED SPECIFICATIONS AND SPECIAL PROVISIONS AS ARE SUBMITTED WITH THE PLANS.

APPROVED: [Signature] HIGHWAY ENGINEER
APPROVED: [Signature] DISTRICT HIGHWAY COMMISSIONER
SERIES F No. 31(2) FILED
SHEET 1 OF 99