



POOR ORIGINAL COPY

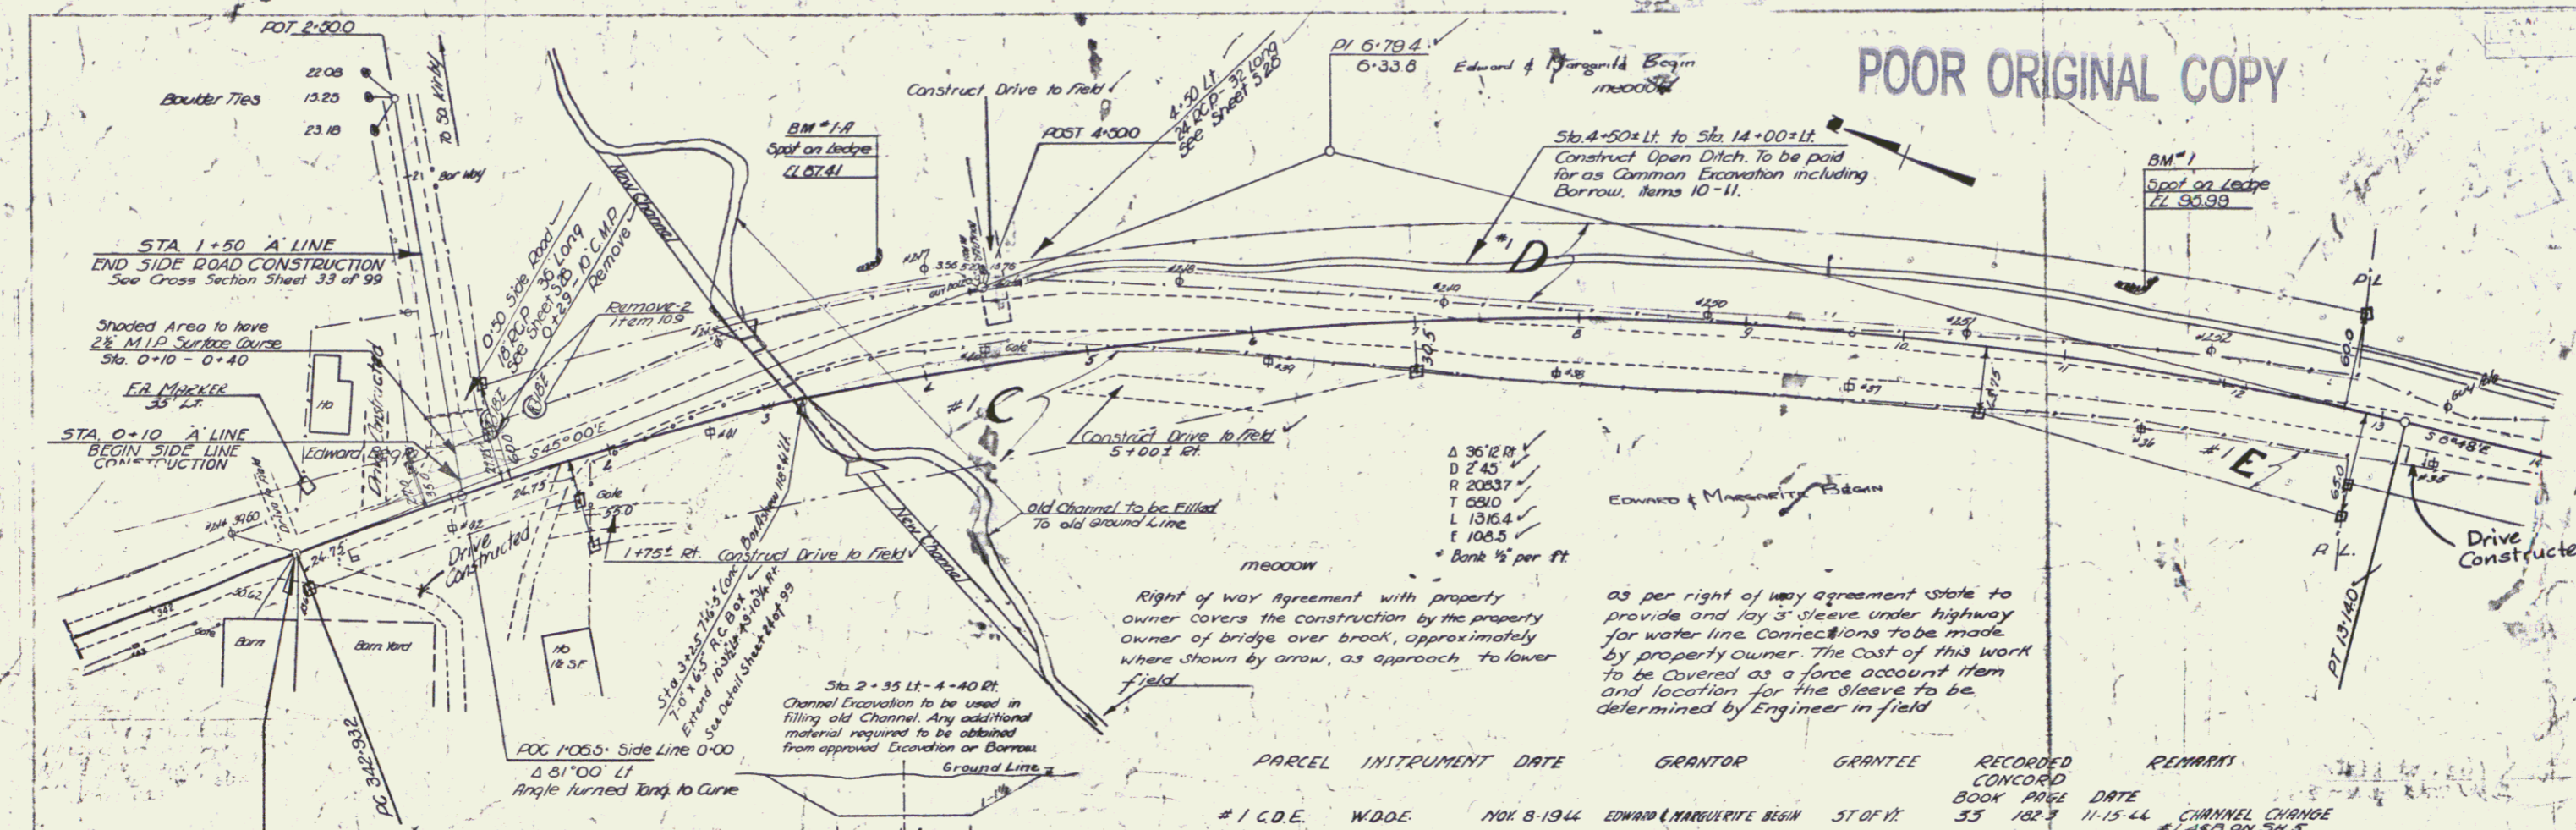

PARCEL	INSTRUMENT	DATE	GRANTOR	GRANTEE	RECORDED CONCORD BOOK PAGE	REMARKS
#1 C.D.E.	W.D.E.	NOV 8-1944	EDWARD & MARGUERITE BEGIN	ST OF VT.	35 1023	11-15-44 CHANNEL CHANGE #1 A+B ON S.H.S.

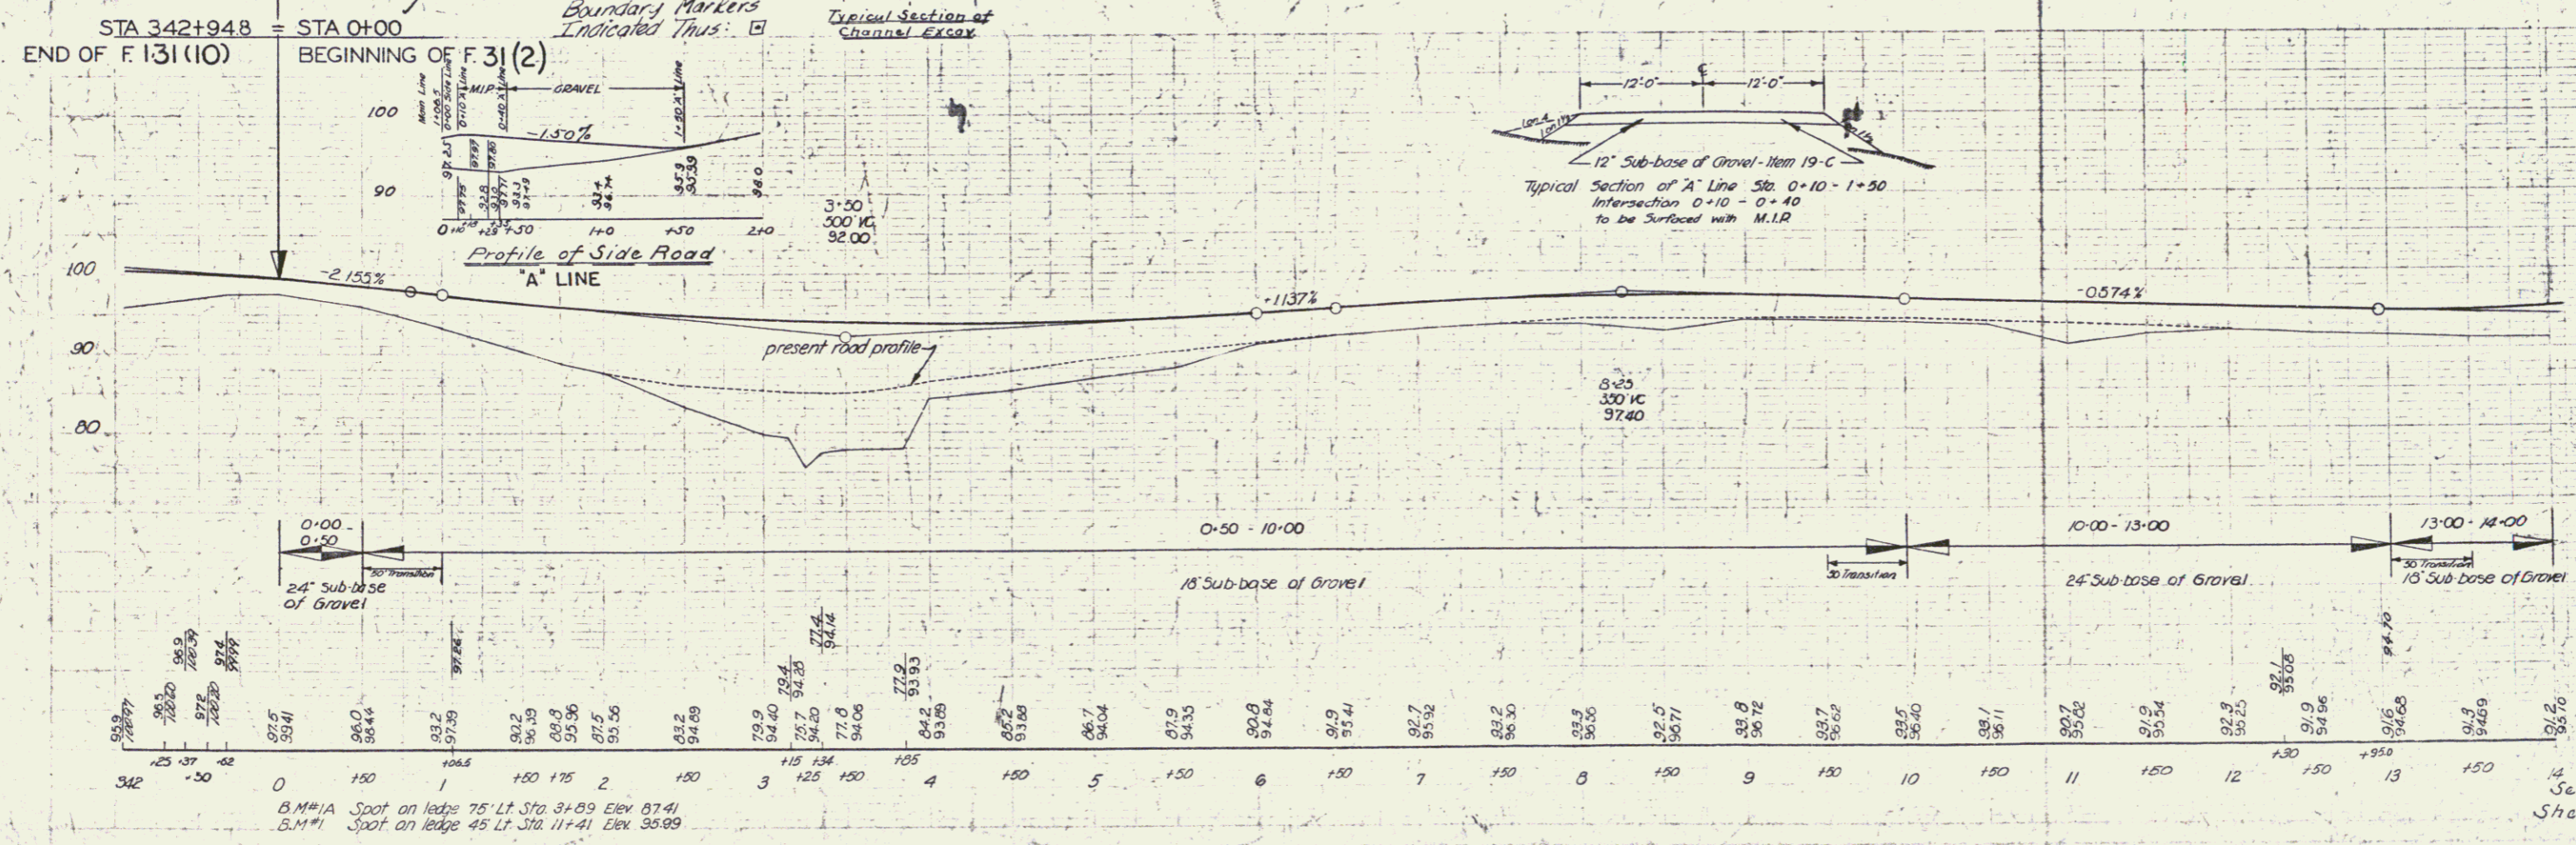

B.M.#1A Spot on ledge 75' Lt Sta 31+89 Elev 87.41  
 B.M.#1 Spot on ledge 45' Lt Sta 11+41 Elev 95.99