


POOR ORIGINAL COPY

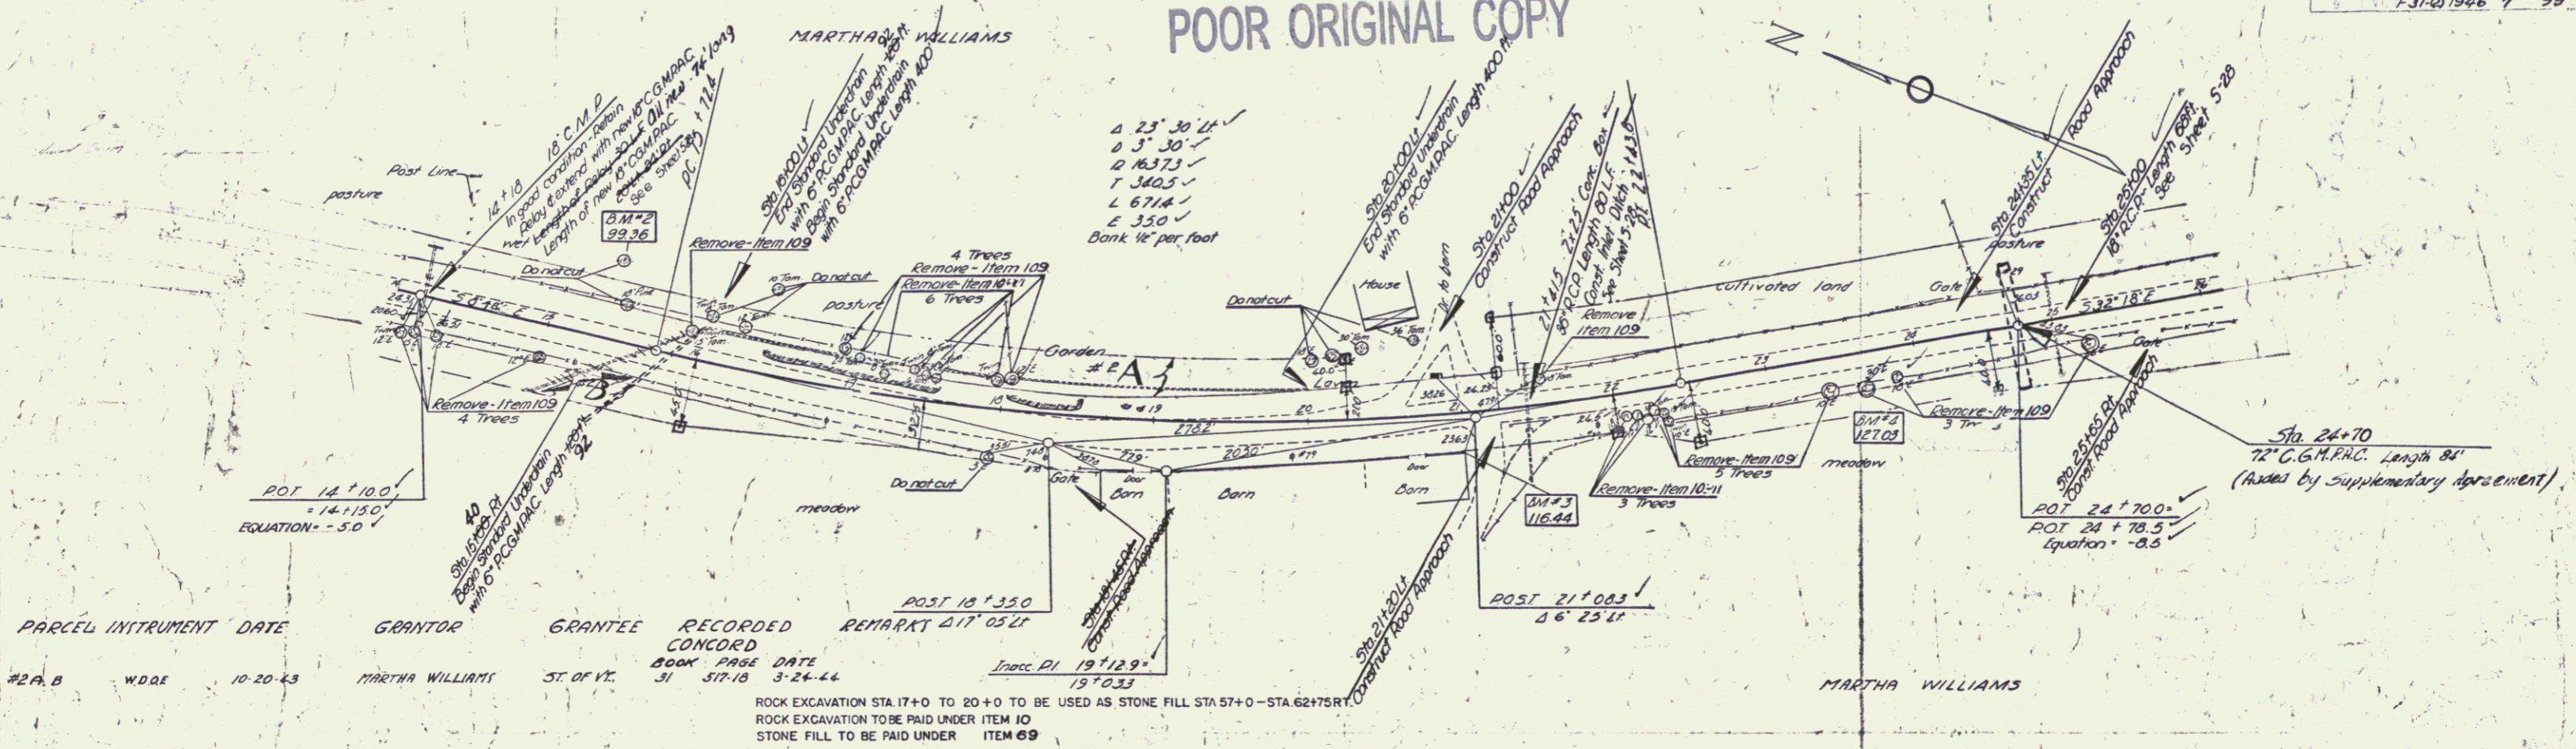

PARCEL INSTRUMENT	DATE	GRANTOR	GRANTEE	RECORDED	REMARKS
#2A, B	10-20-43	W.D.A.E.	MARTHA WILLIAMS	ST. OF VT.	
				CONCORD BOOK	
				FILE DATE	
				3-24-44	
				517-18	
				19' 12.9'	
				15' 0.33'	

ROCK EXCAVATION STA 17+0 TO 20+0 TO BE USED AS STONE FILL STA 57+0 - STA 62+75 R.T.
 ROCK EXCAVATION TO BE PAID UNDER ITEM 10
 STONE FILL TO BE PAID UNDER ITEM 69

