


| PARCEL INSTRUMENT | DATE | GRANTOR | GRANTEE | RECORDED | REMARKS |
|-------------------|----------|----------|-------------------|------------|-------------------|
| #2 E | W.D.O.E. | 10-20-43 | MARTHA WILLIAMS | ST. OF VT. | 31 517-18 3-24-44 |
| #3 A, B, C | W.D.O.E. | 9-22-43 | ELMER & ELLA REED | ST. OF VT. | 31 520 3-24-44 |
| #4 A | W.D.O.E. | 9-22-43 | WALTER H. GLEASON | ST. OF VT. | 31 165 3-24-44 |

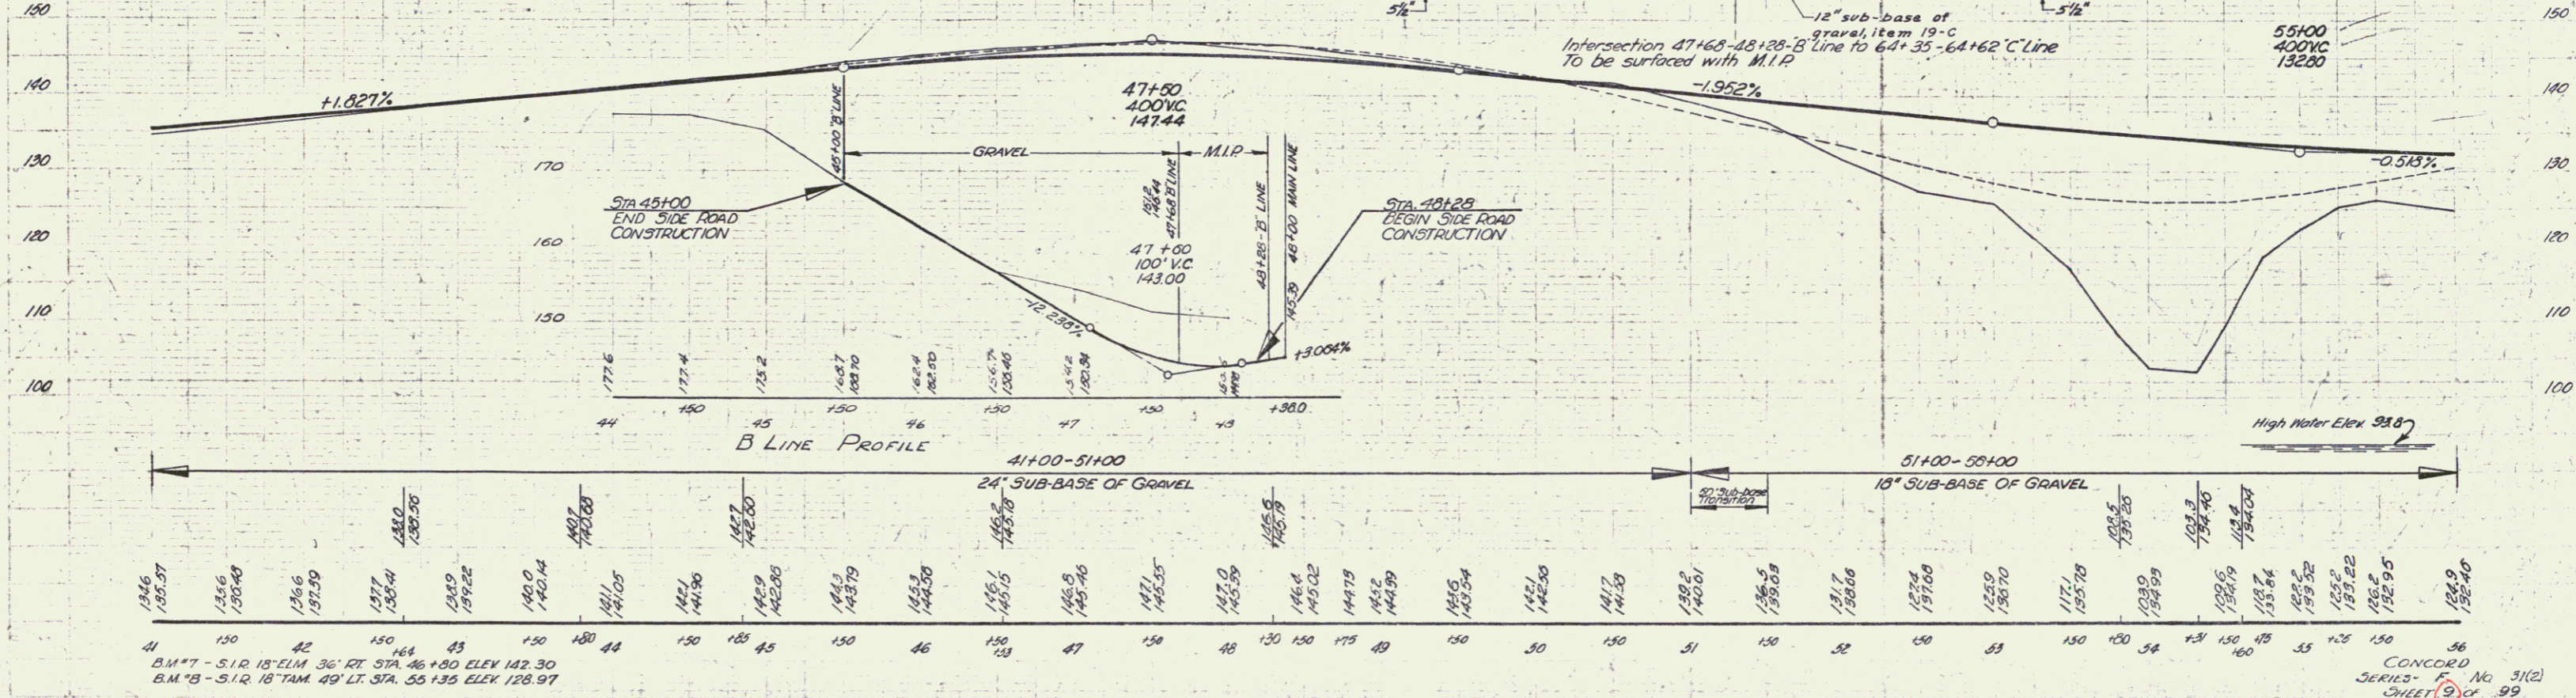

B.M. 77 - S.I.R. 18' ELM. 36' RT. STA. 46+80 ELEV. 142.30
 B.M. 78 - S.I.R. 18' TAM. 49' LT. STA. 55+35 ELEV. 128.97

CONCORD
 SERIES - F. No. 51(2)
 SHEET 9 OF 99

5