
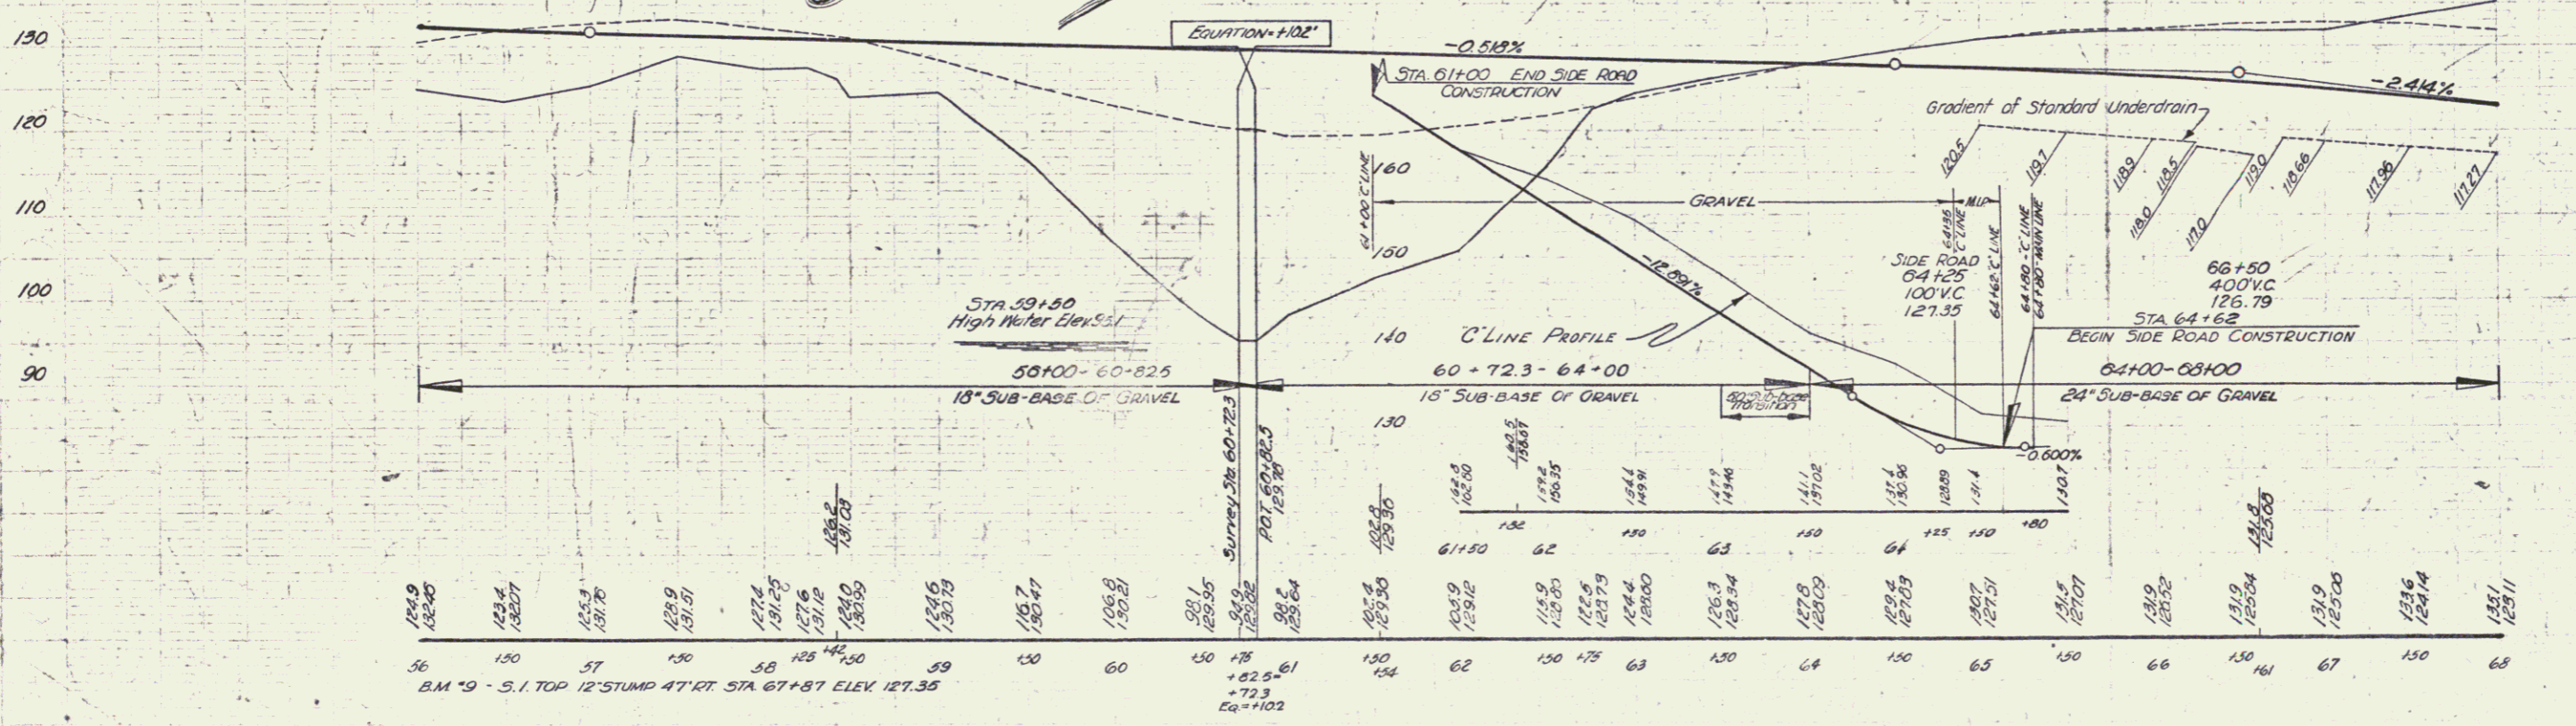


POOR ORIGINAL COPY

EST. 1946 F 31(2) 10 99

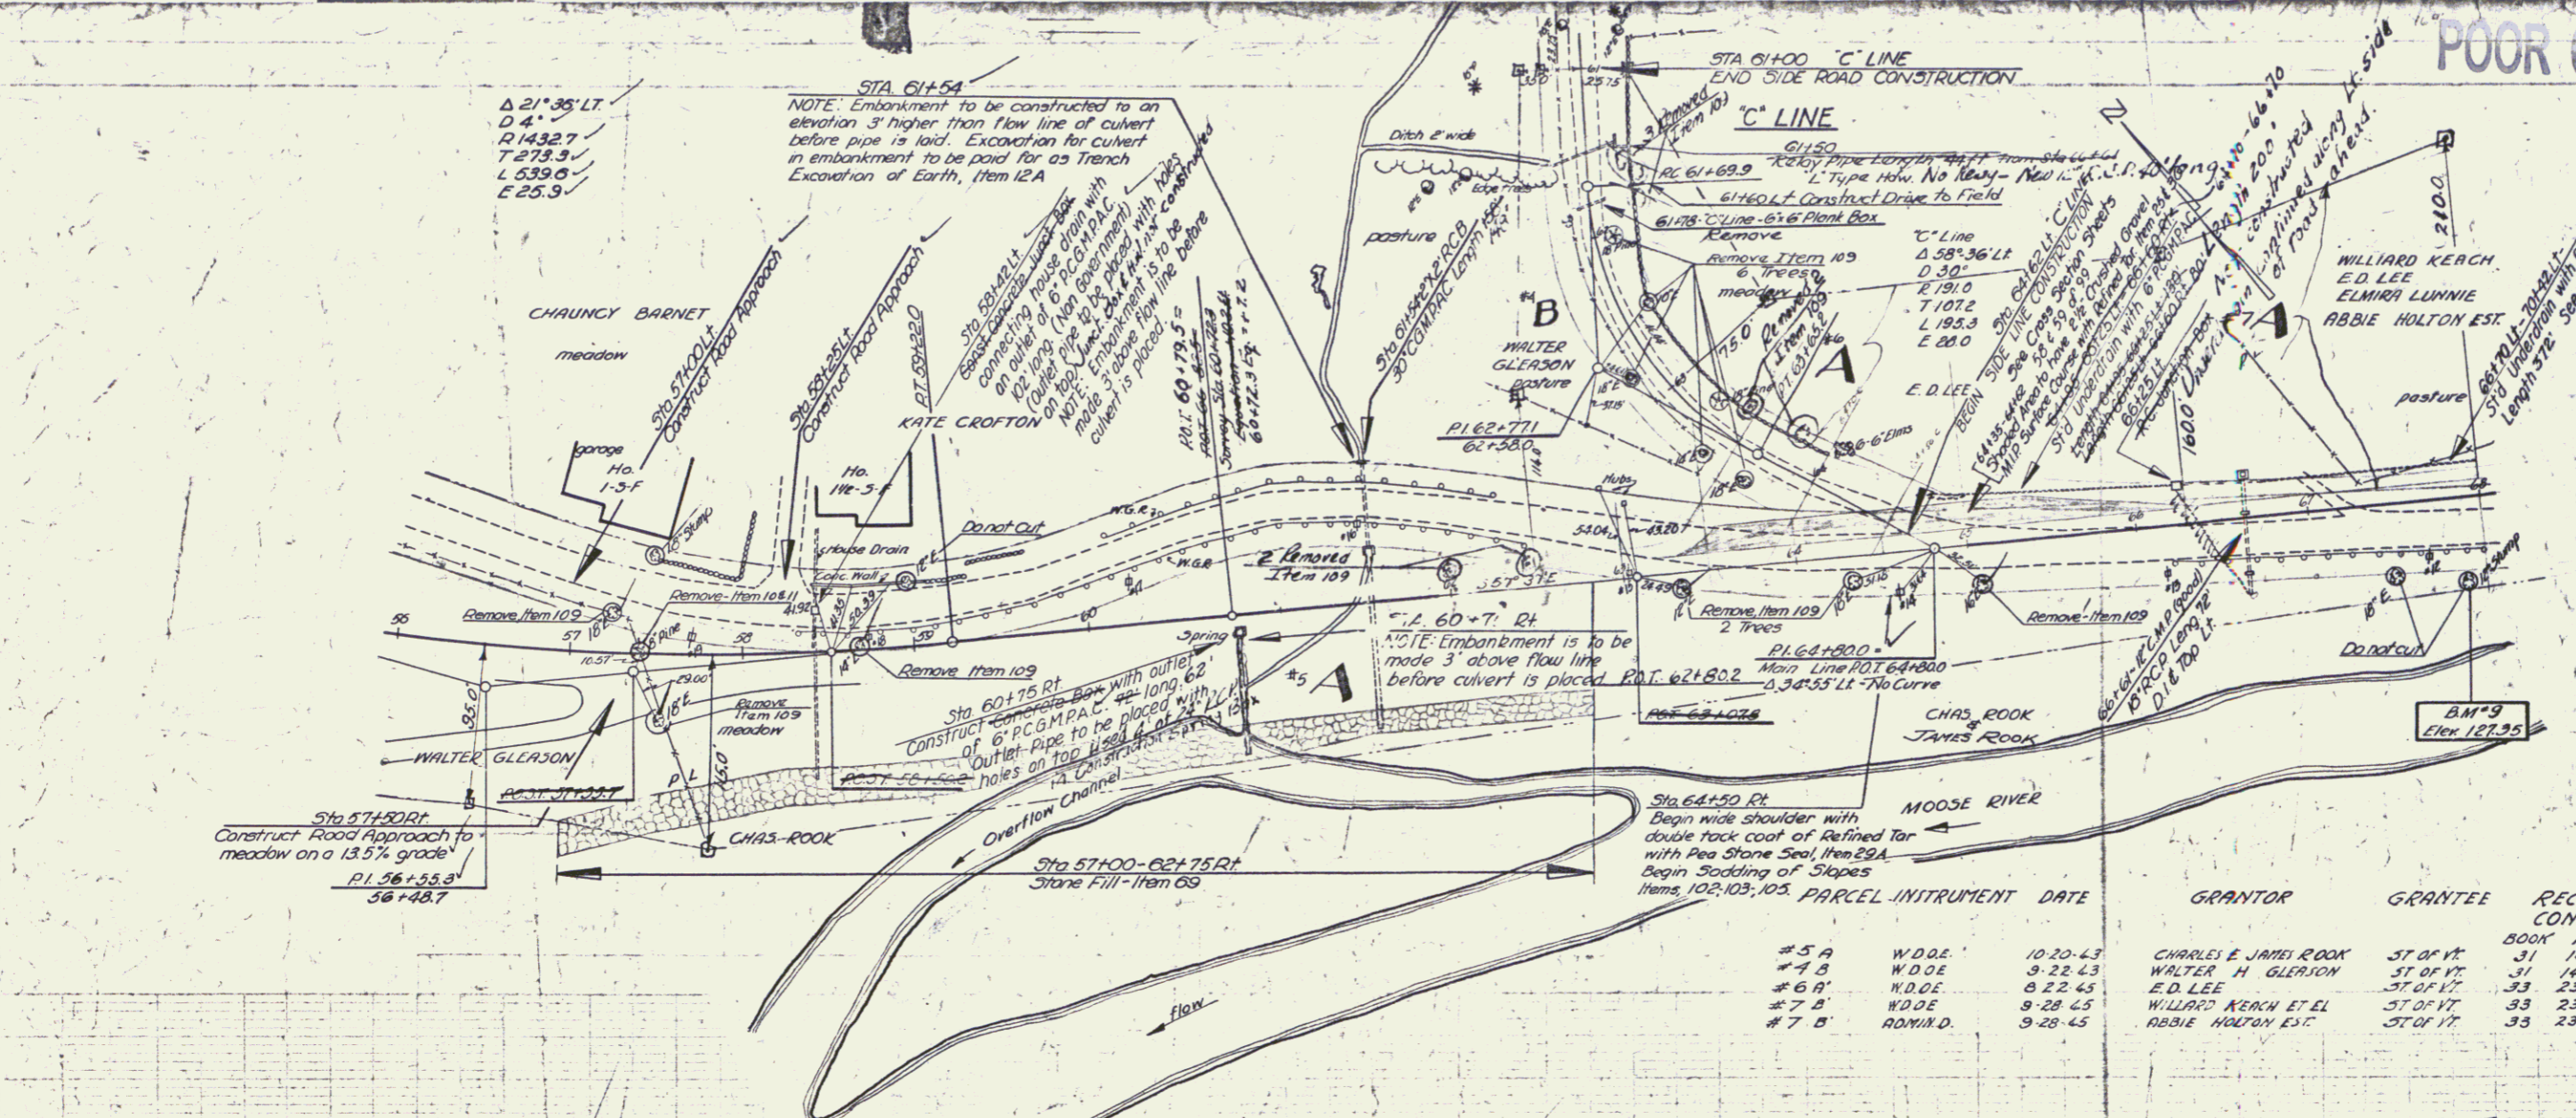

PARCEL INTRUMENT	DATE	GRANTOR	GRANTEE	RECORDED CONCORD	REMARKS
#5 A	W.D.O.E. 10-20-43	CHARLES E. JAMES ROCK	ST OF VT	BOOK PAGE DATE	
#4 B	W.D.O.E. 9-22-43	WALTER H. GLEASON	ST OF VT	31 166 3-24-44	
#6 A	W.D.O.E. 8-22-45	E.D. LEE	ST OF VT	33 237 10-25-45	
#7 B	W.D.O.E. 9-28-45	WILLARD KERCH ET AL	ST OF VT	33 230 10-25-45	
#7 B	ADMIN. 9-28-45	ABBIE HULTON EST.	ST OF VT	33 231 10-25-45	

CONCORD SERIES - F No 31(2) SHEET 10 of 99