



POOR ORIGINAL COPY

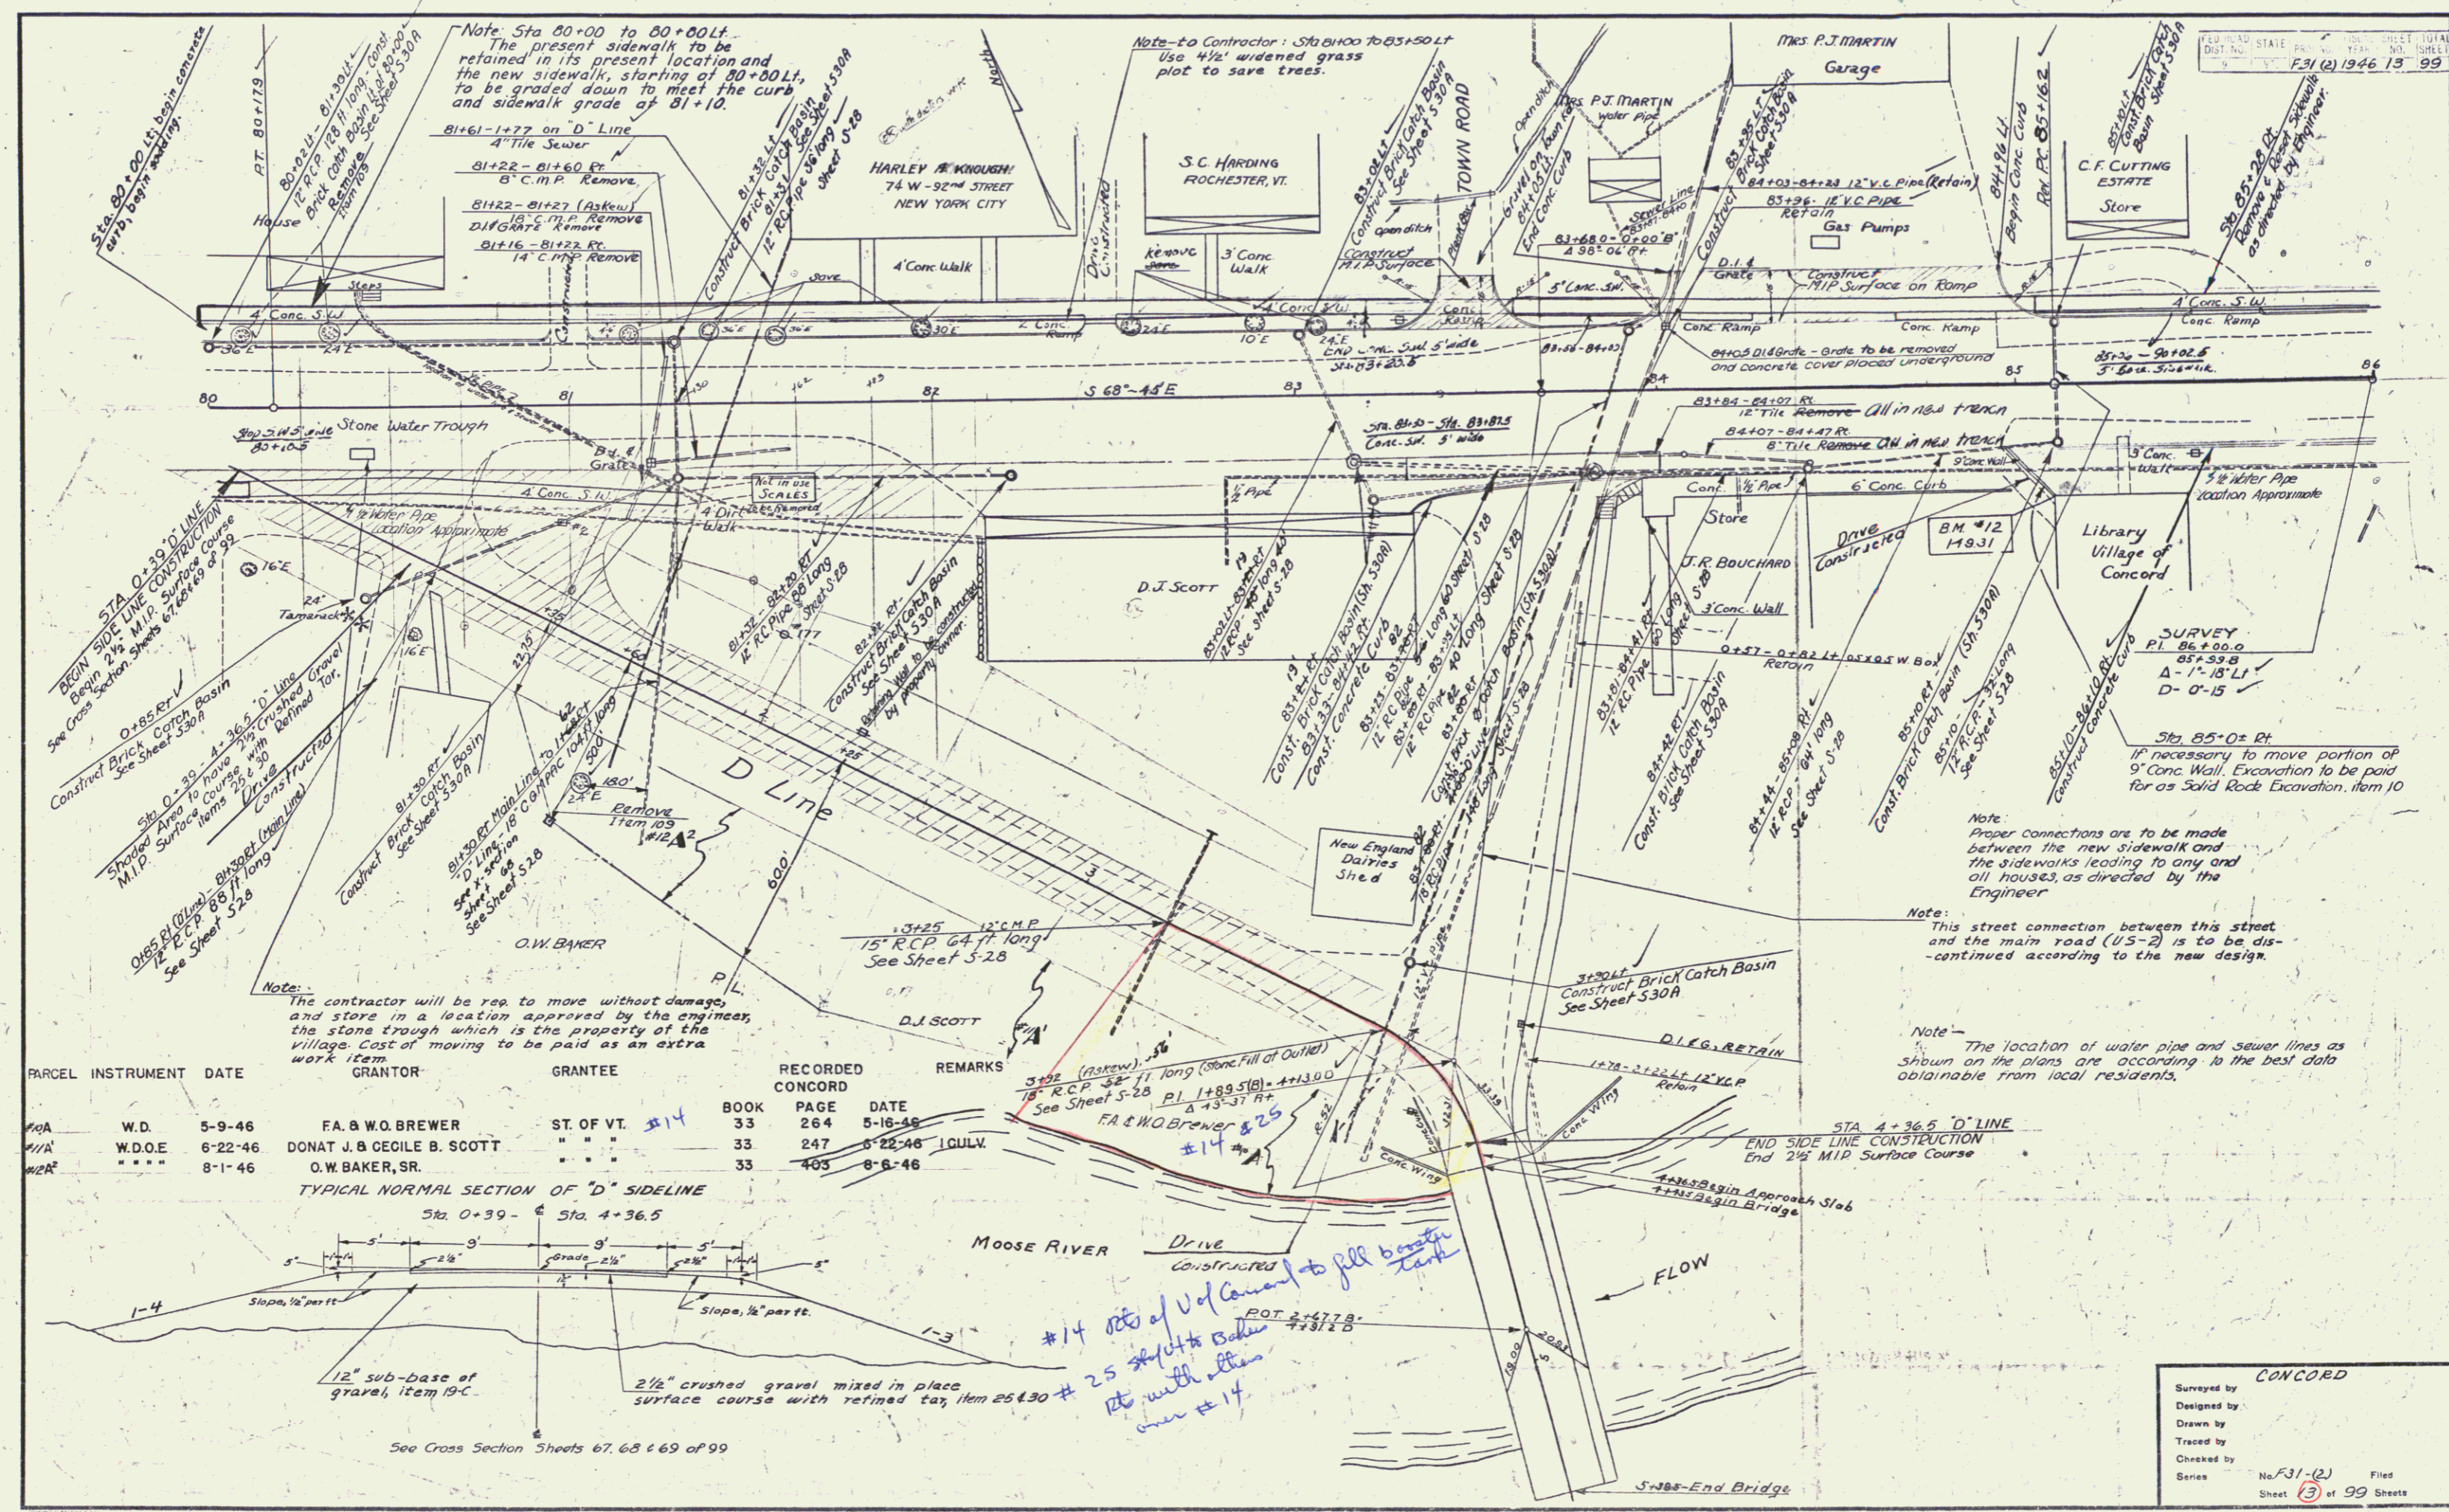

PARCEL	INSTRUMENT	DATE	GRANTOR	GRANTEE	RECORDED CONCORD	REMARKS
10A	W.D.	5-9-46	FA. & W.O. BREWER	ST. OF VT.	33 264	5-16-46
11A	W.D.O.E.	6-22-46	DONAT J. & CECILE B. SCOTT	"	33 247	6-22-46
12A	"	8-1-46	O.W. BAKER, SR.	"	33 403	8-8-46

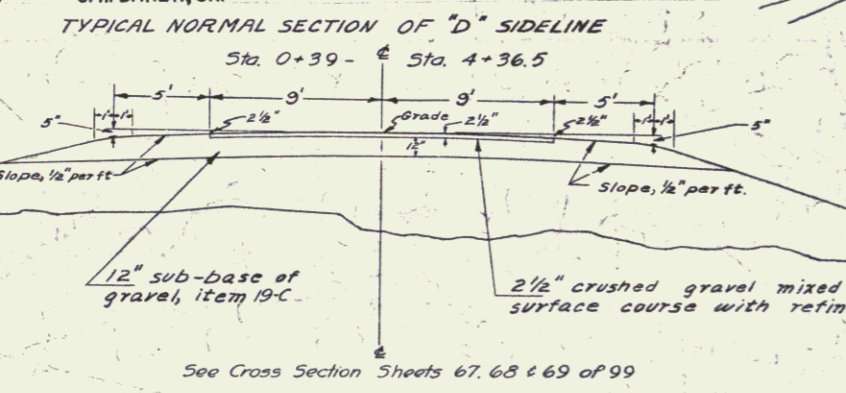

#14 sets of Vol Concord to fill bottom  
#25 sets of Vol Concord to fill bottom  
the width of the  
over #14.

CONCORD  
 Surveyed by  
 Designed by  
 Drawn by  
 Traced by  
 Checked by  
 Series No. F31-(2) Filed  
 Sheet 3 of 99 Sheets