


PARCEL	INSTRUMENT	DATE	GRANTOR	GRANTEE	BOOK	PAGE	RECORDED CONCORD	DATE	REMARKS
#14 A & B (SEE S-18)	W.D.O.E.	5-22-46	J.A. BEERWORTH	ST. OF VI.	33	245-246	6-22-46		
#15 A		5-20-46	LEOLA I. FORSAITH		33	246	6-22-46		

POOR ORIGINAL COPY

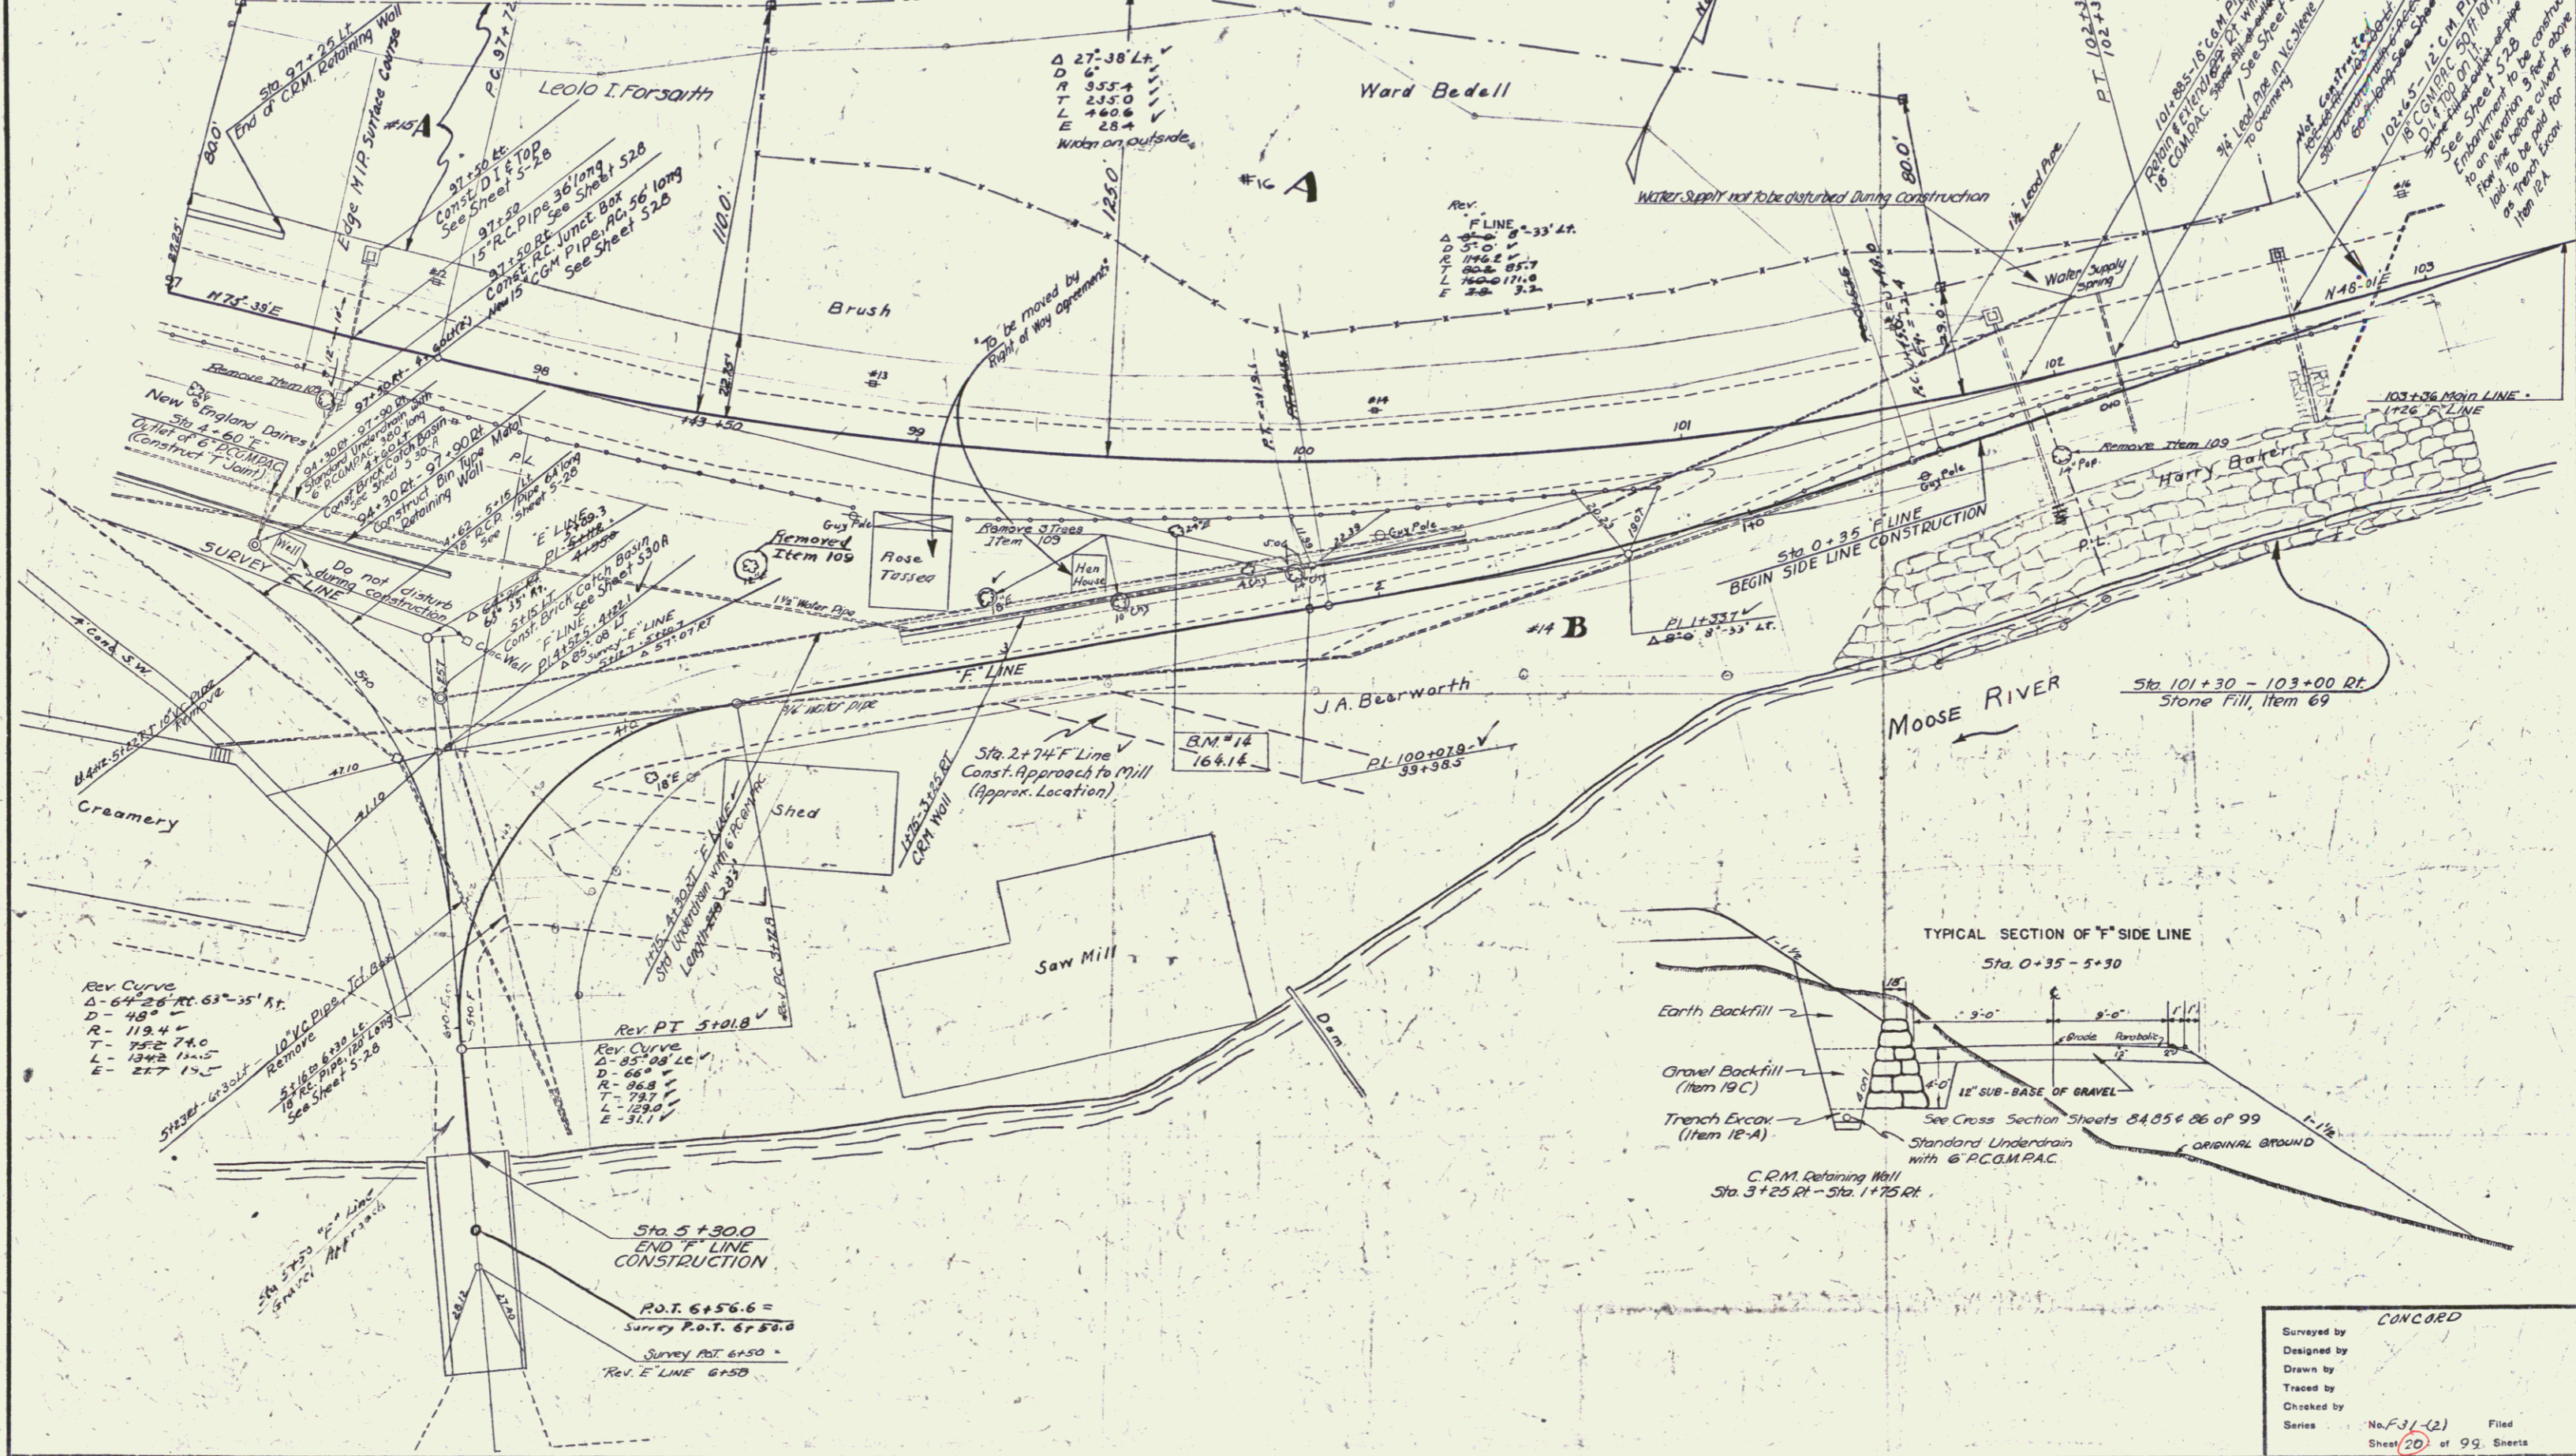

CONCORD
 Surveyed by
 Designed by
 Drawn by
 Traced by
 Checked by
 Series No. F-31-(2) Filed
 Sheet 20 of 99 Sheets