


$\Delta-11^{\circ}00'44''$
 $D-1^{\circ}45'$
 $R-3274.2$
 $T-315.3$
 $L-628.6$
 $E-132$



Sta. 112+98.9 = Sta. 113+50
 End F 31(2) FAP 131-B(2)

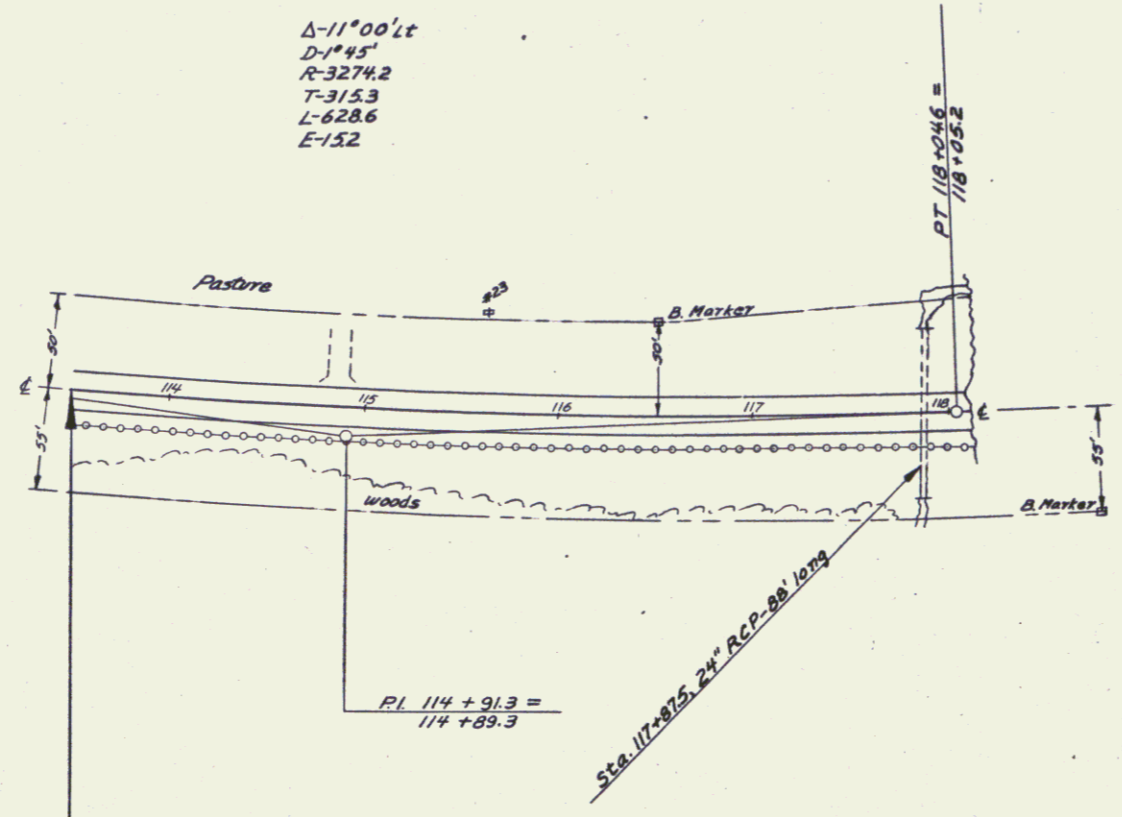