
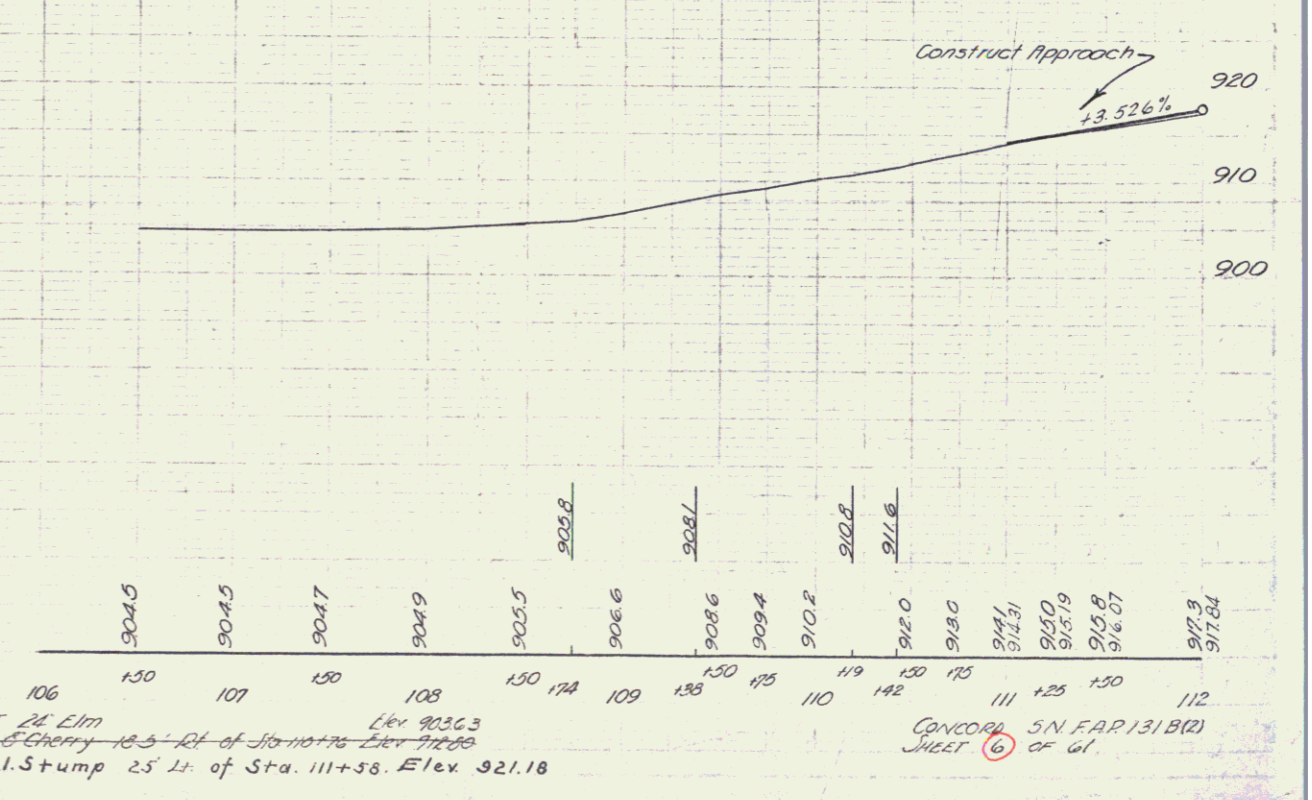


S. Cherry 10-5-1942  
 L. L. Linn  
 2-41

R. B. Baker  
 L. Linn  
 2-41

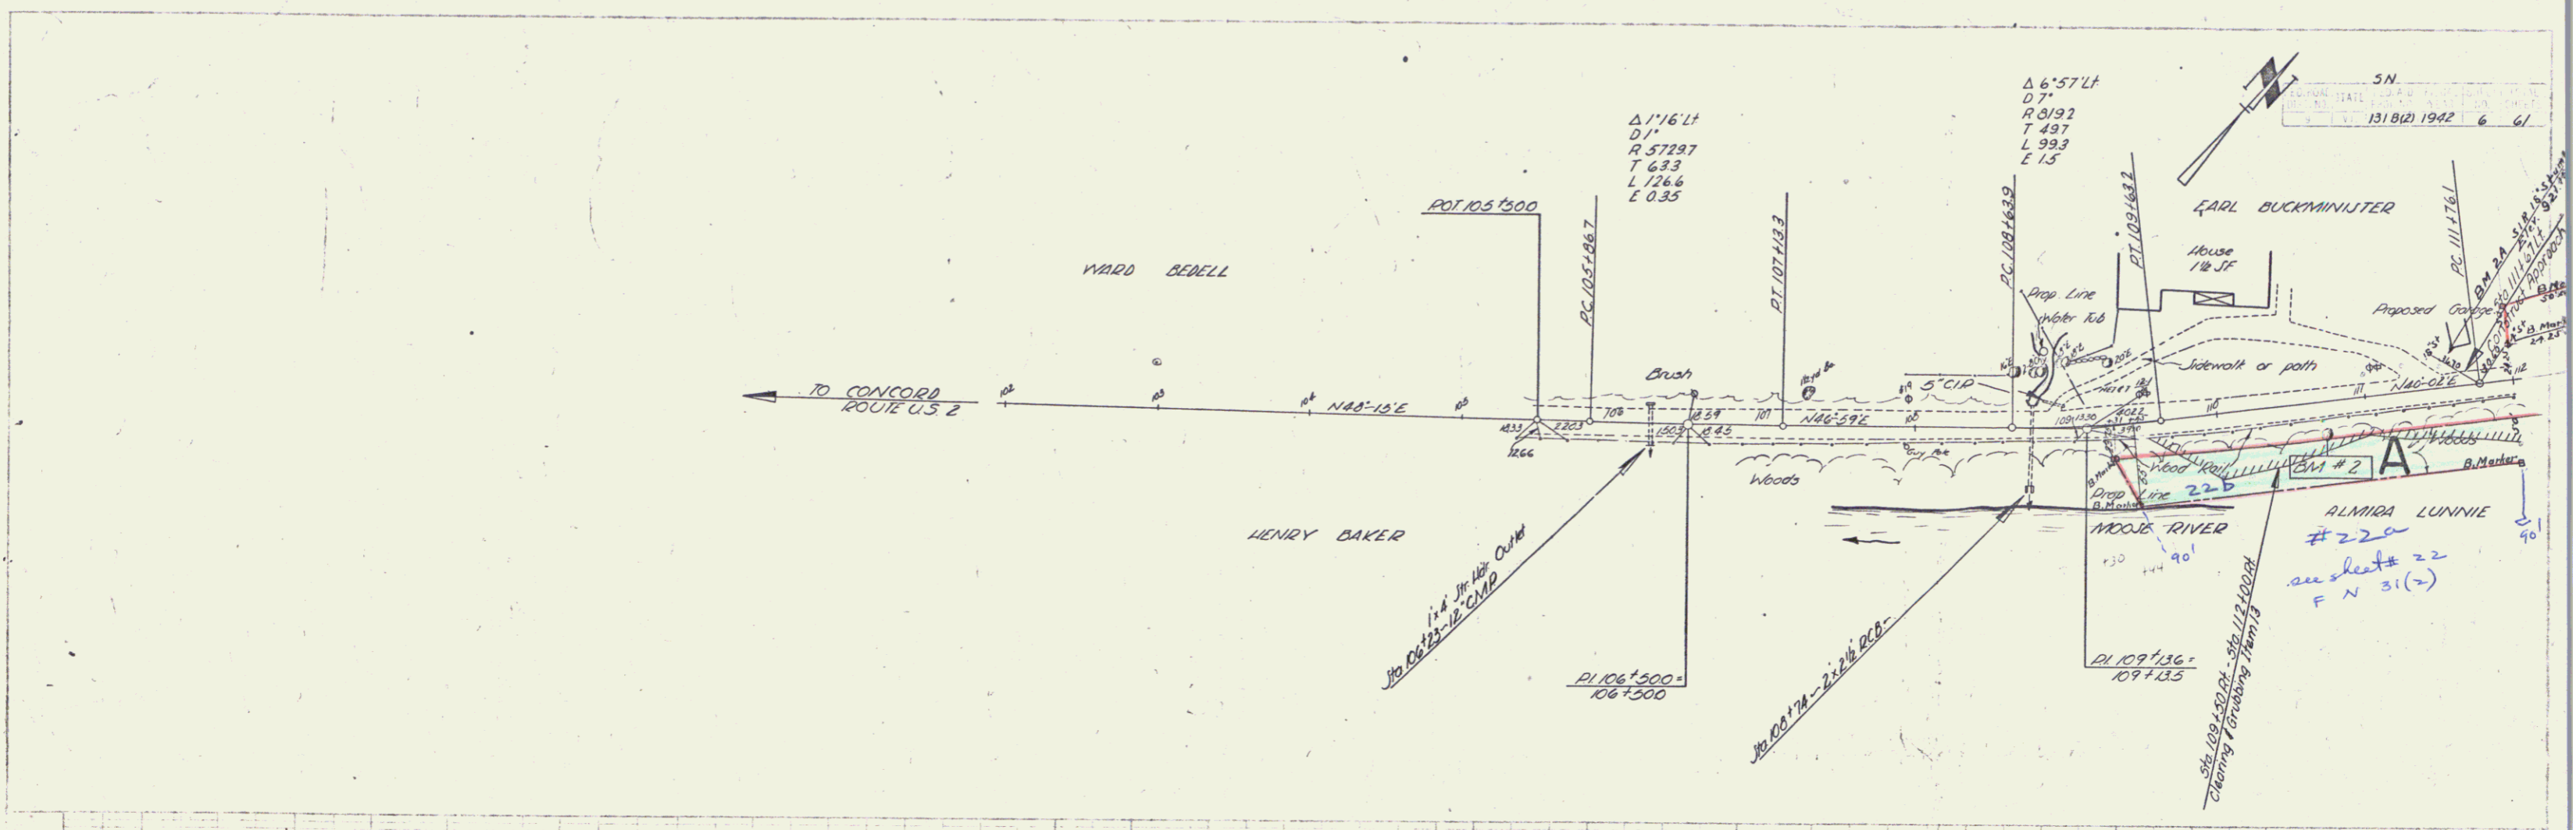

2A S.I. Stump 25 ft. of Sta. 111+58. Elev. 921.18  
 CONCORD 5N FAR 1318(2)  
 SHEET 6 OF 61