
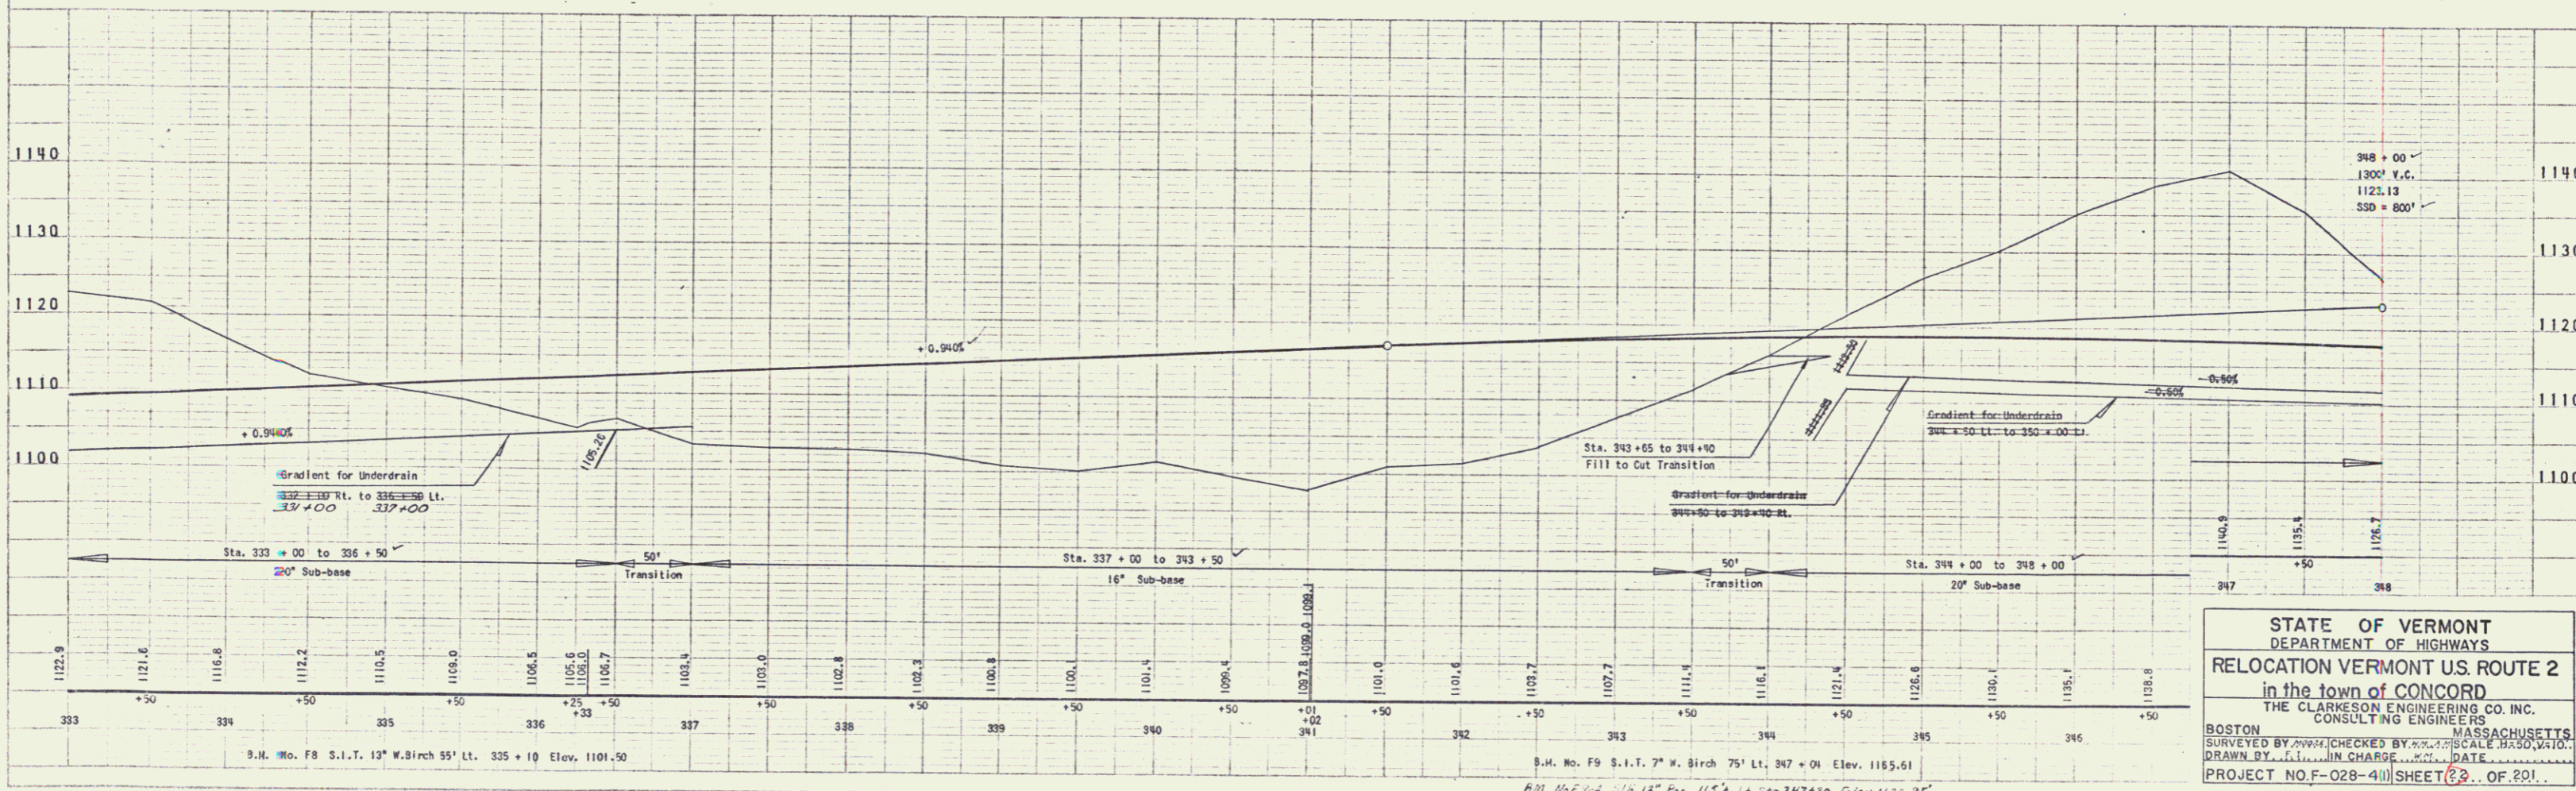


PLAN  
 MOORE  
 A.M.  
 11/15/50

MOORE  
 A.M.  
 11/15/50

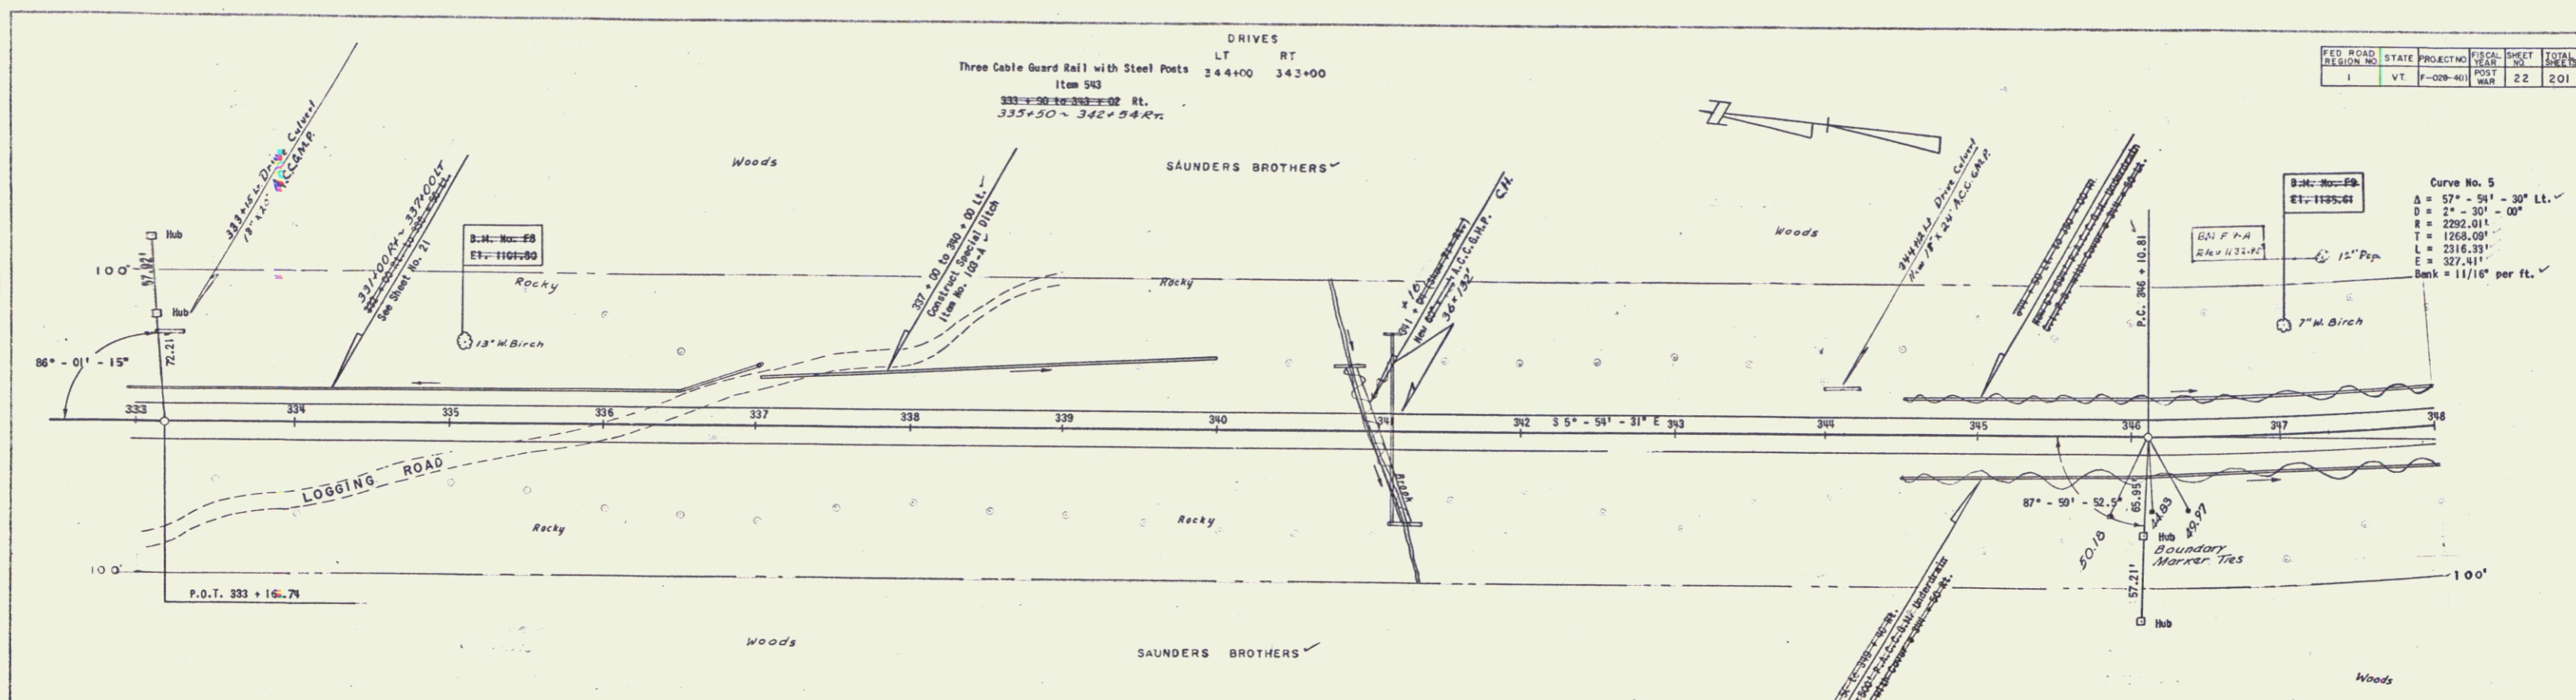

STATE OF VERMONT  
 DEPARTMENT OF HIGHWAYS  
 RELOCATION VERMONT U.S. ROUTE 2  
 in the town of CONCORD  
 THE CLARKSON ENGINEERING CO. INC.  
 CONSULTING ENGINEERS  
 BOSTON MASSACHUSETTS  
 SURVEYED BY [ ] CHECKED BY [ ] SCALE BASED, V.A.D.  
 DRAWN BY [ ] IN CHARGE DATE [ ]  
 PROJECT NO. F-028-4(1) SHEET 22 OF 201.

14