


MOORE
SWIFT
MONTGOMERY
WATSON
A.
CONCORD, VT.



FED. ROAD DISTRICT NO.	STATE	PROJECT NO.	SHEET NO.	TOTAL SHEETS
1	VT.	F-028-401	24	201

MOORE
SWIFT
MONTGOMERY
WATSON
A.
CONCORD, VT.

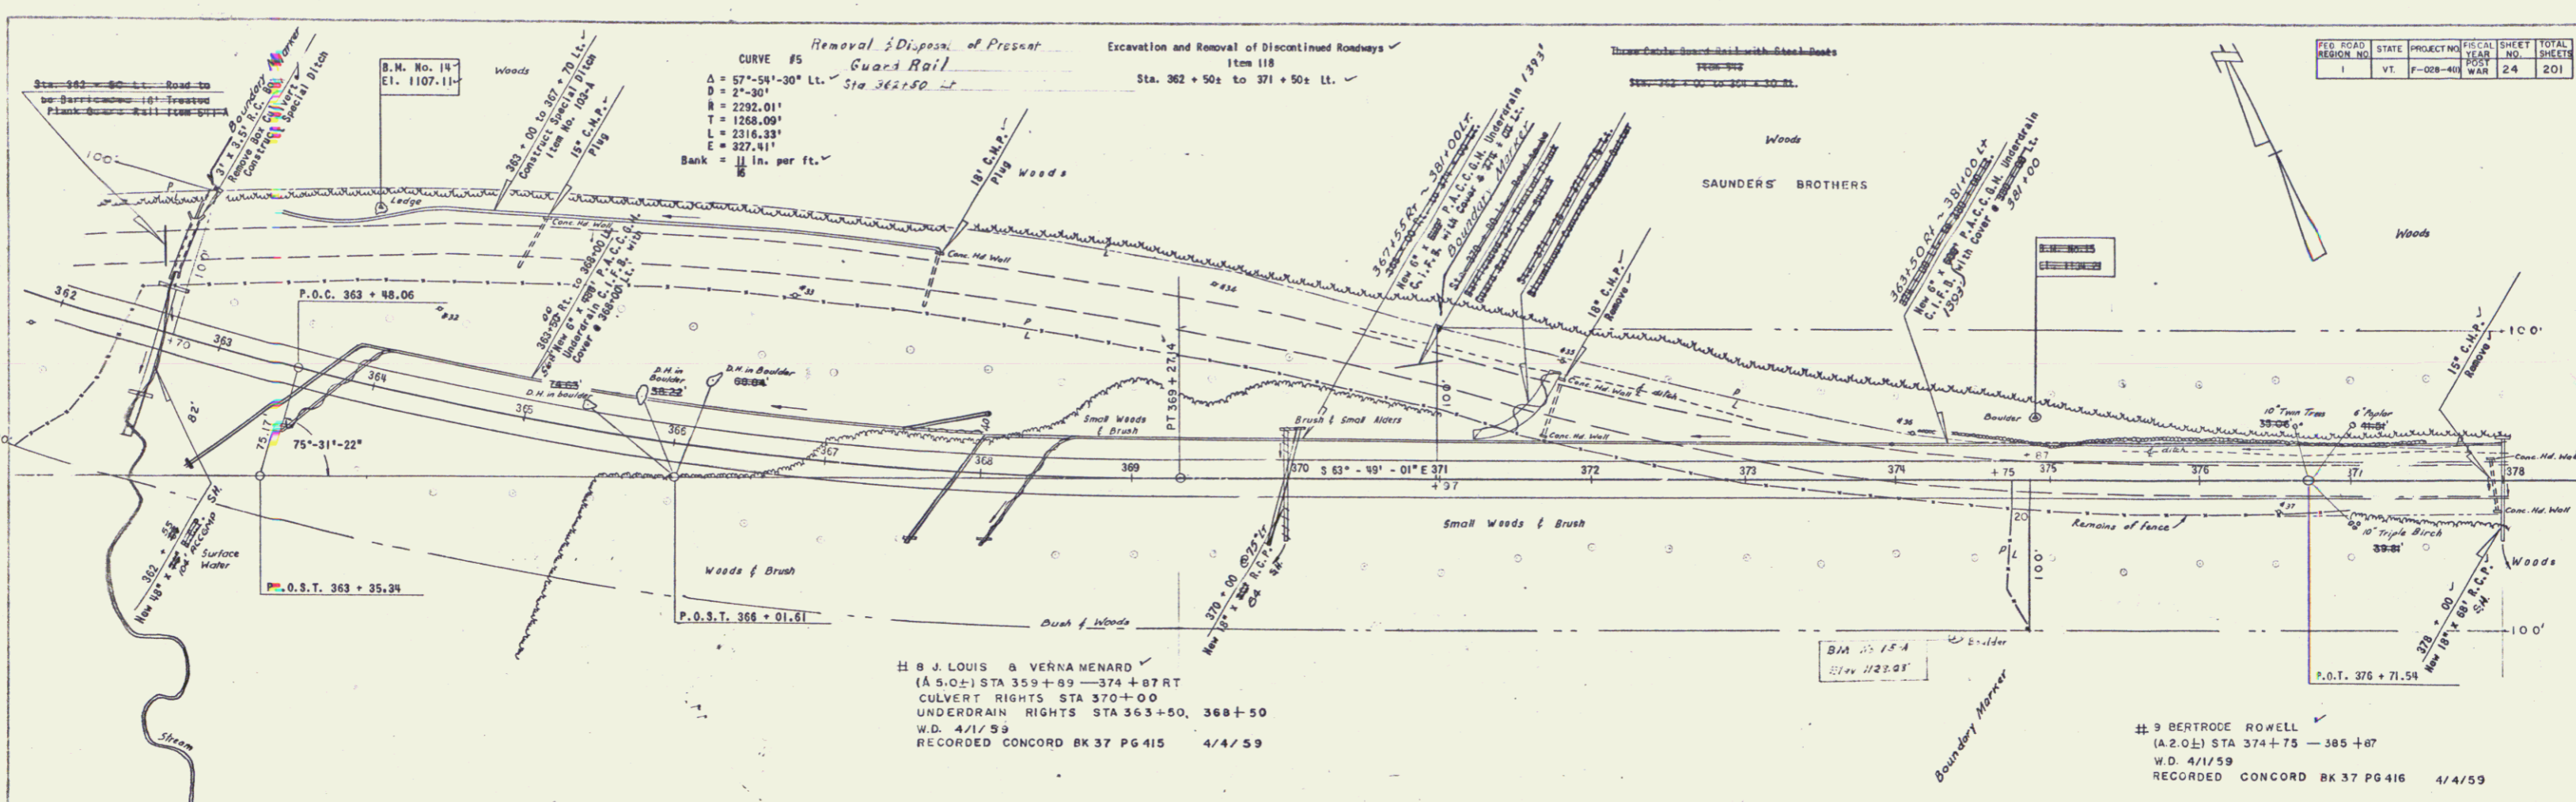