


Control of section of former U.S. Route 2 beginning of a point in the center of former U.S. Route 2, 50' ± right of approximate survey station 395+50 of Highway Project Concord F-028-4(1) and extending easterly along the center line of said former travelled way 0.11 miles to a point 90' ± right of approximate survey station 401+00 of said Highway Project is hereby relinquished and returned to the town of Concord and recorded in Book 5 Page 311 of Land Records of the town of Concord on September 27, 1961.

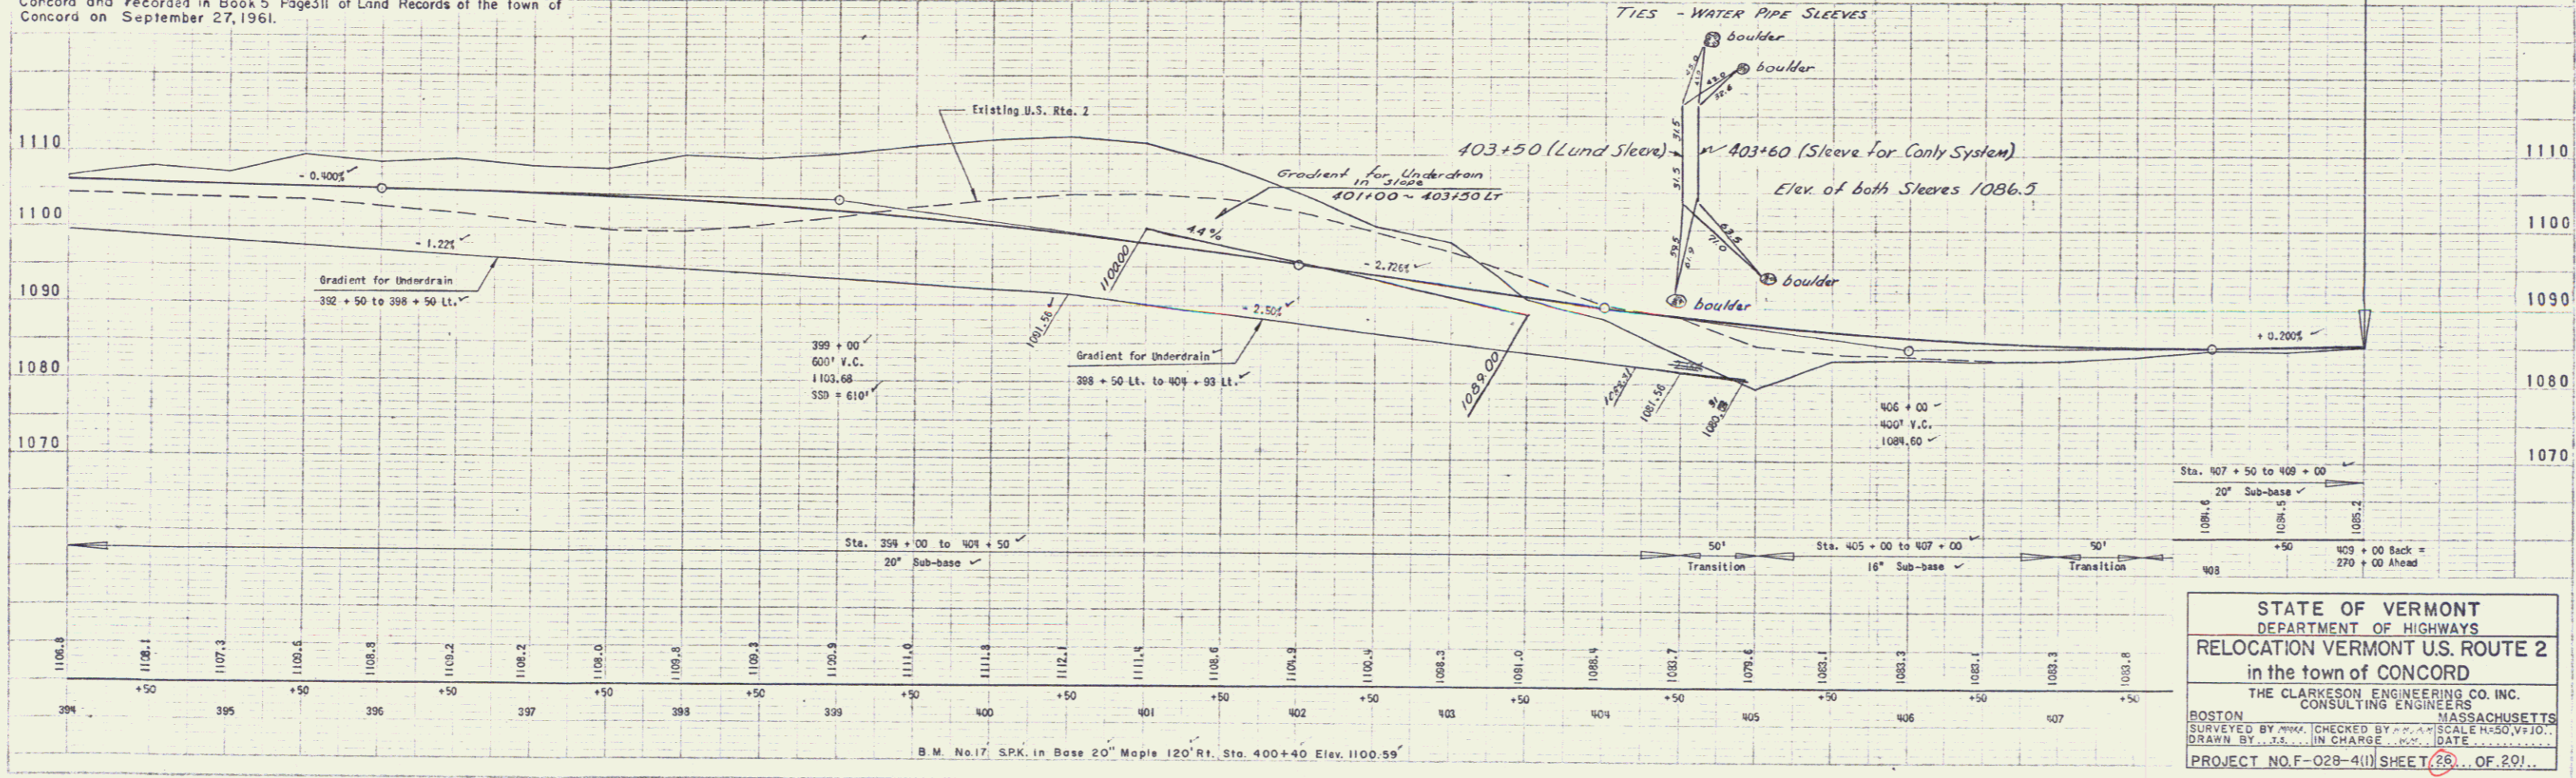

STATE OF VERMONT
 DEPARTMENT OF HIGHWAYS
 RELOCATION VERMONT U.S. ROUTE 2
 in the town of CONCORD

THE CLARKSON ENGINEERING CO. INC.
 CONSULTING ENGINEERS
 BOSTON MASSACHUSETTS

SURVEYED BY [Name] CHECKED BY [Name] SCALE H=50, V=10
 DRAWN BY [Name] IN CHARGE [Name] DATE [Date]

PROJECT NO. F-028-4(1) SHEET 26 OF 20