
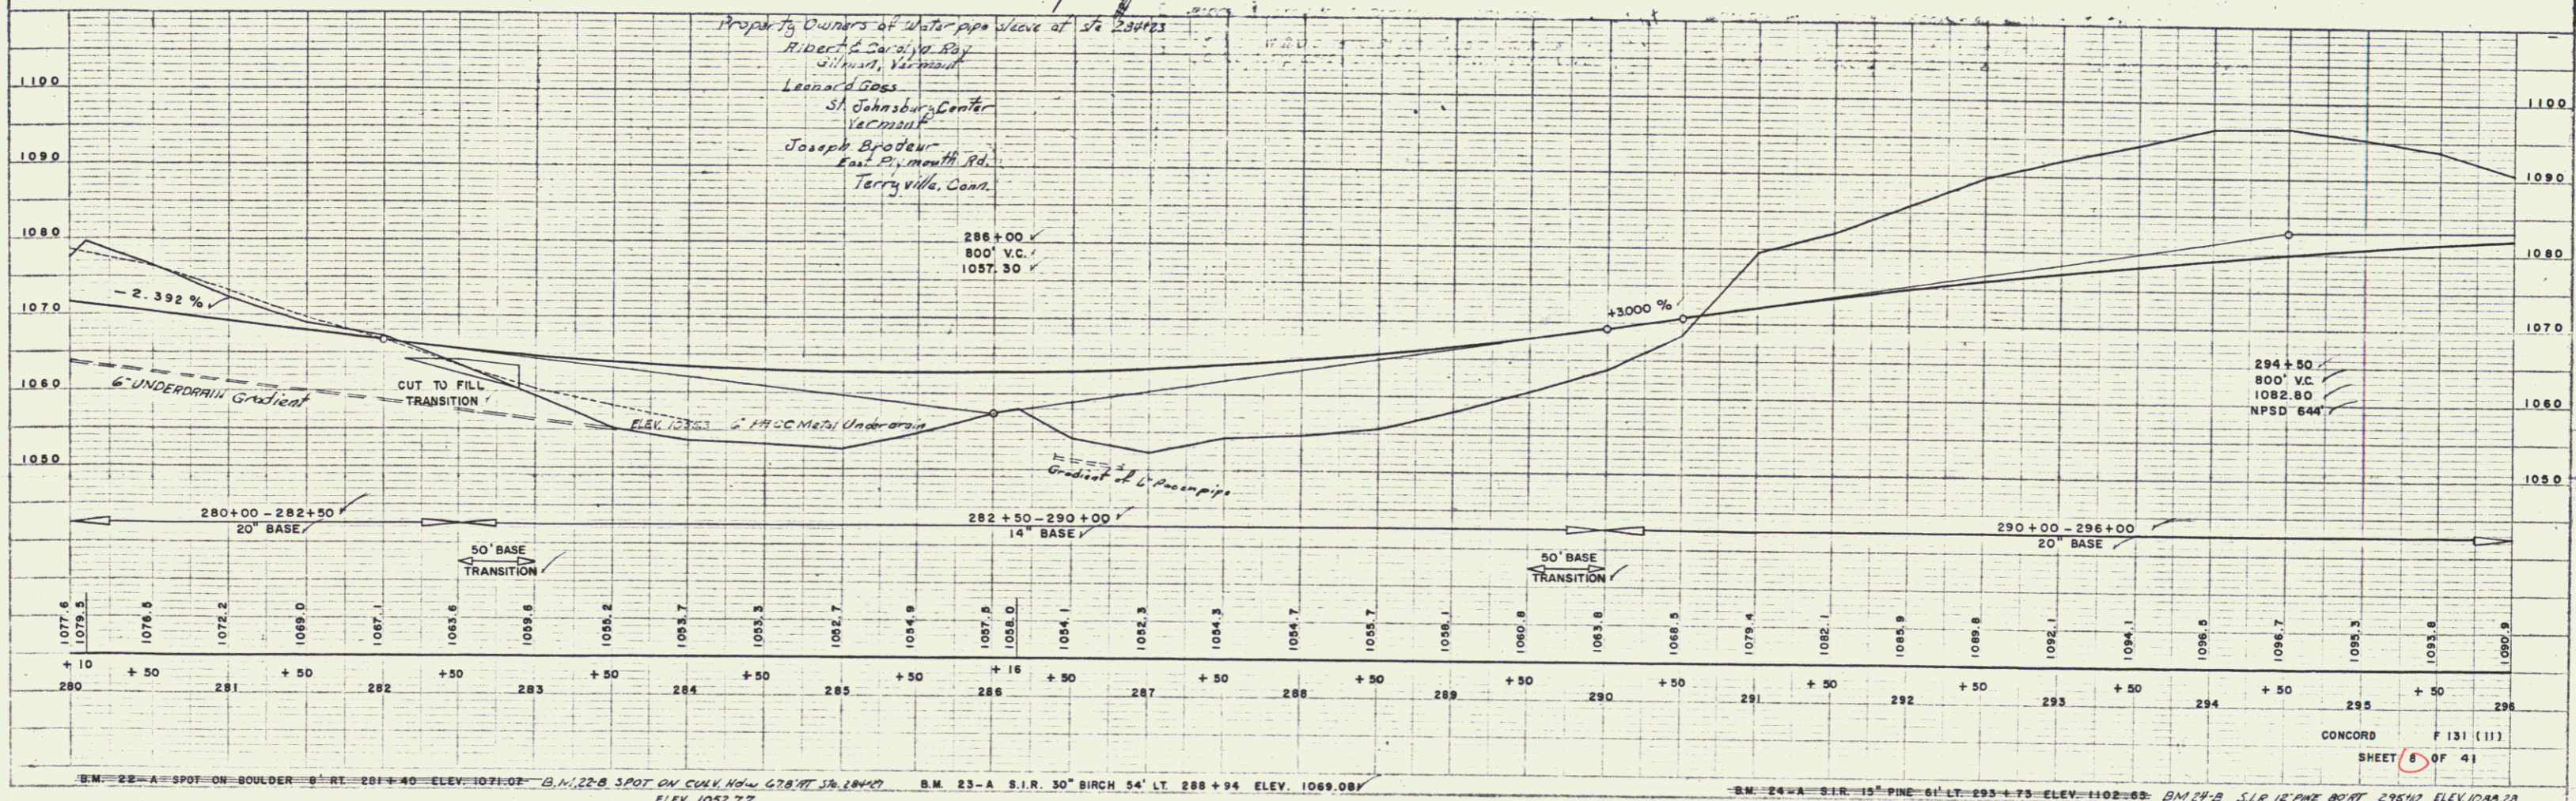


PLAN
 DATE: 11/1/56
 DRAWN BY: W. H. MURPHY
 CHECKED BY: W. H. MURPHY
 SCALE: AS SHOWN

PROFILE
 DATE: 11/1/56
 DRAWN BY: W. H. MURPHY
 CHECKED BY: W. H. MURPHY
 SCALE: AS SHOWN

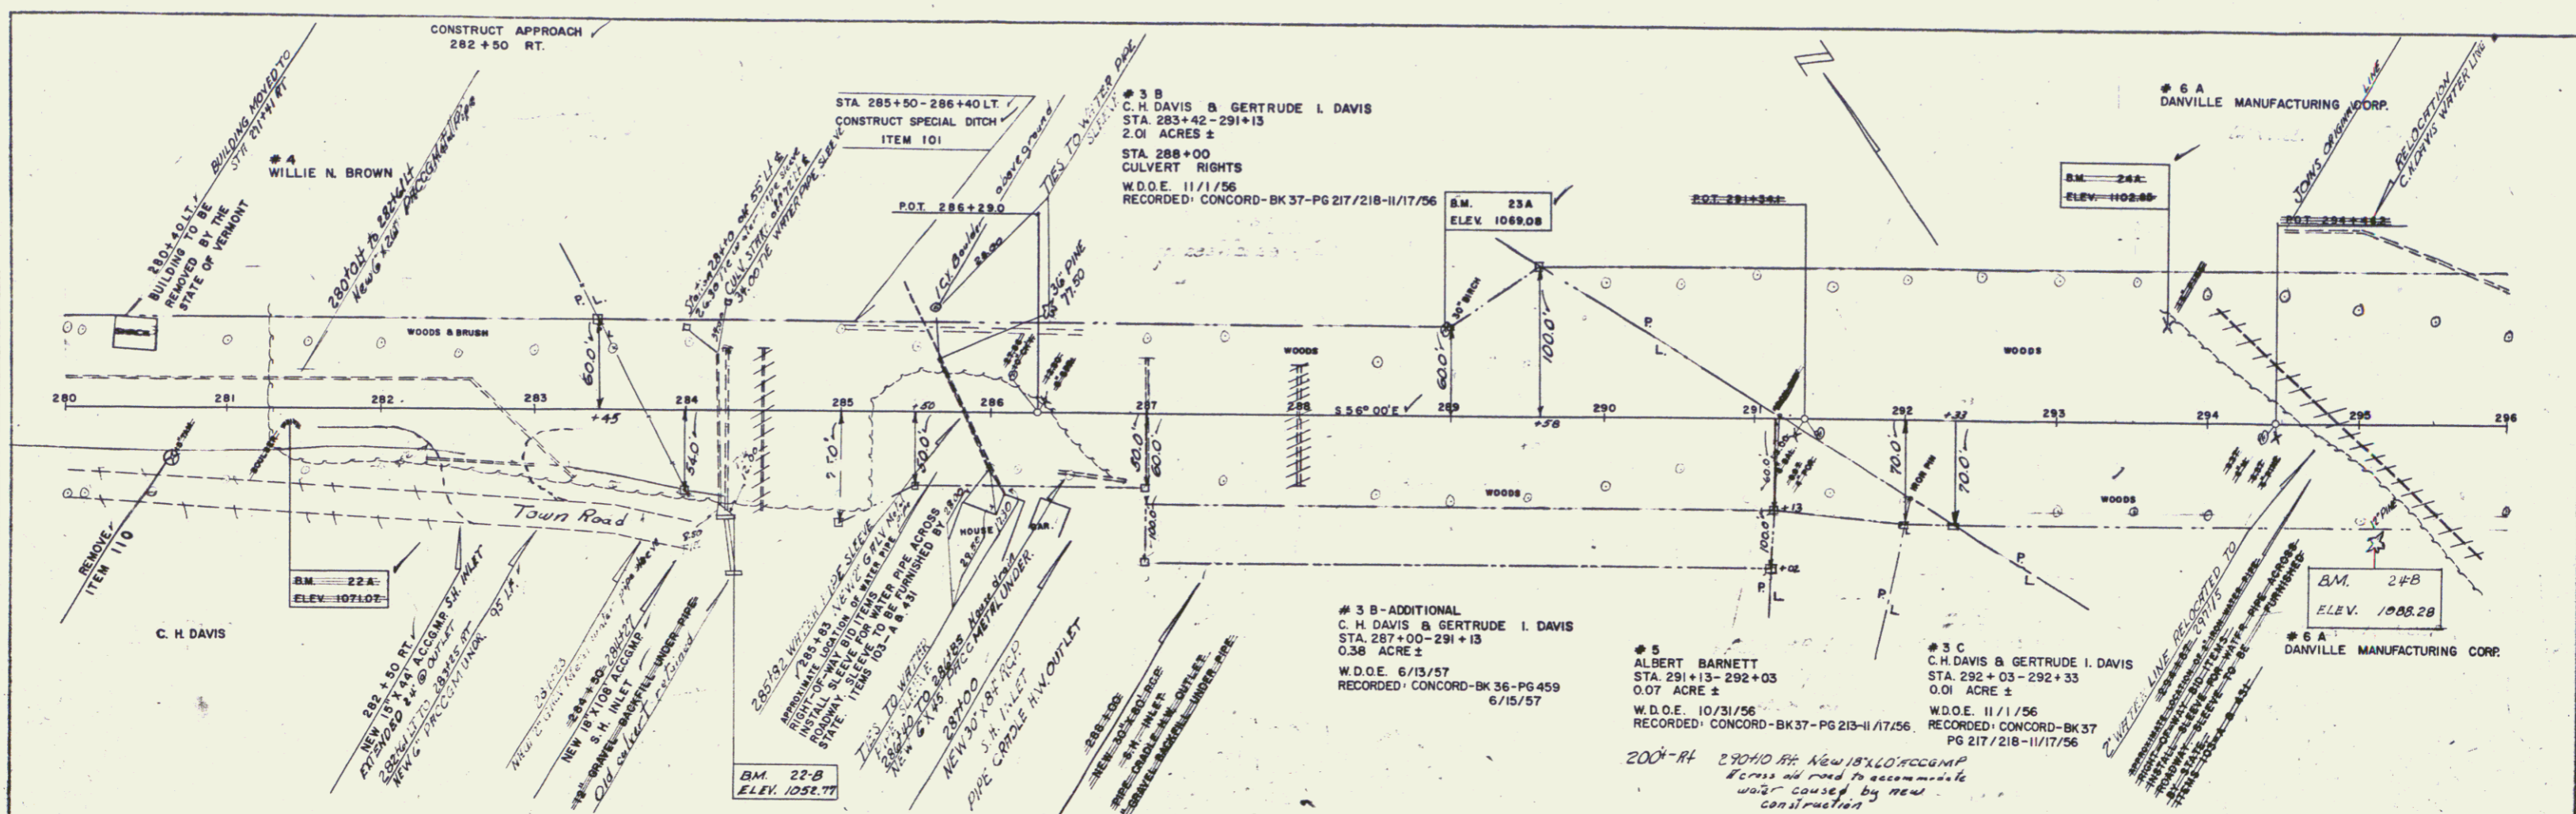

B.M. 22-A SPOT ON BOULDER 8' RT. 281+40 ELEV. 1071.07 B.M. 22-B SPOT ON CULV. NEW 6" P.C. 284+00 ELEV. 1052.77 B.M. 23-A S.I.R. 30" BIRCH 54' LT. 288+94 ELEV. 1069.08 B.M. 24-A S.I.R. 15" PINE 61' LT. 293+75 ELEV. 1102.60 B.M. 24-B S.I.R. 12" PINE BENT 295+02 ELEV. 1088.28

3