
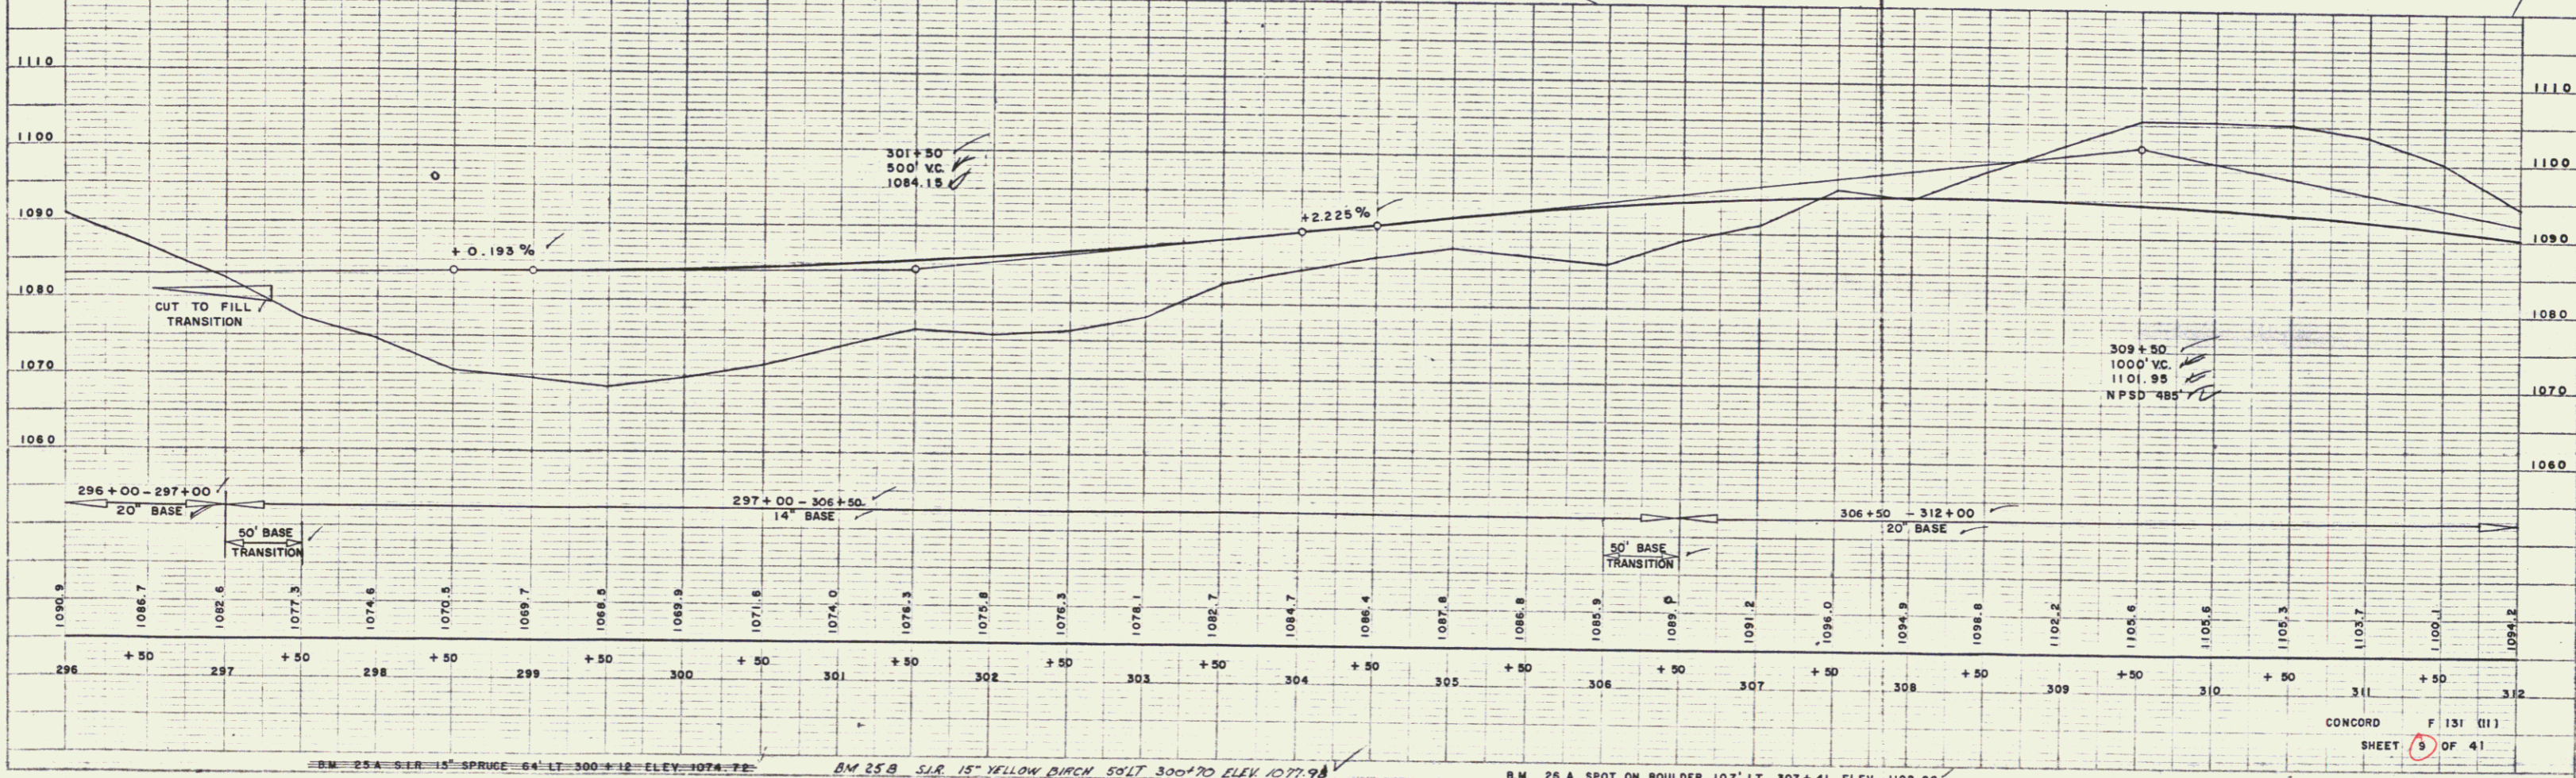


PLAN
 DRAWN BY: SPALDING
 CHECKED BY: WEBSTER-MARTIN, INC.
 DATE: 12-28
 NOTE BOOK: 100-100-100
 INT. OR W.P. CHECKED:

PROFILE
 DRAWN BY: SPALDING
 CHECKED BY: WEBSTER-MARTIN, INC.
 DATE: 12-28
 NOTE BOOK: 100-100-100
 INT. OR W.P. CHECKED:

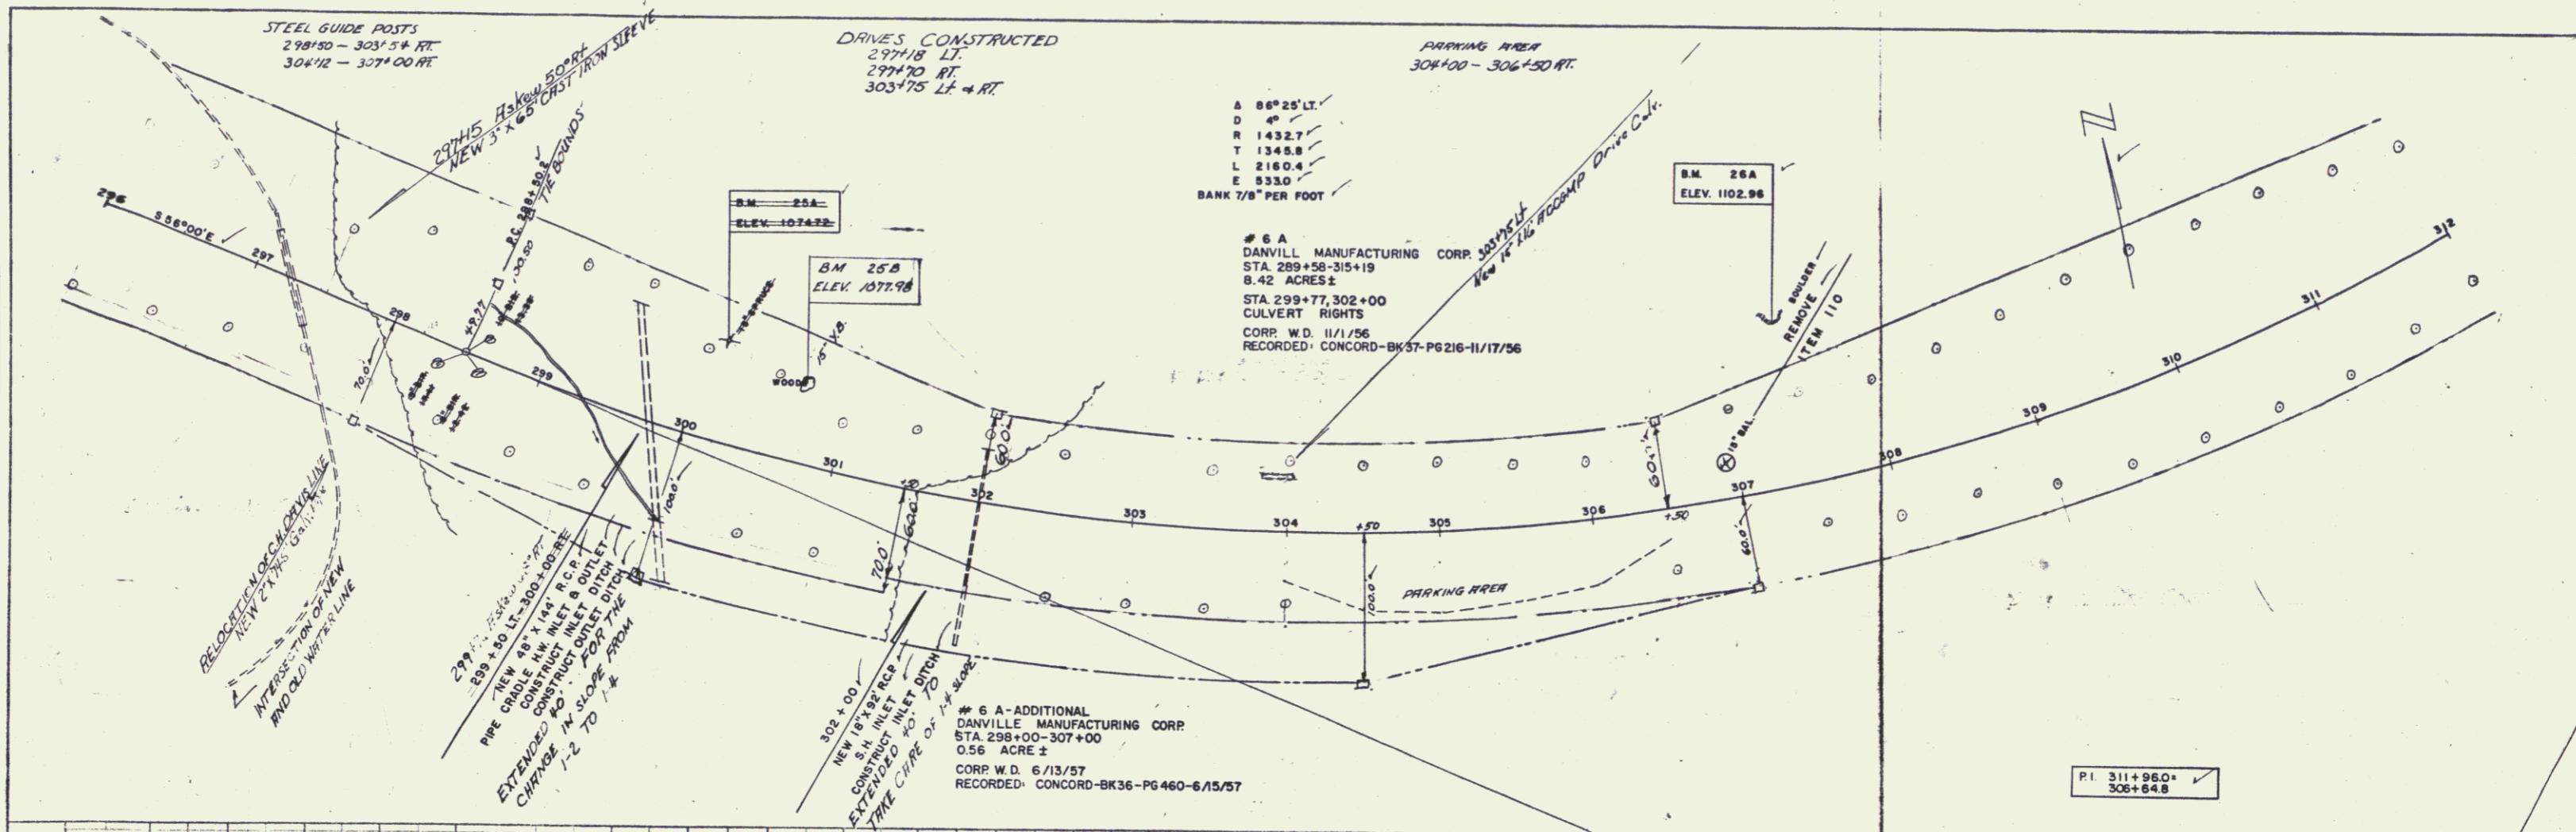

CONCORD F 131 (11)
 SHEET 9 OF 41

4