
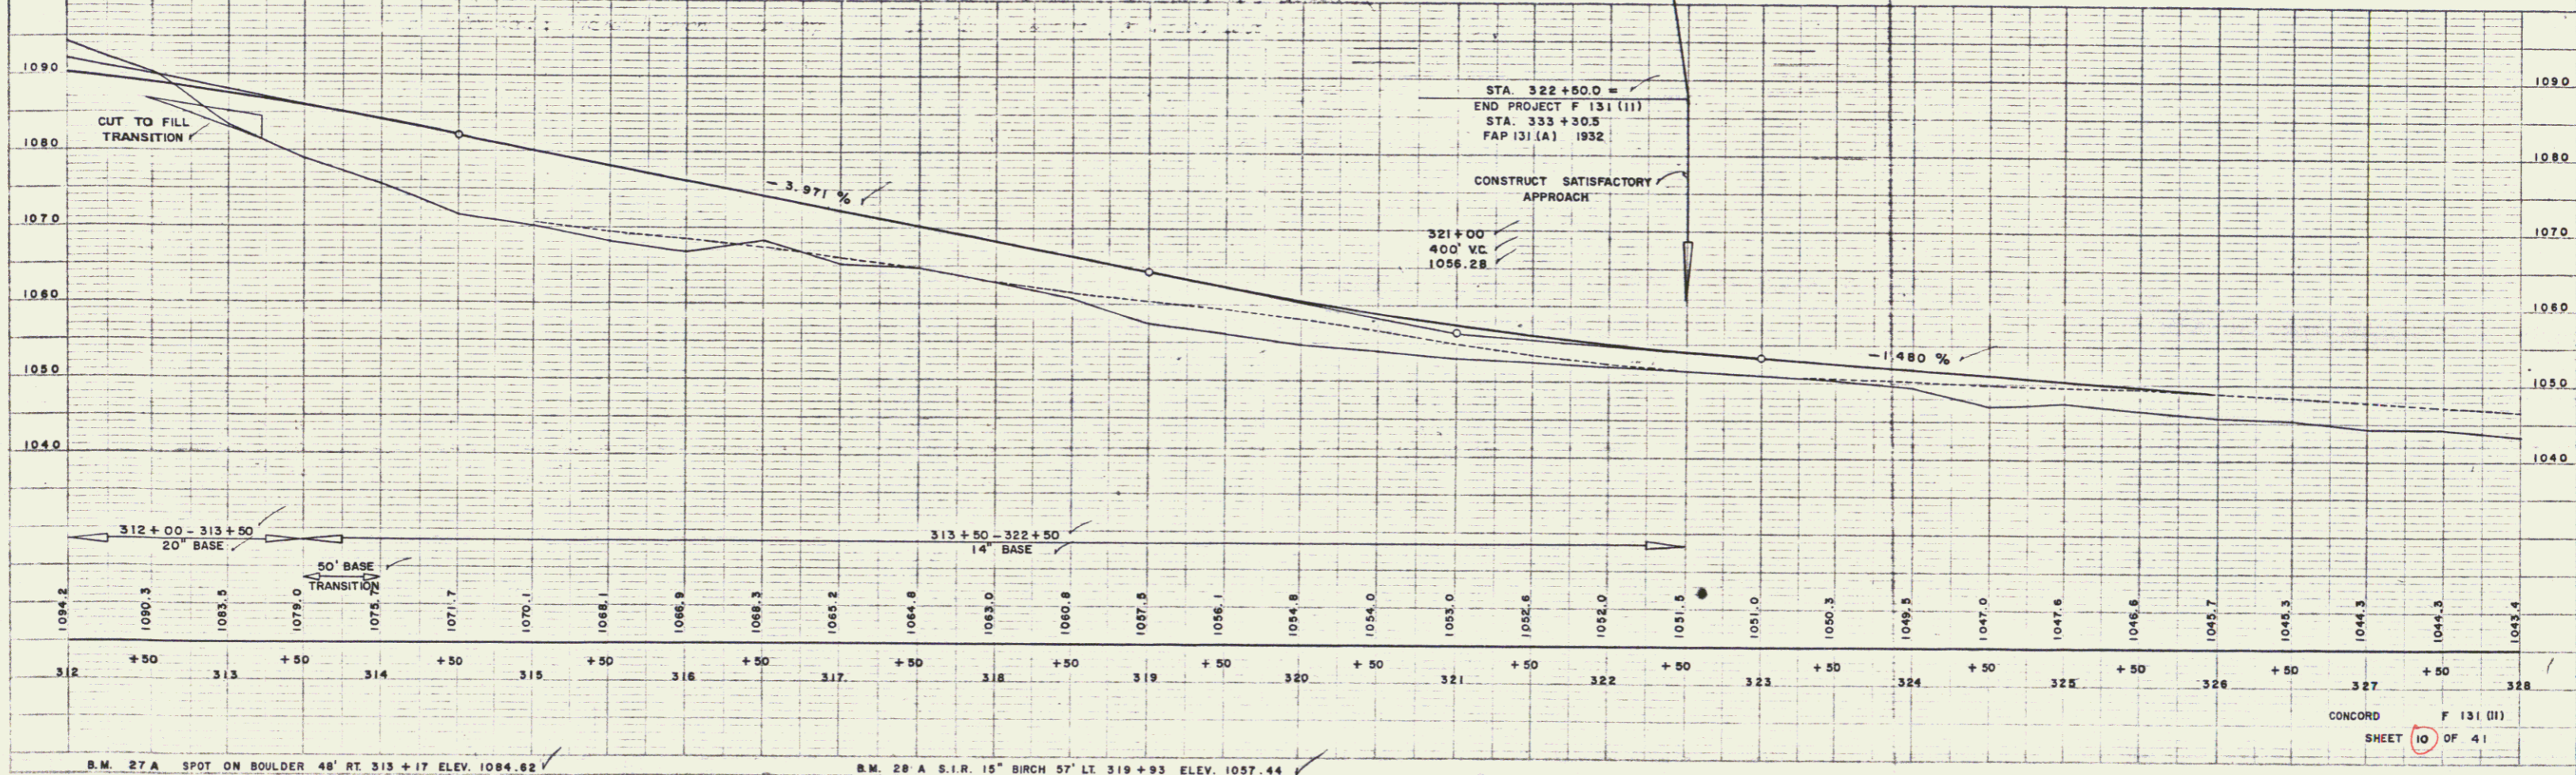


PLAN
 SCALE: AS SHOWN
 DATE: 11-1-56
 DRAWN BY: J. J. STANLEY
 CHECKED BY: W. B. MARTIN, INC.

PROFILE
 SCALE: AS SHOWN
 DATE: 11-1-56
 DRAWN BY: J. J. STANLEY
 CHECKED BY: W. B. MARTIN, INC.

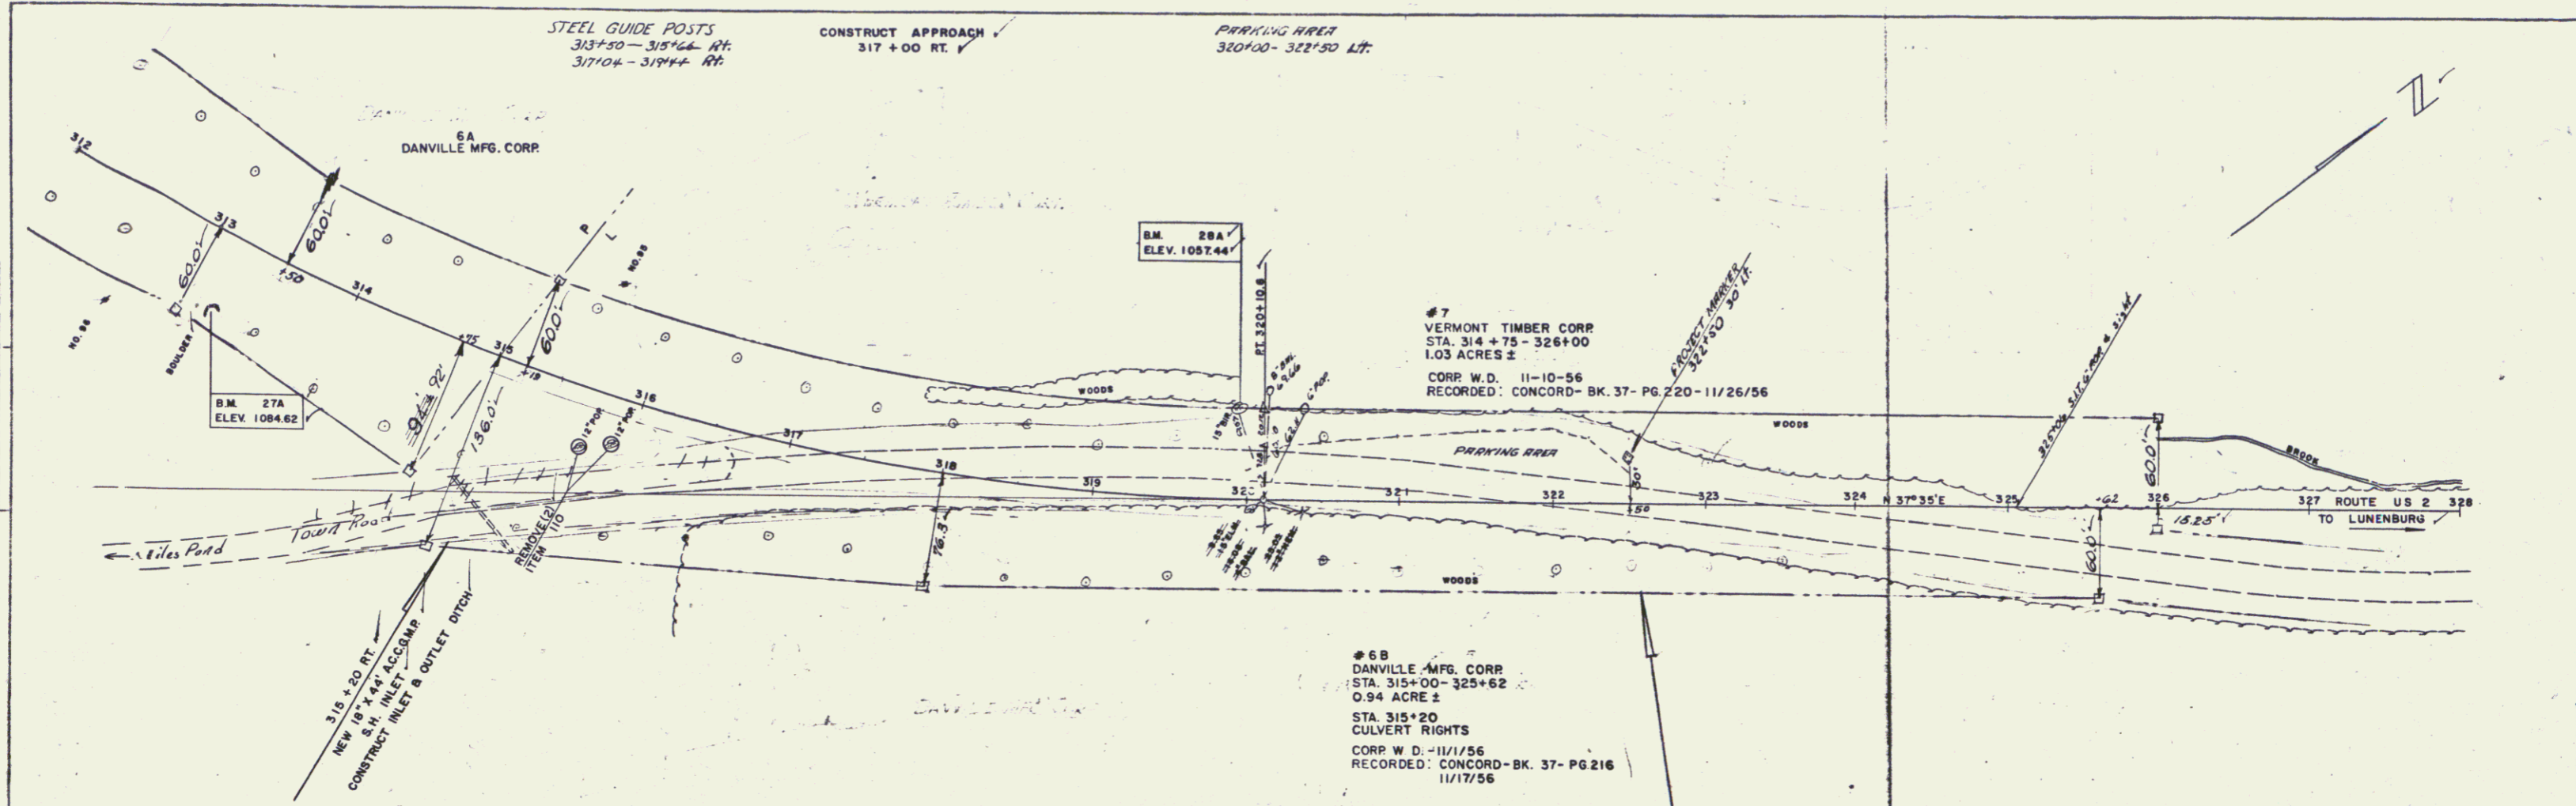

5