
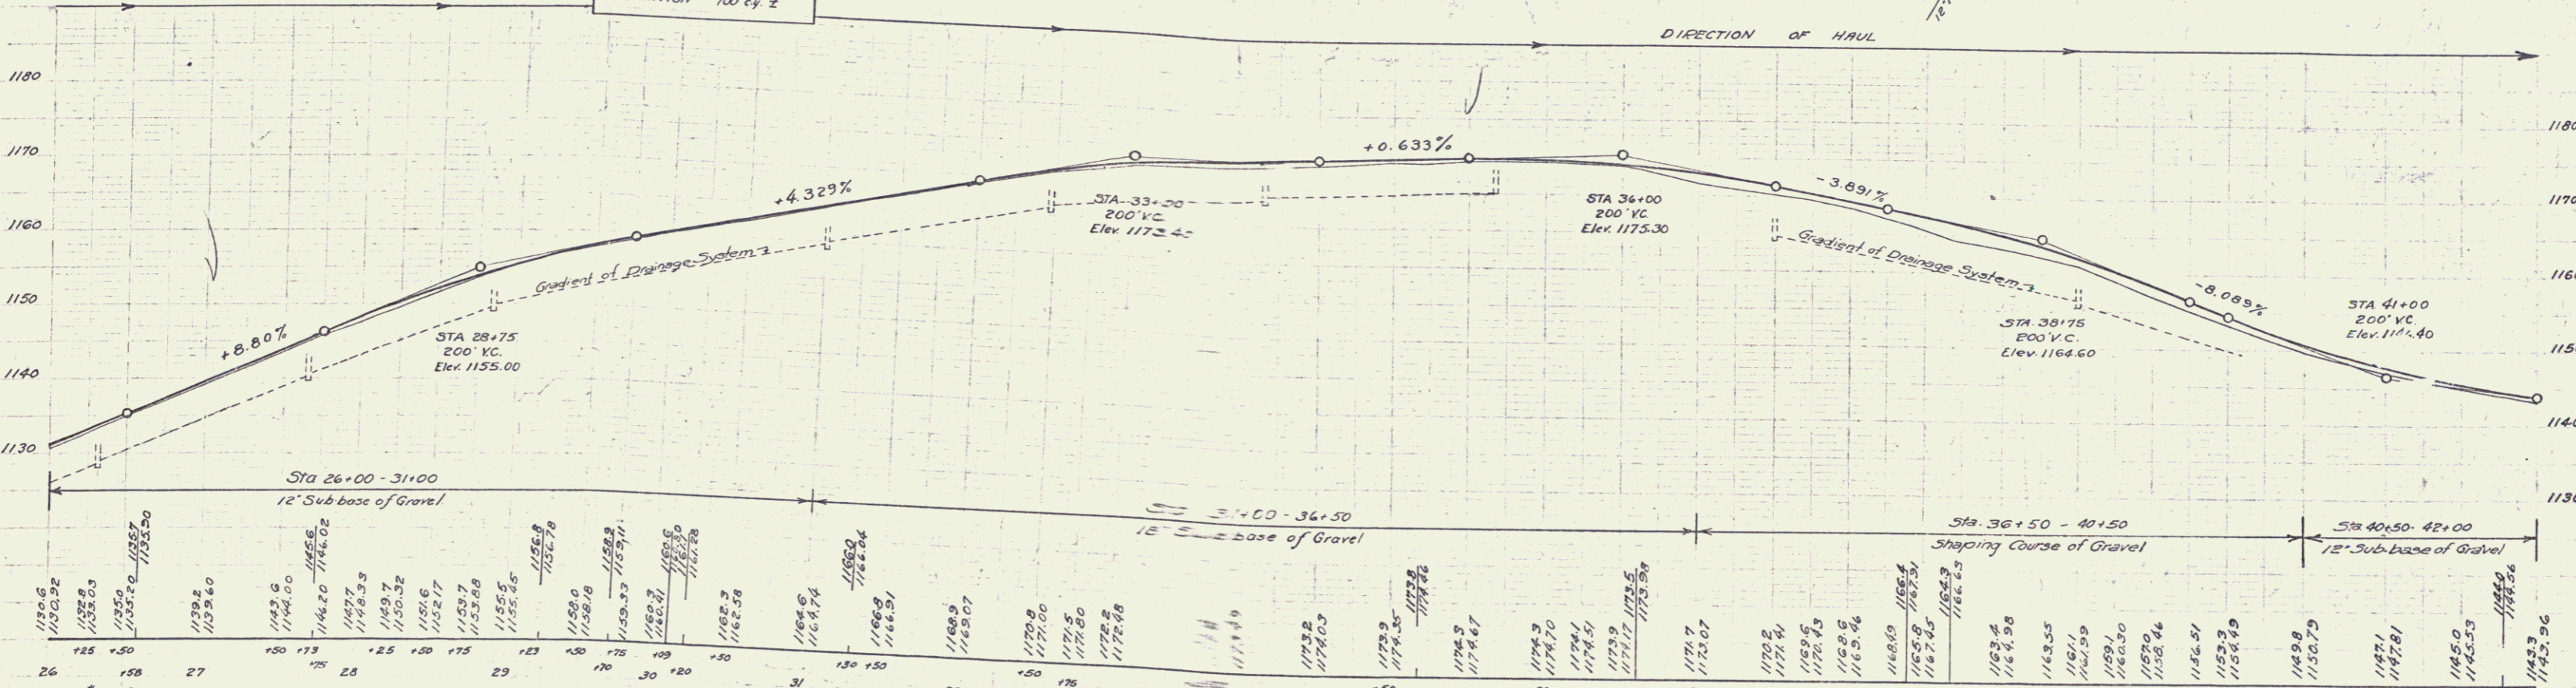


Parcel Kind of Date of Grantor Grantee Recorded Remarks
 Instrument Lunenburg Book Page Date
 Cdn. #1 A.C.D. 8-14-32 H.T. & C.B. Sibley St. of Yt. JA 167 8-15-32 Cdn. Sta. A-115

STATE OF MASSACHUSETTS
 COUNTY OF LUNENBURG
 SHEET NO. 68
 131-C 1932 T 68

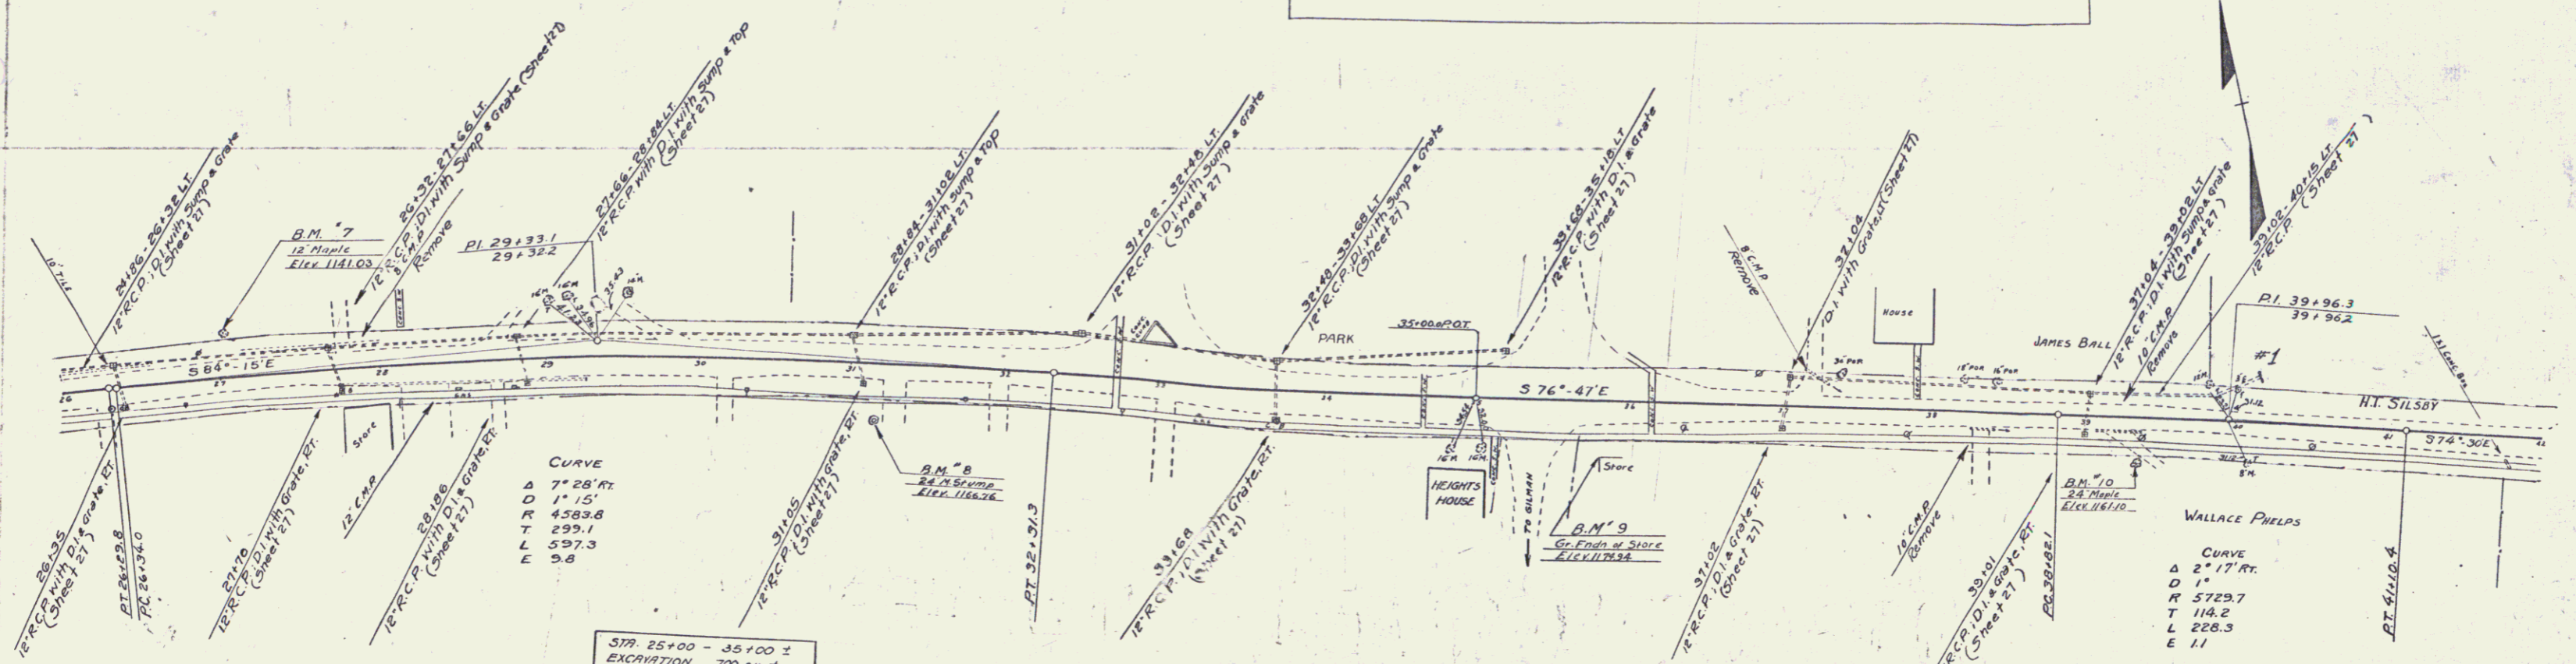

B.M. #7 SPIKE IN ROOT OF 12" MAPLE, 28' LT. OF STA. 27+04 - ELEV. 1141.03
 B.M. #8 SPIKE IN 24" MAPLE STUMP, 35' RT. OF STA. 31+15 - ELEV. 1166.76
 B.M. #9 POINT SPOT ON GRANITE FOUND AT STORE IN LUNENBURG, 38' RT. OF STA. 35+80 - ELEV. 1174.94
 B.M. #10 SPIKE IN ROOT OF 24" MAPLE 28' RT. OF STA. 39+34 - ELEV. 1161.10

SERIES F. NO 131-C
 Sheet D of 68

5