



Parcel	Date of Grant	Grantor	Grantee	Recorded	Remarks
A, B, C, D, E, F, G, H, I, J, K, L, M, N, O, P, Q, R, S, T, U, V, W, X, Y, Z	1-25-33	E. E. Bisbee	St. of Ft. Lumburg	Book 127, Page 12	12-19-33

131-C 1932 18 68

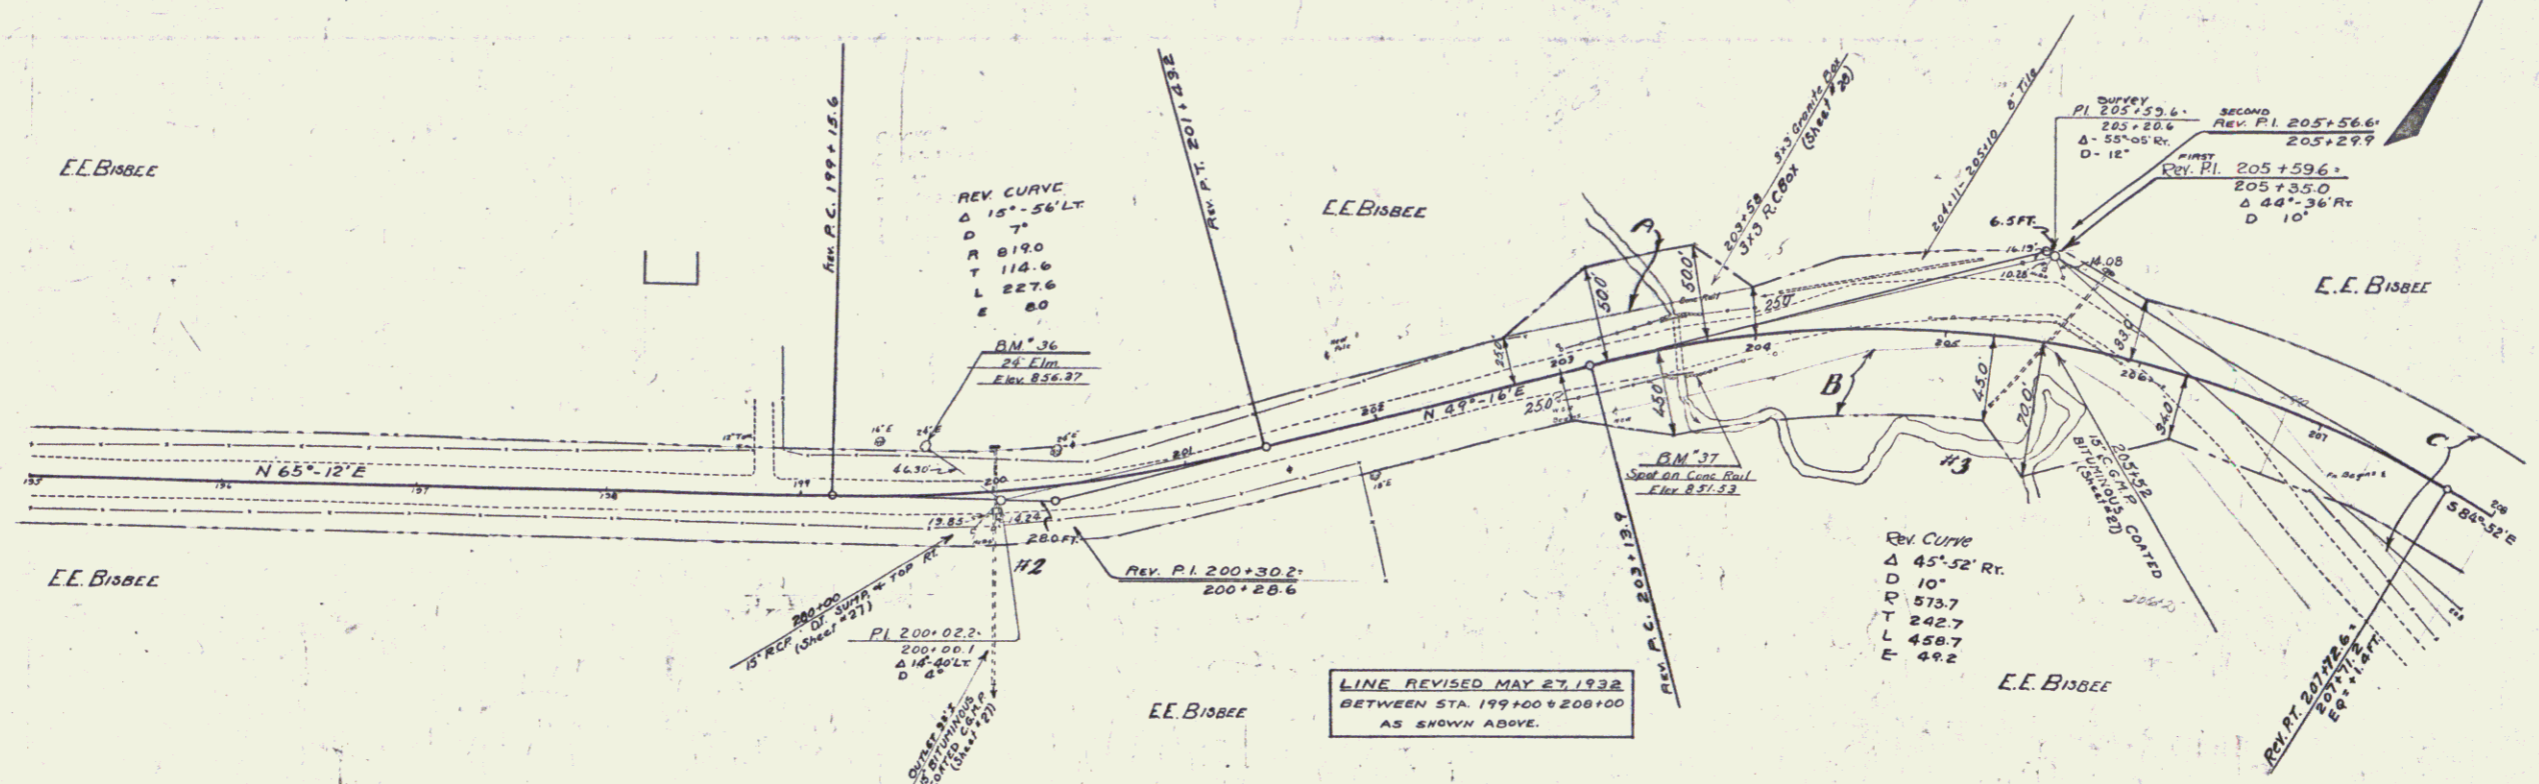

LINE REVISED MAY 27, 1932
BETWEEN STA. 199+00 & 206+00
AS SHOWN ABOVE.

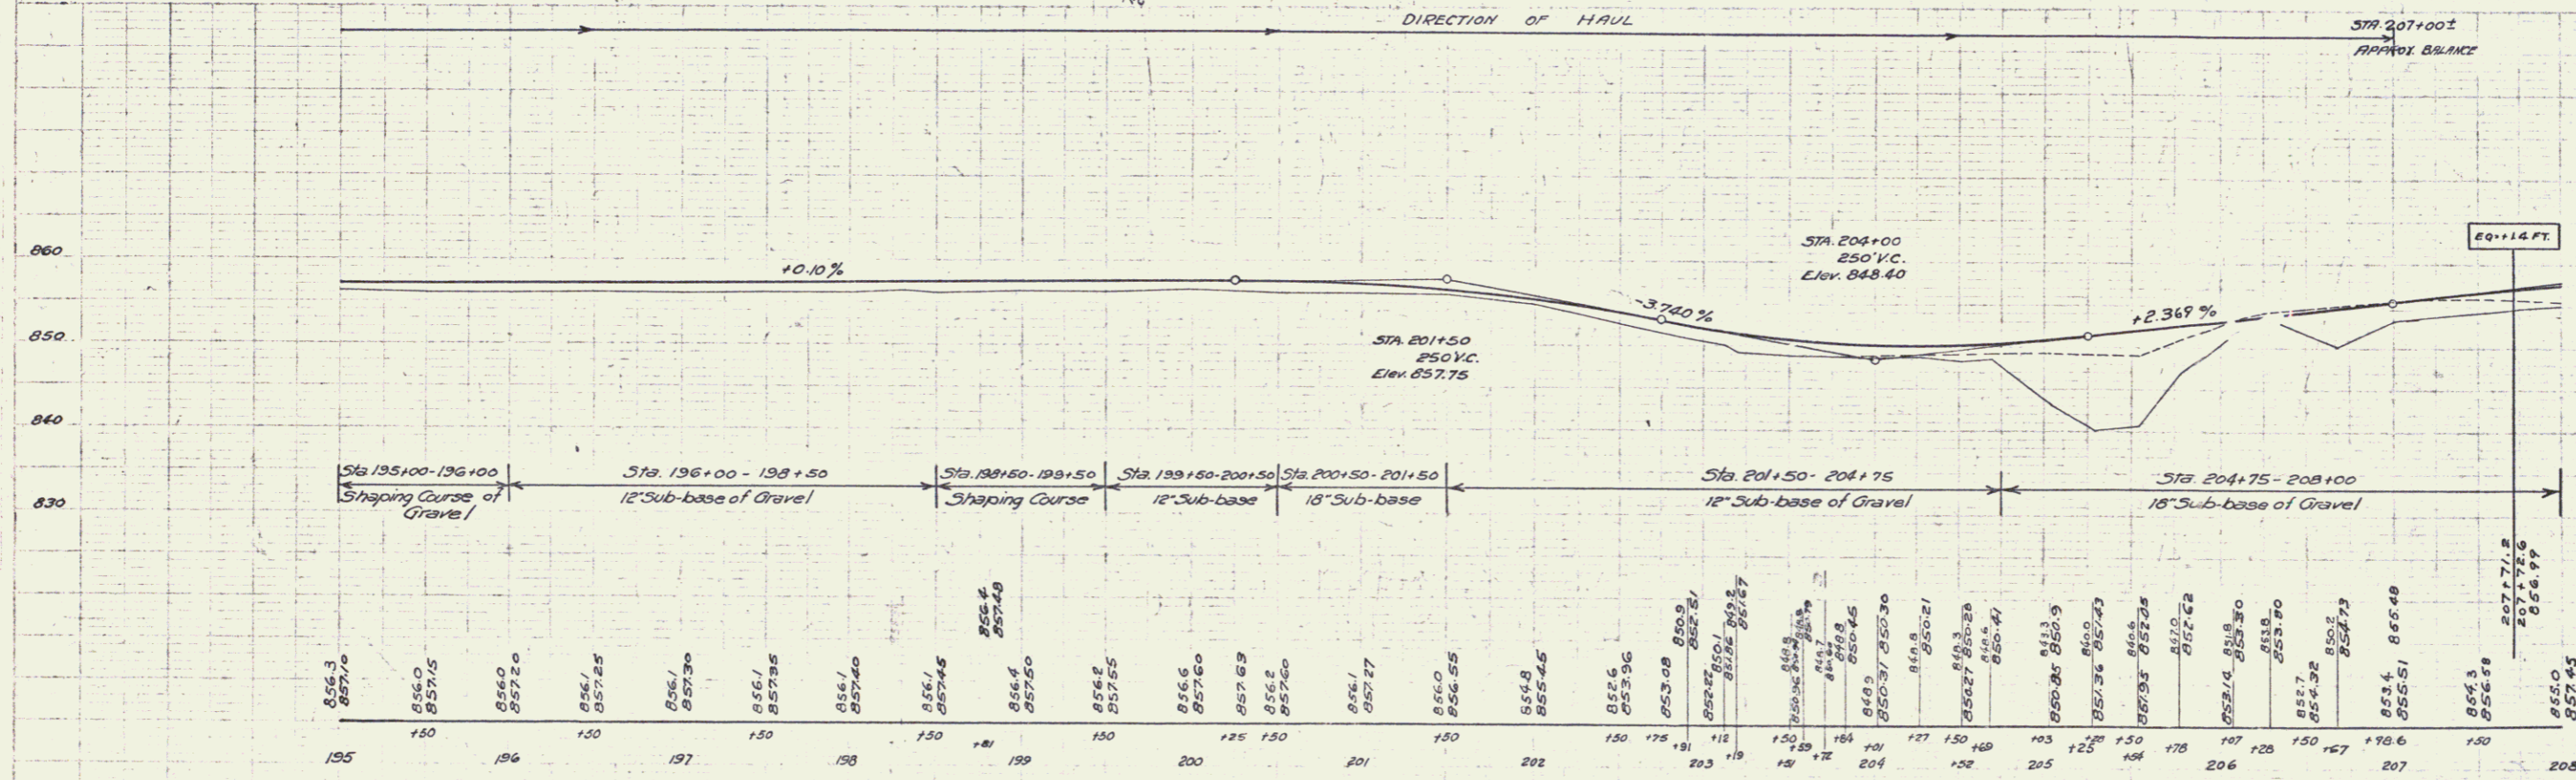

B.M. # 36 SPIKE IN ROOT OF 24' ELM, 18' LT. OF STA. 199+65 - ELEV. 856.37
B.M. # 37 PAINT SPOT ON CONC. BRIDGE RAIL, 13' RT. OF STA. 203+67 - ELEV. 851.53

SERIES F NO 131
Sheet 18 of 68

16