
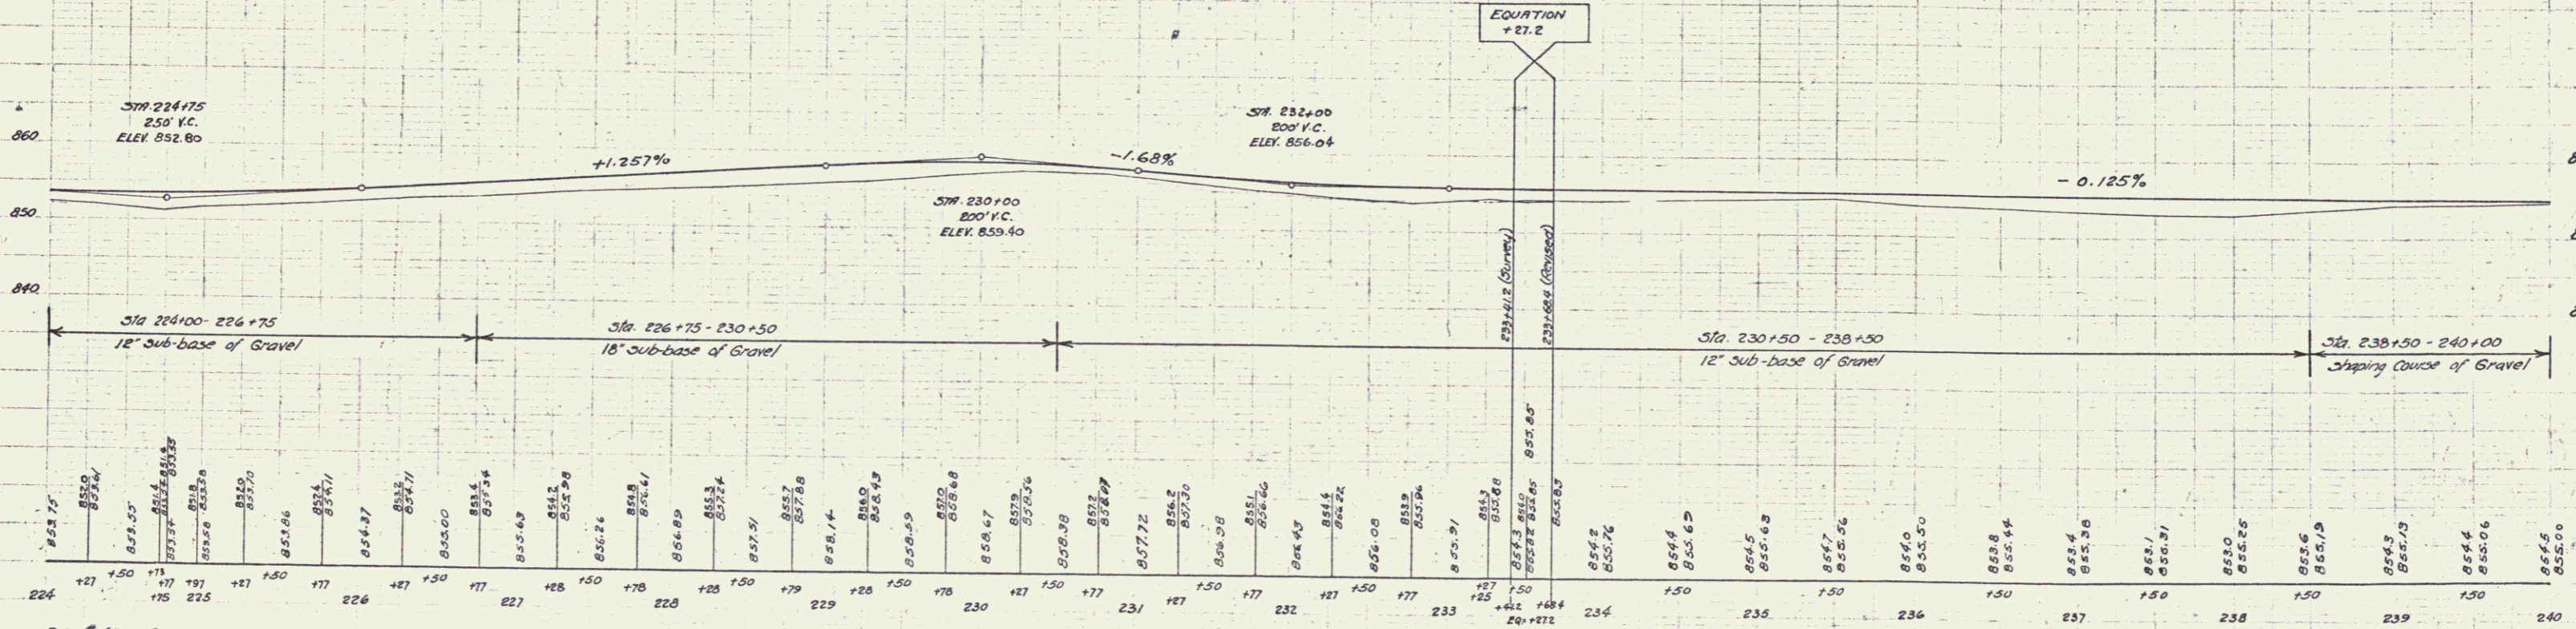


Parcel	Kind of Instrument	Date of Grant	Grantee	Recorded	Remarks
60/141-182	O.C.D.	8-10-32	Edward F. Nadeau	Sta. 100-101	N-10-32 C-11-51-33-34-35

131-C 1932 20 68

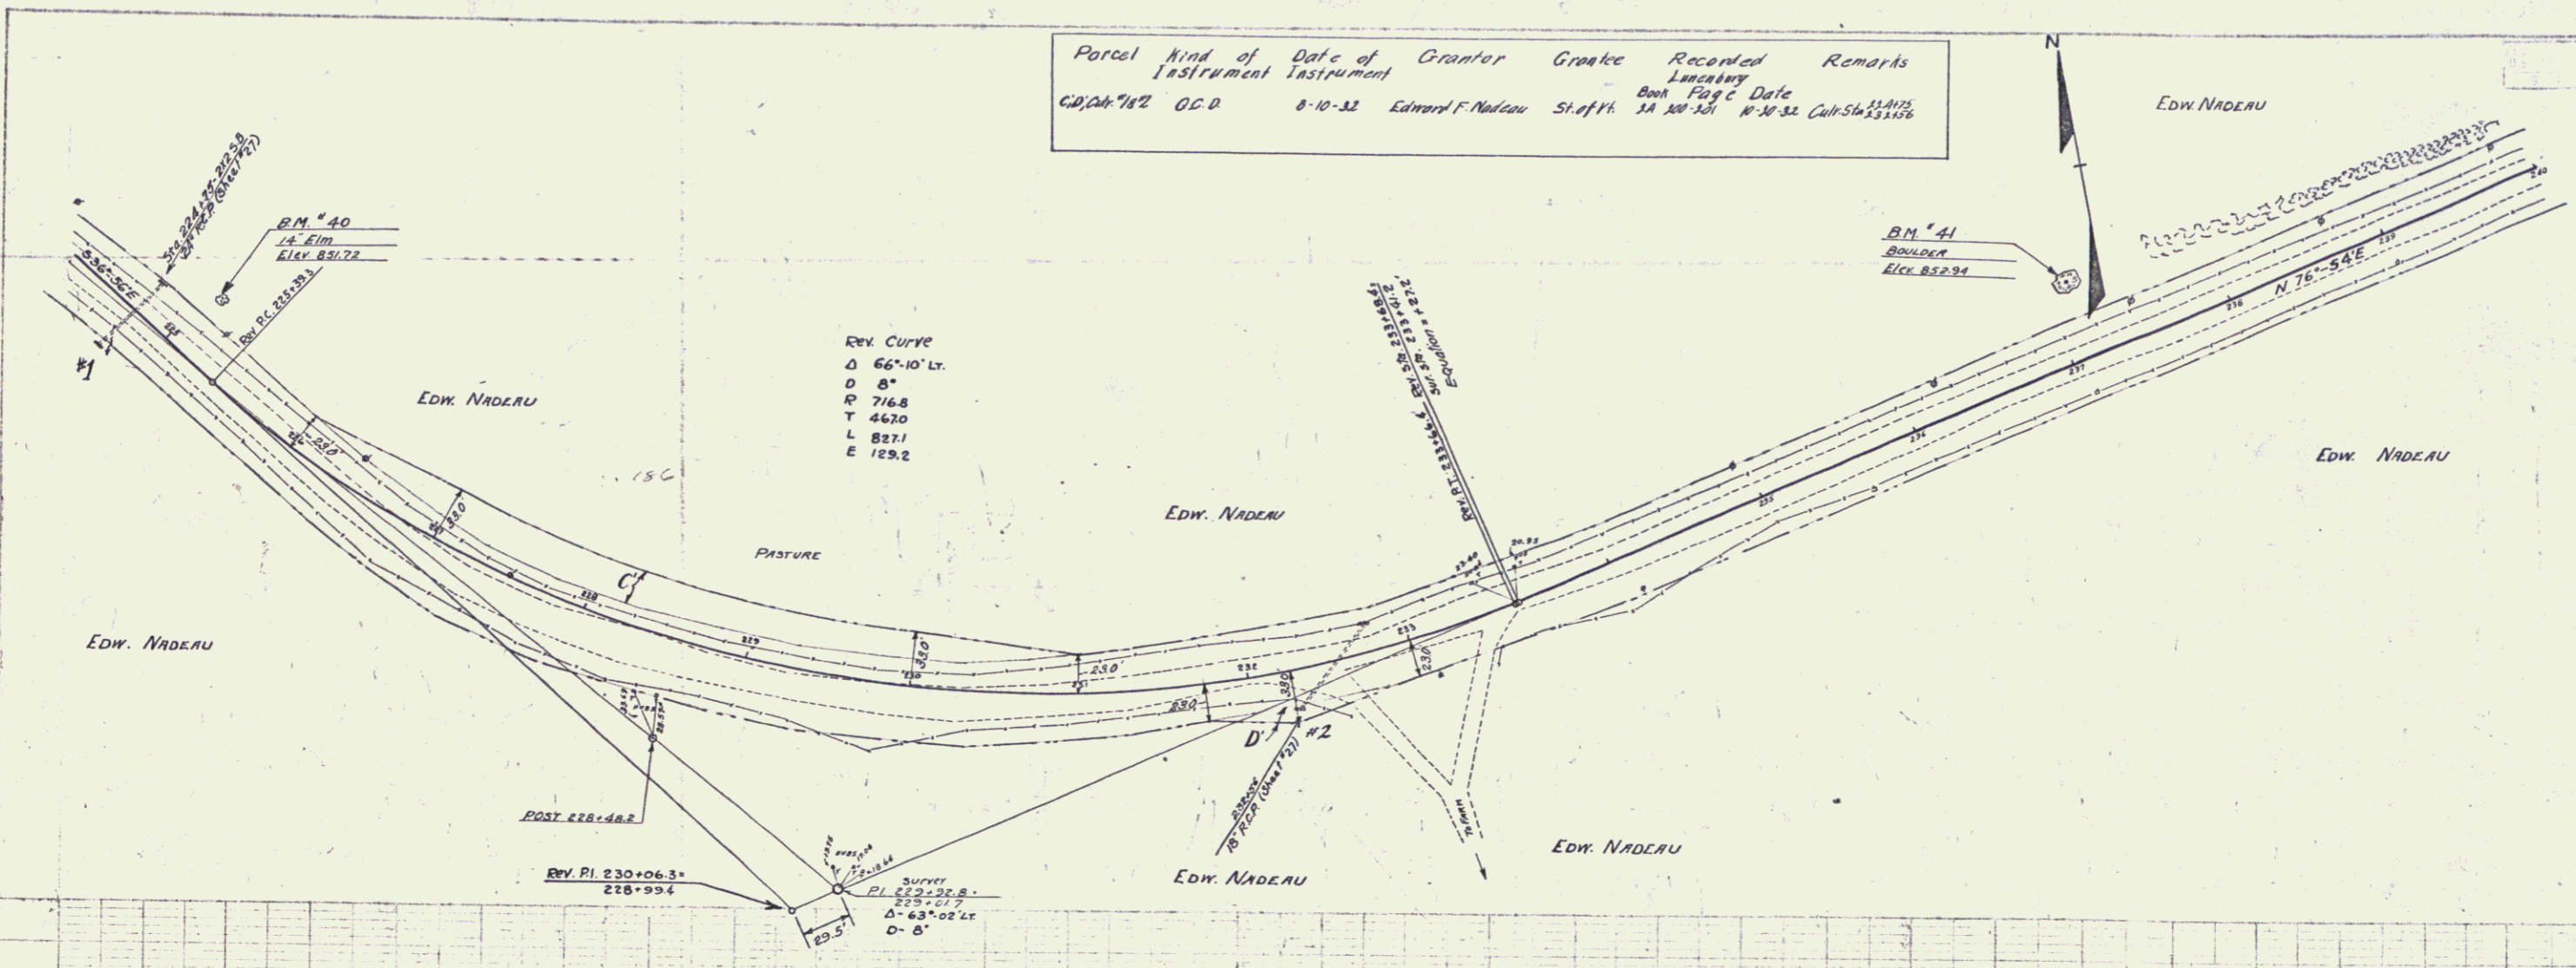

B.M. # 40 SPIKE IN ROOT OF 14" LIM, 38' LT. OF STA. 225+10 - ELEV. 851.78
 B.M. # 41 PRINT SPOT ON BOULDER (N.W. Woods) 41' LT. OF STA. 237+13 - ELEV. 852.94

SERIES F NO 131-C
 Sheet 20 of 68

18