
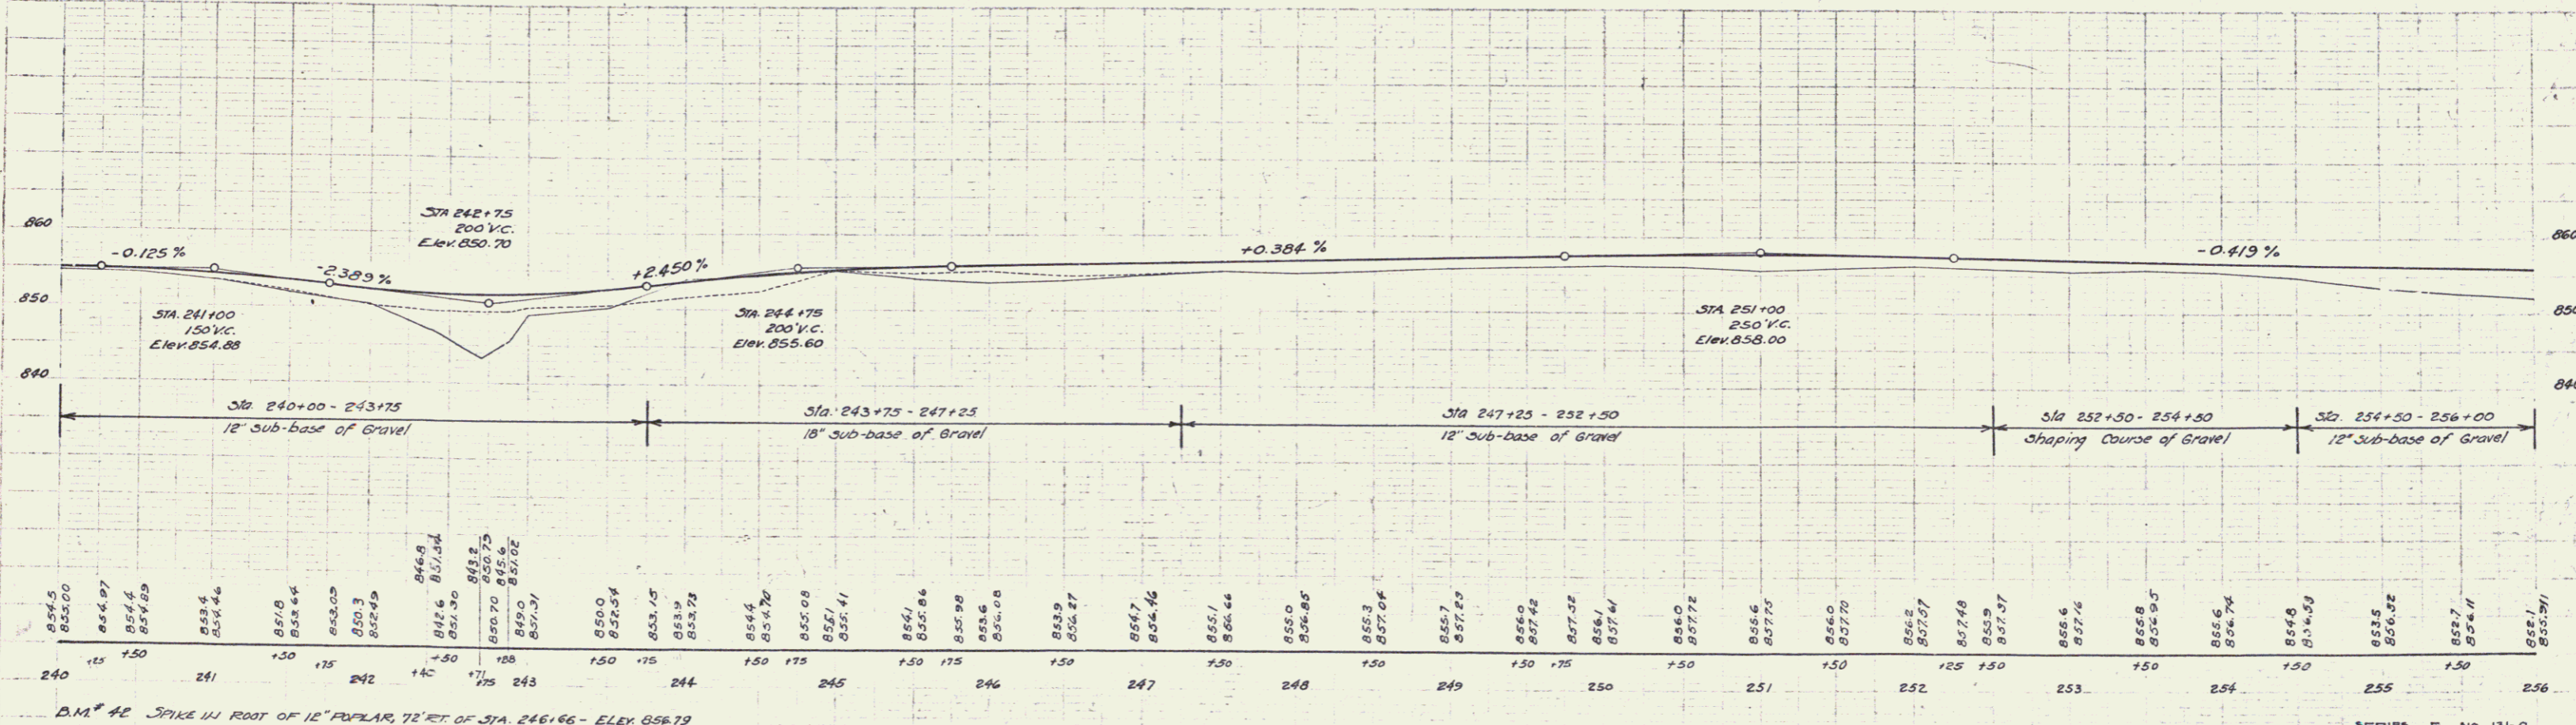


Parcel	Kind of Instrument	Date of Instrument	Grantor	Grantee	Recorded	Remarks
E'	O.S.D.	8-10-32	Edmond F. Nadeau	St. of H.	LA 200-201	10-10-33

131-C 1932 21 68

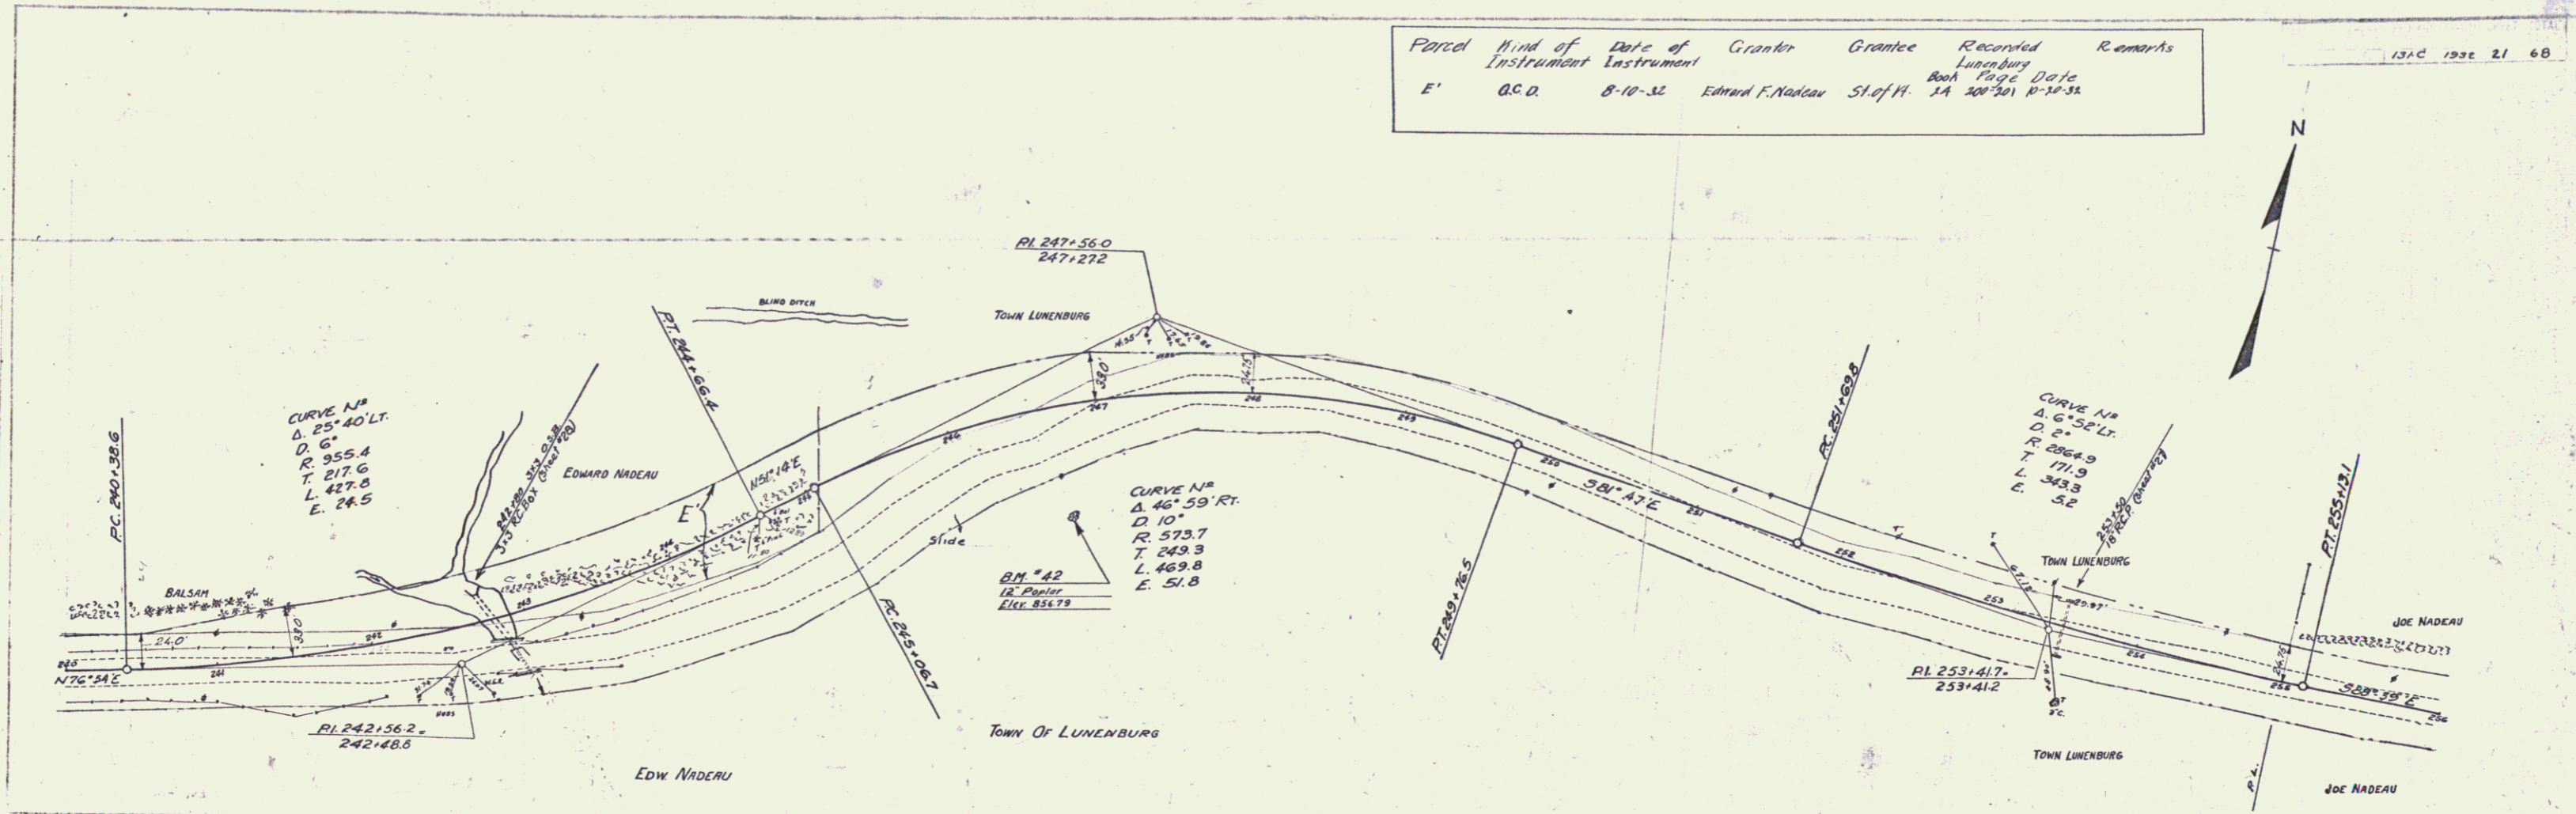

D.M. # 42 SPIKE IN ROOT OF 12" POPLAR, 72' RT. OF STA. 246+86 - ELEV. 856.79

17