



PLAN
 DRAWN BY: SPANGLING, PELLECCHINI
 CHECKED BY: PELLECCHINI
 DATE: 11/15/07
 PROJECT: B.P. 028-4-6671

PROFILE
 DRAWN BY: SPANGLING, PELLECCHINI
 CHECKED BY: PELLECCHINI
 DATE: 11/15/07
 PROJECT: B.P. 028-4-6671

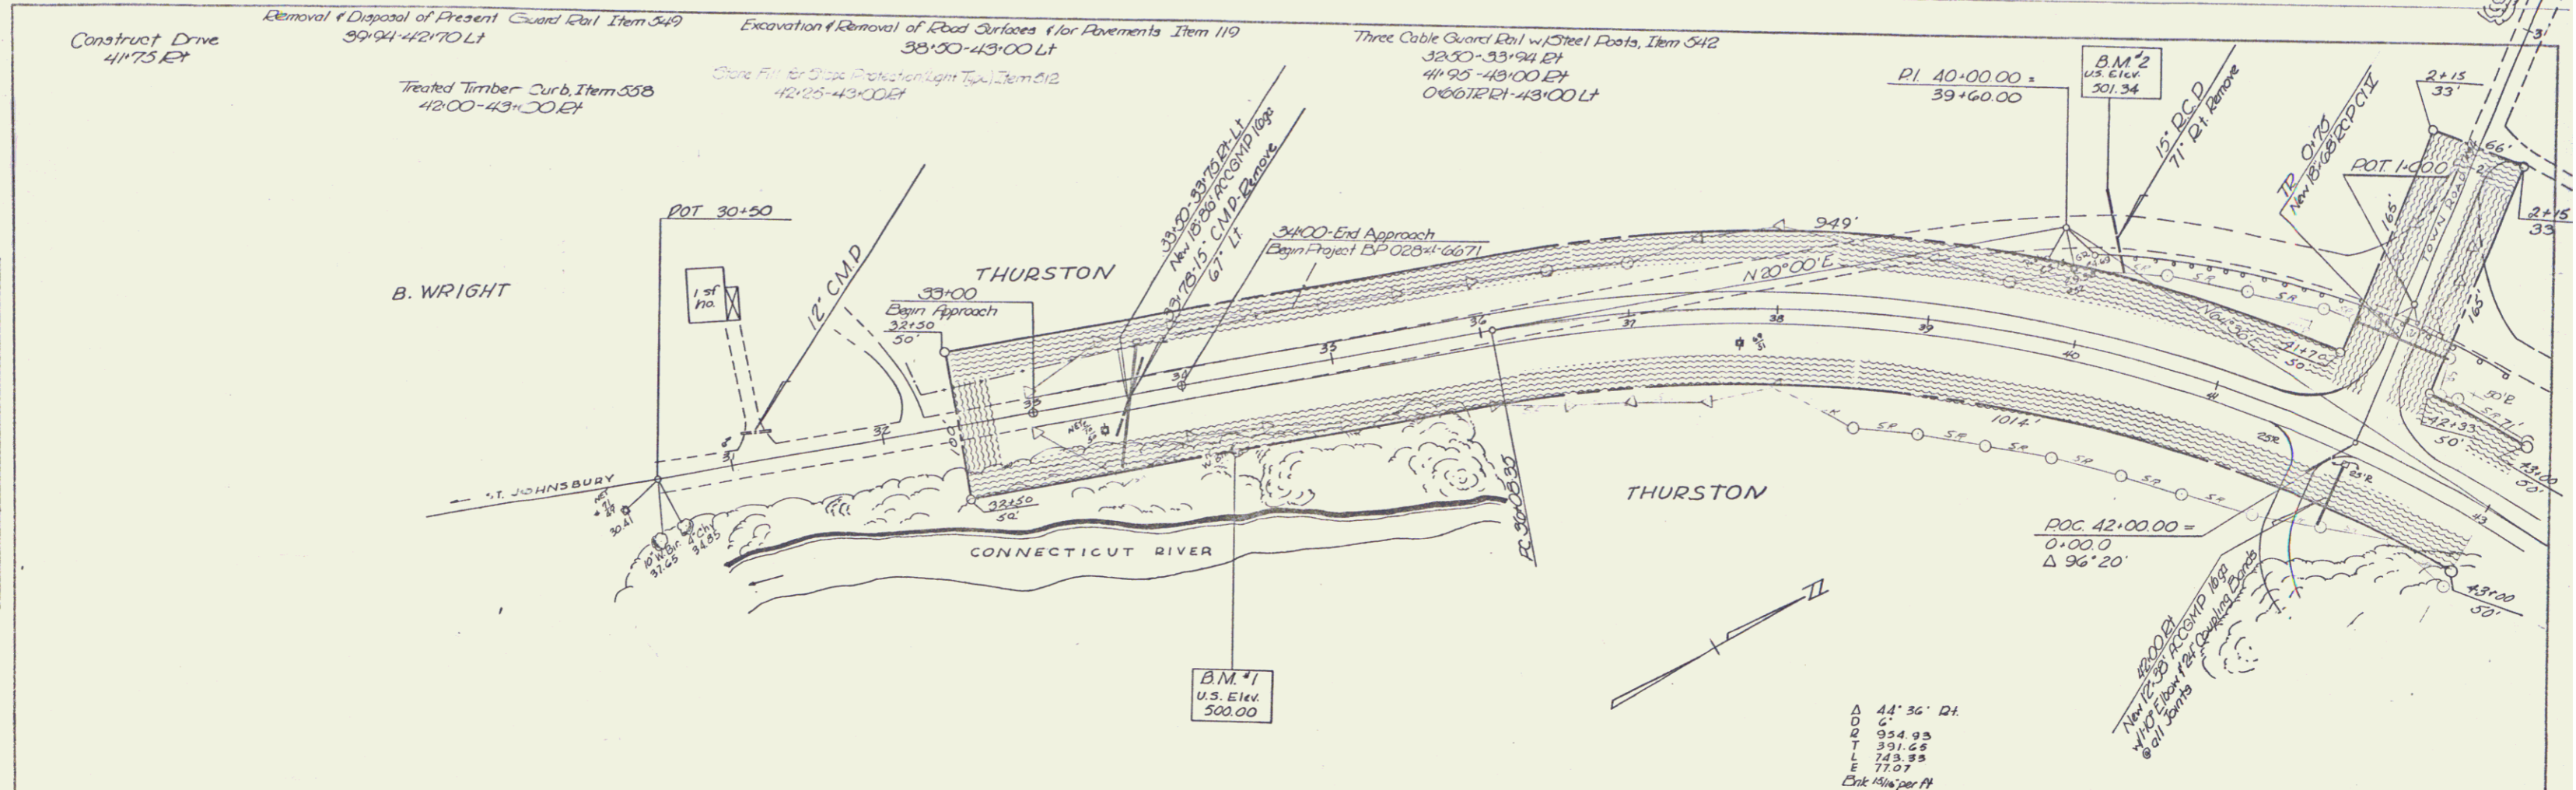

Δ 44' 36" Rt.
 D 6'
 Q 954.95
 T 391.68
 L 143.35
 E 77.07
 Exit Marker #1

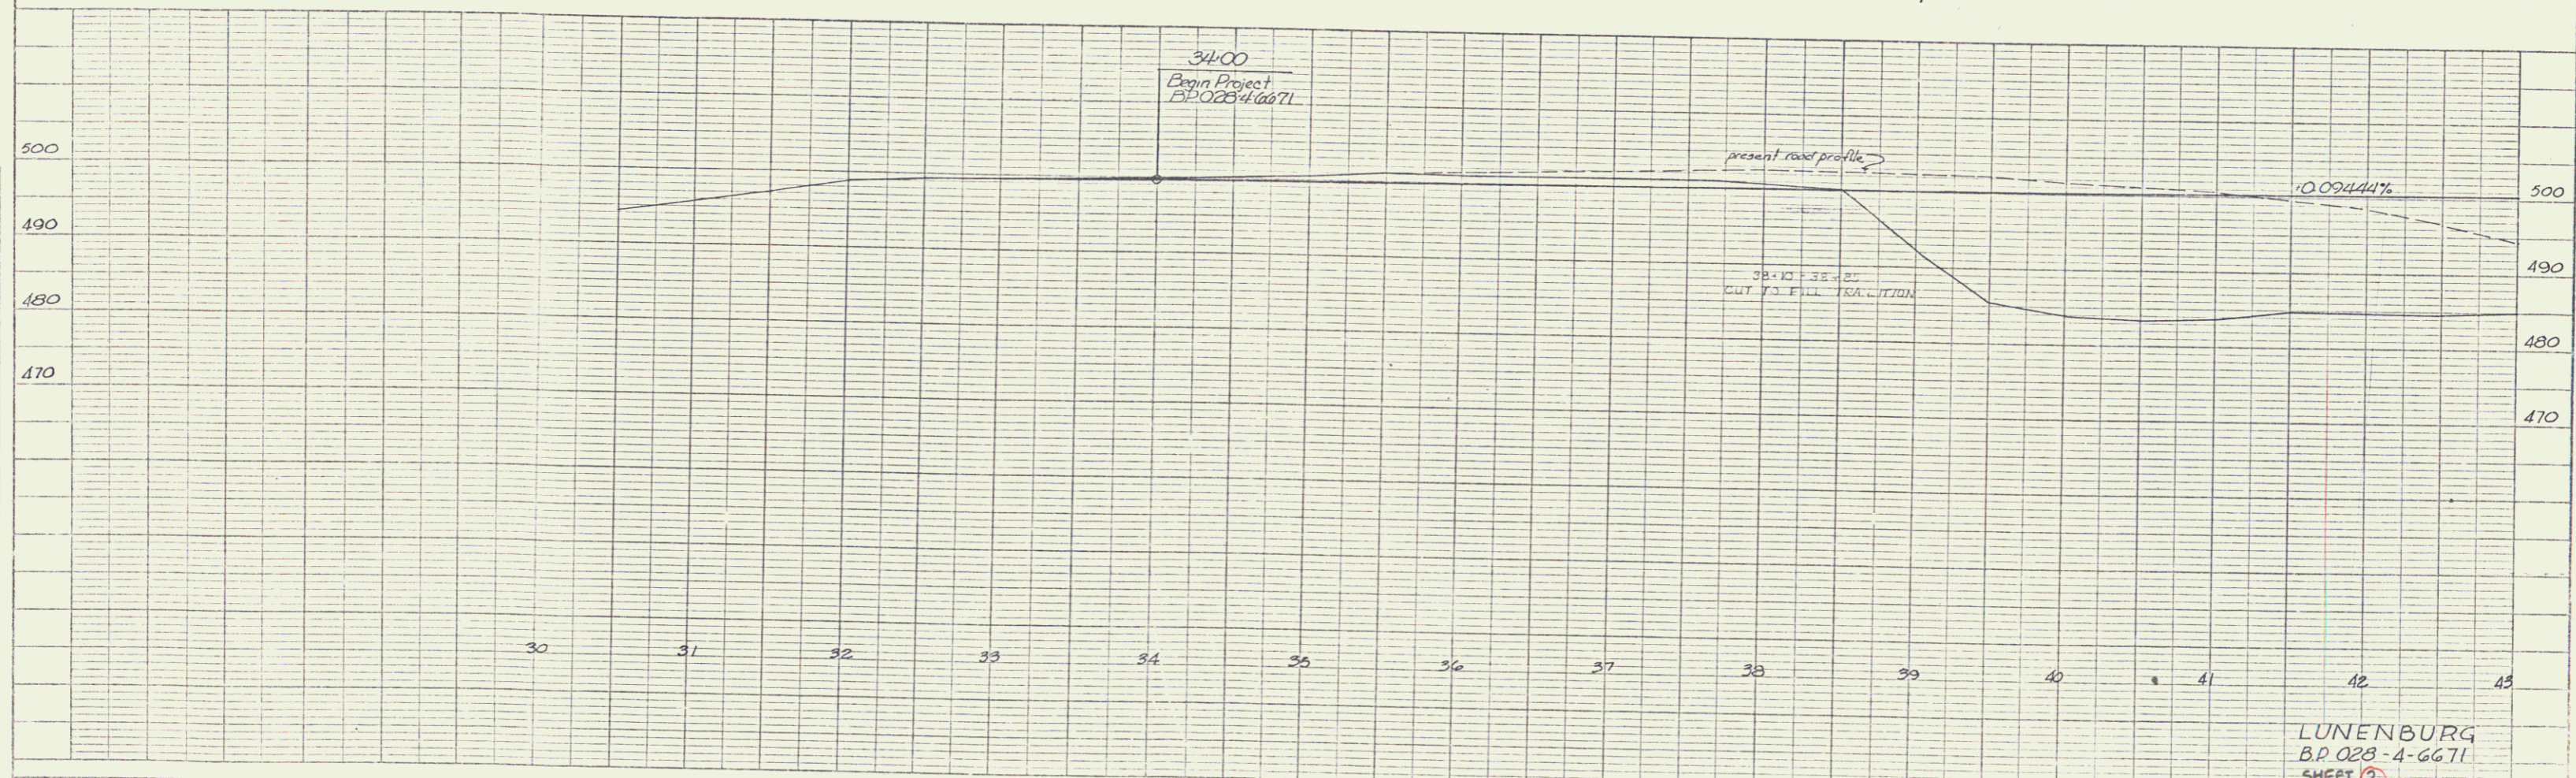

LUNENBURG
 B.P. 028-4-6671
 SHEET 2

2