

INDEX OF SHEETS


SHEET NO.	TITLE PAGE
No. 1	TYPICAL CROSS-SECTION OF IMPROVEMENT 3:1 AND 5:1
No. 2	PLAN AND PROFILE STA. 0+00 TO STA 13+00
" 3	" " " 13+00 " " 28+00
" 4	" " " 28+00 " " 43+00
" 5	" " " 43+00 " " 58+00
" 6	" " " 58+00 " " 73+00
" 7	" " " 73+00 " " 88+00
" 8	" " " 88+00 " " 99+13.7
" 11	ABUTMENT PLAN
" 12	SUPERSTRUCTURE
" 13 TO 23	CROSS SECTIONS

STATE OF VERMONT  
STATE HIGHWAY DEPARTMENT


PLAN AND PROFILE OF PROPOSED  
STATE HIGHWAY  
FEDERAL AID PROJECT

TOWN OF RUTLAND AND WEST RUTLAND  
GATEWAY ROAD  
FROM RUTLAND CITY LINE TO END OF PAVEMENT  
IN WEST RUTLAND.

SCALES  
PLAN - 1 IN. = 50 FT.  
PROFILE - HORIZONTAL 1 IN. = 50 FT. VERT. 1 IN. = 10 FT.  
CROSS SECTIONS - 1 IN. = 5 FT.

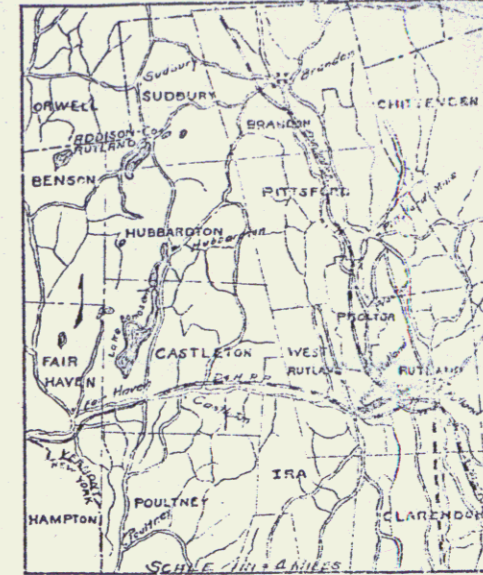

TO BE RETURNED TO B.O.P. DIVISION  
TOWN OF  
RUTLAND  
Vermont  
FILE NO. 111  
HIGHWAY A.V.A.-R.C.-ENGRS

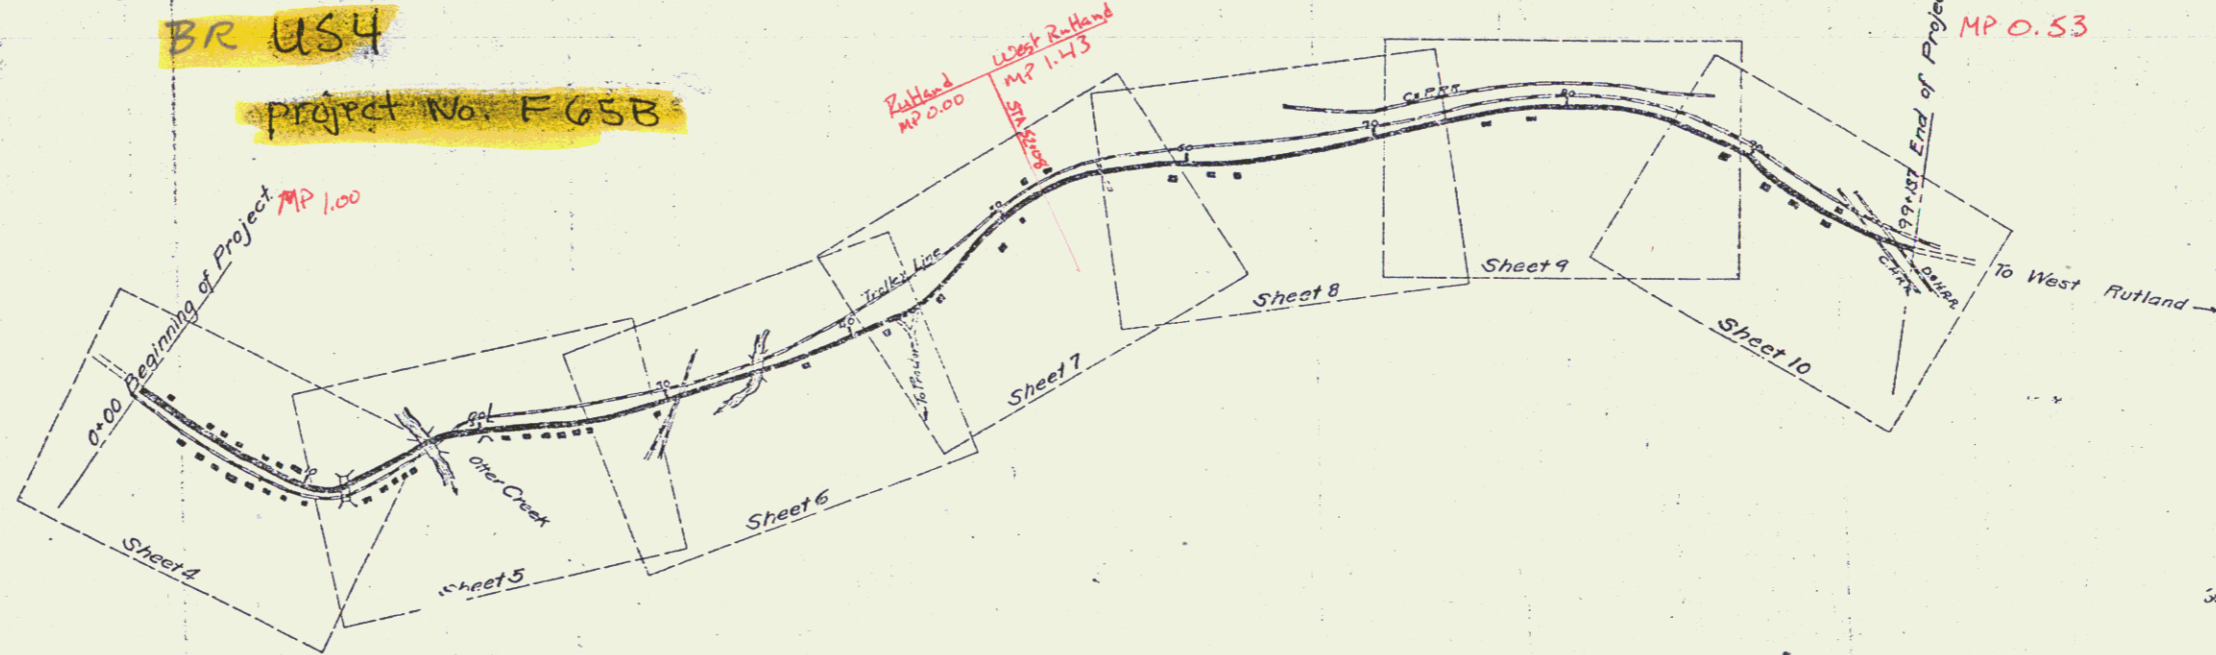

CONVENTIONAL SIGNS

- COUNTY LINE
- TOWN LINE
- FENCE LINE
- STONE WALL
- UNFENCED PROPERTY
- GUARD RAIL
- TRAVELED WAY
- RAILROAD
- RETAINING WALL
- CENTER LINE
- SURVEY LINE
- CULVERT
- DROP INLET
- TROLLEY POLE
- POWER POLE
- TELEPHONE POLE
- TREES
- FENCE

- GROUND ELEVATION
- GRADE ELEVATION
- CURVE DATA
- DEFLECTION ANGLE Δ
- DEGREE OF CURVE D.
- RADIUS OF CURVE R.
- TANGENT DISTANCE T.
- LENGTH OF CURVE L.
- EXTERNAL DISTANCE E.
- POINT OF INTERSECTION P.I.
- POINT OF CURVE P.C.
- POINT OF TANGENT P.T.

LAYOUT  
SCALE 1 IN. = 500 FT.



SUBMITTED BY ORDER OF THE STATE HIGHWAY DEPARTMENT  
CHIEF ENGINEER  
DEPARTMENT OF HIGHWAYS

8/1/23  
RECOMMENDED FOR APPROVAL  
DISTRICT ENGINEER  
BUREAU OF PUBLIC ROADS  
RECOMMENDED FOR APPROVAL  
CHIEF ENGINEER  
DEPARTMENT OF PUBLIC ROADS  
APPROVED  
DIRECTOR - BUREAU OF PUBLIC ROADS

SERIES # No. 6528 FILED  
SHEET 1 OF 23

US 4